

COGCC GIS Online

Hydrology map

Red Lines

- Oil and Gas Wells
- Temporary Point


Well Status

- Location
- Producing
- Shut In
- Temp Aban
- Injecting
- Plugged
- Dry & Aban
- Domestic
- Gas Storage
- Waiting On
- Location
- Aban Loc
- Unknown
- Verbal Plugging

CITIES TOWNS PLACES

- Towns and Places

ROADS AND RAILS

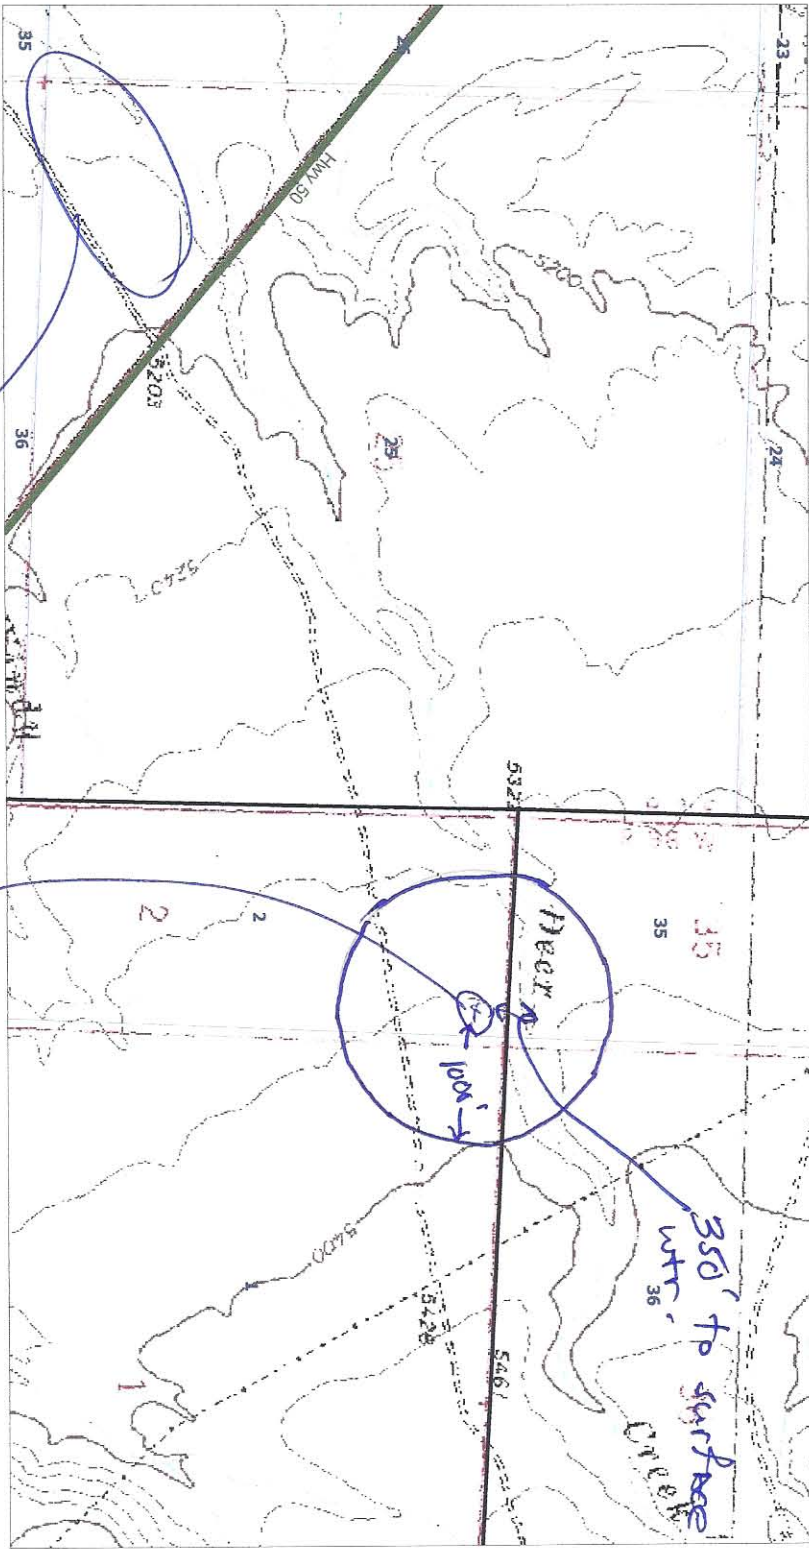

Area of
nearest water
wells

Approx. well location

