


R. 97 W.

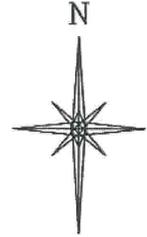

SCALE 1" = 1000'

T. 6 S.

SHL

LATITUDE (NAD 83)

NORTH 39.529613 DEG.

LONGITUDE (NAD 83)

WEST 108.212966 DEG.

NORTHING (NAD 27)

629205.53

EASTING (NAD 27)


1235039.81

**BASIS OF BEARING/DATUM**  
SPCS CO CENTRAL NAD 27  
BASED ON NGS TRIANGULATION  
STATION "SHALE"

THE BASIS OF BEARINGS FOR  
THIS SURVEY IS THE NORTH  
LINE OF THE NW 1/4 OF  
SECTION 15, MONUMENTED BY  
GLO BC'S AND BEARING  
N 88° 13' 57" W.

**LEGEND**

- ◆ WELL LOCATION
- └ DENOTES 90° TIE
- FOUND MONUMENT

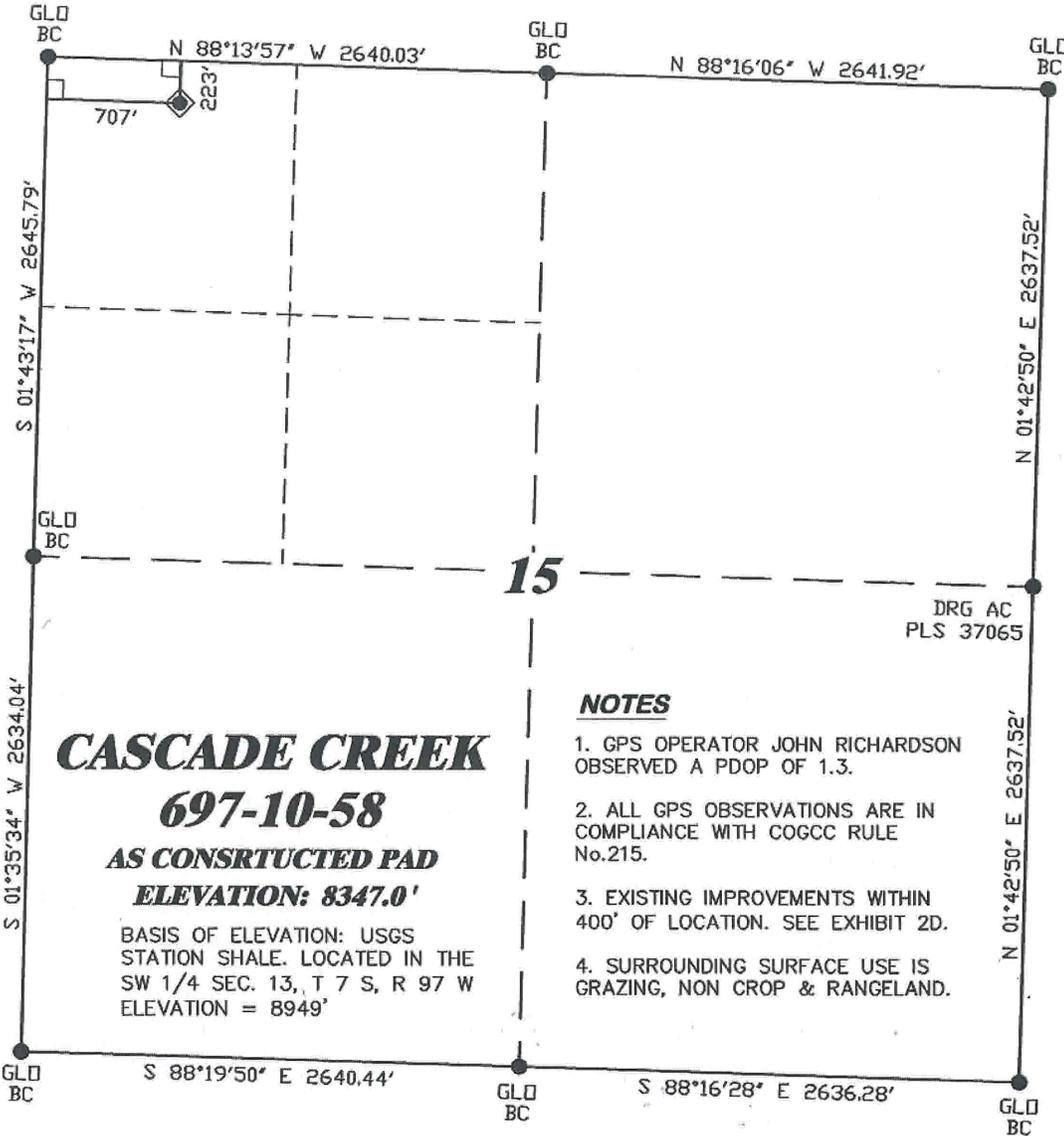

**NOTES**

1. GPS OPERATOR JOHN RICHARDSON OBSERVED A PDOP OF 1.3.
2. ALL GPS OBSERVATIONS ARE IN COMPLIANCE WITH COGCC RULE No.215.
3. EXISTING IMPROVEMENTS WITHIN 400' OF LOCATION. SEE EXHIBIT 2D.
4. SURROUNDING SURFACE USE IS GRAZING, NON CROP & RANGELAND.

**CASCADE CREEK**

**697-10-58**

**AS CONSTRUCTED PAD**

**ELEVATION: 8347.0'**

BASIS OF ELEVATION: USGS  
STATION SHALE. LOCATED IN THE  
SW 1/4 SEC. 13, T 7 S, R 97 W  
ELEVATION = 8949'



**SURVEYOR'S STATEMENT**

I, RONALD C. RENNKE, AN EMPLOYEE AND AGENT ON BEHALF OF D.R. GRIFFIN & ASSOCIATES, INC. STATE THE PLAT HEREON IS A CORRECT REPRESENTATION OF A SURVEY MADE UNDER MY SUPERVISION ON DECEMBER 23, 2009 OF THE SHOWN CASCADE CREEK 697-10-58 AS STAKED ON THE GROUND

Notice: In accordance with Colorado State Law, any legal action based upon any defect in this survey plat must commence within three (3) years after first discovery of such defect. In no event, may any action based upon any defect in this survey plat be commenced more than ten (10) years from the date of certification shown hereon.

697-15-01 PAD




COLORADO PLS. No. 37065

**DRG** RIFFIN & ASSOCIATES, INC.  
 (307) 382-5028 1414 ELK ST., ROCK SPRINGS, WY 82901

**PLAT OF DRILLING LOCATION FOR  
 OXY USA WTP LP  
 SHL IN NWNW SECTION 15,  
 223' F/NL & 707' F/WL, SECTION 15,  
 T. 6 S., R. 97 W., 6th P.M.  
 GARFIELD COUNTY, COLORADO**

DRAWN: 2/16/2010 - DEH	SCALE: 1" = 1000'
REVISED: N/A	DRG JOB No. 10845
	EXHIBIT 1

**R. 97 W.**

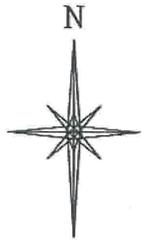

SCALE 1" = 1000'

**T. 6 S.**

**BHL**


**LATITUDE (NAD 83)**  
NORTH 39.531185 DEG.  
**LONGITUDE (NAD 83)**  
WEST 108.210827 DEG.  
**NORTHING (NAD 27)**  
629760  
**EASTING (NAD 27)**  
1235660

**BASIS OF BEARING/DATUM**  
SPCS CO CENTRAL NAD 27  
BASED ON NGS TRIANGULATION  
STATION "SHALE"

THE BASIS OF BEARINGS FOR  
THIS SURVEY IS THE NORTH  
LINE OF THE NW 1/4 OF  
SECTION 15, MONUMENTED BY  
GLO BC'S AND BEARING  
N 88° 13' 57" W.

**LEGEND**

- APPROXIMATE BHL
- DENOTES 90° TIE
- FOUND MONUMENT

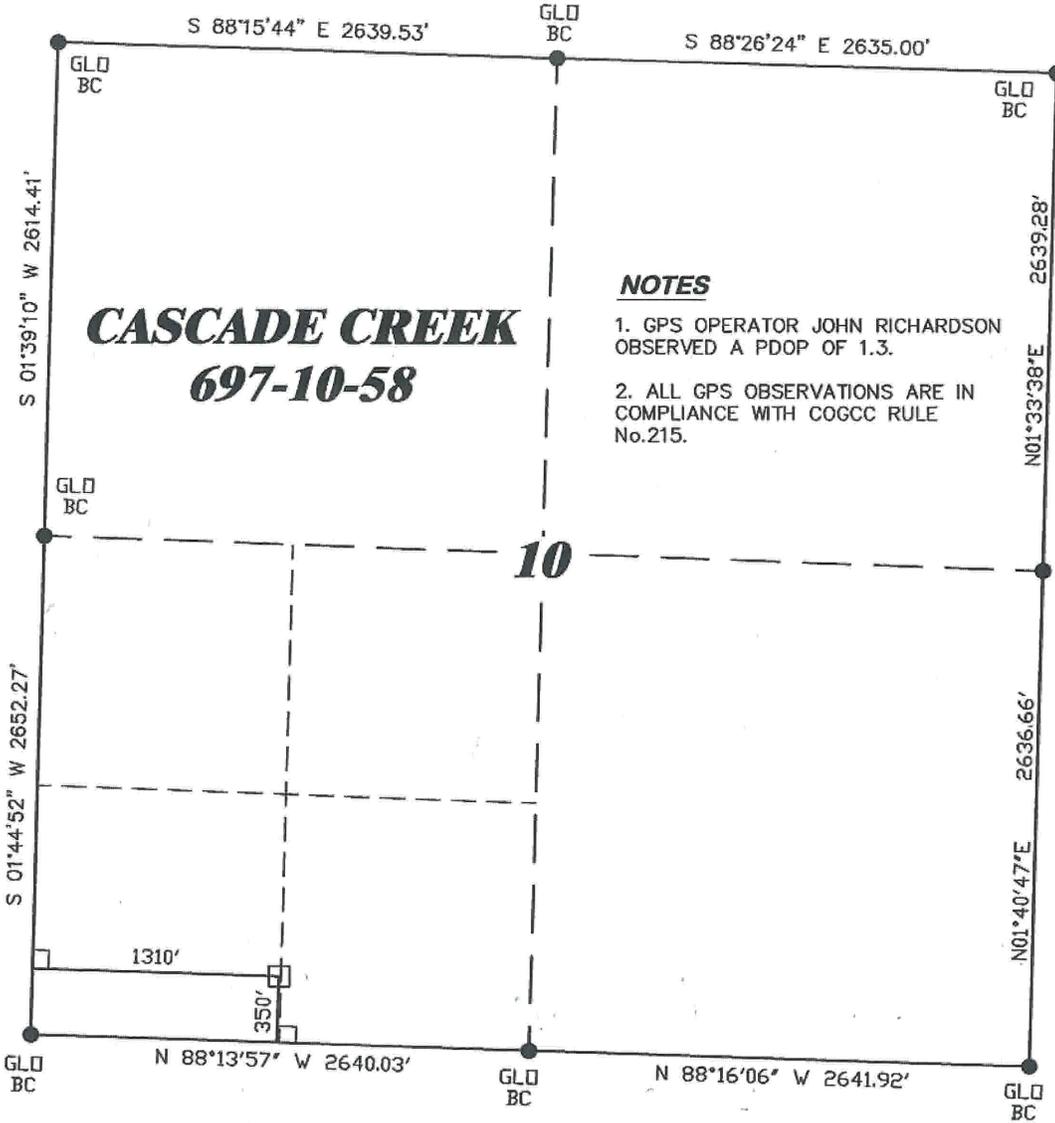

**NOTES**

1. GPS OPERATOR JOHN RICHARDSON OBSERVED A PDOF OF 1.3.
2. ALL GPS OBSERVATIONS ARE IN COMPLIANCE WITH COGCC RULE No.215.

**CASCADE CREEK  
697-10-58**




**SURVEYOR'S STATEMENT**

I, RONALD C. RENNKE, AN EMPLOYEE AND AGENT ON BEHALF OF D.R. GRIFFIN & ASSOCIATES, INC. STATE THE PLAT HEREON IS A CORRECT REPRESENTATION OF A SURVEY MADE UNDER MY SUPERVISION ON DECEMBER 23, 2009 OF THE SHOWN CASCADE CREEK 697-10-58 BOTTOM HOLE LOCATION

Notice: In accordance with Colorado State Law, any legal action based upon any defect in this survey plat must commence within three (3) years after first discovery of such defect. In no event, may any action based upon any defect in this survey plat be commenced more than ten (10) years from the date of certification shown hereon.

697-15-01 PAD

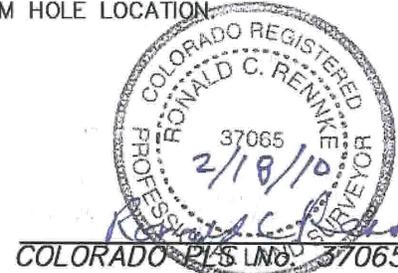

COLORADO PLS LNO. 37065

**DRG** GRIFFIN & ASSOCIATES, INC.  
(307) 362-5028 1414 ELK ST., ROCK SPRINGS, WY 82901

DRAWN: 2/16/2010 - DEH	SCALE: 1" = 1000'
REVISED: N/A	DRG JOB No. 10845
EXHIBIT 1	

**PLAT OF BOTTOM HOLE LOCATION FOR  
OXY USA WTP LP  
SHL IN NWNW SECTION 15  
BHL 350' F/SL & 1310' F/WL, SECTION 10,  
T. 6 S., R. 97 W., 6th P.M.  
GARFIELD COUNTY, COLORADO**