


Castle Springs Federal Pad T As-Built - Exhibit Map

Portions of NW/4 Sec 8
T7S, R91W, 6th P.M.,
Garfield County, Colorado

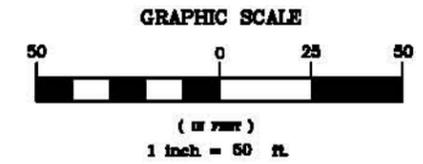

LEGEND


- Buried Gas Flowlines
- Buried Oil Flowlines
- Buried Water Flowlines
- Buried Control Cable
- Well Location
- Control Panel
- Deadman

Notes

1. This is not a Land Survey Plat or an Improvement Survey Plat. The purpose of this Exhibit Map is to show the As-Built conditions and As-Drilled well locations.
2. All horizontal measurements are based on the North American Datum of 1927 (NAD27).
3. All vertical measurements are based on the North American Vertical Datum of 1929 (NAVD29)
4. All sub-surface locations are based on surface and parole evidence and are approximate only. Verify locations prior to penetrating surface.

Pad T As-Drilled Well Surface Locations (NAD27)

Description	Latitude	Longitude
Well 12-08-07-91	39.46398°	107.58215°
Well 22-08-07-91	39.46407°	107.58254°
Well 21-08-07-91	39.46407°	107.58262°
Well 11-08-07-91	39.46408°	107.58269°
Well 41-07-07-91	39.46408°	107.58276°
Well 42-07-07-91	39.46408°	107.58283°

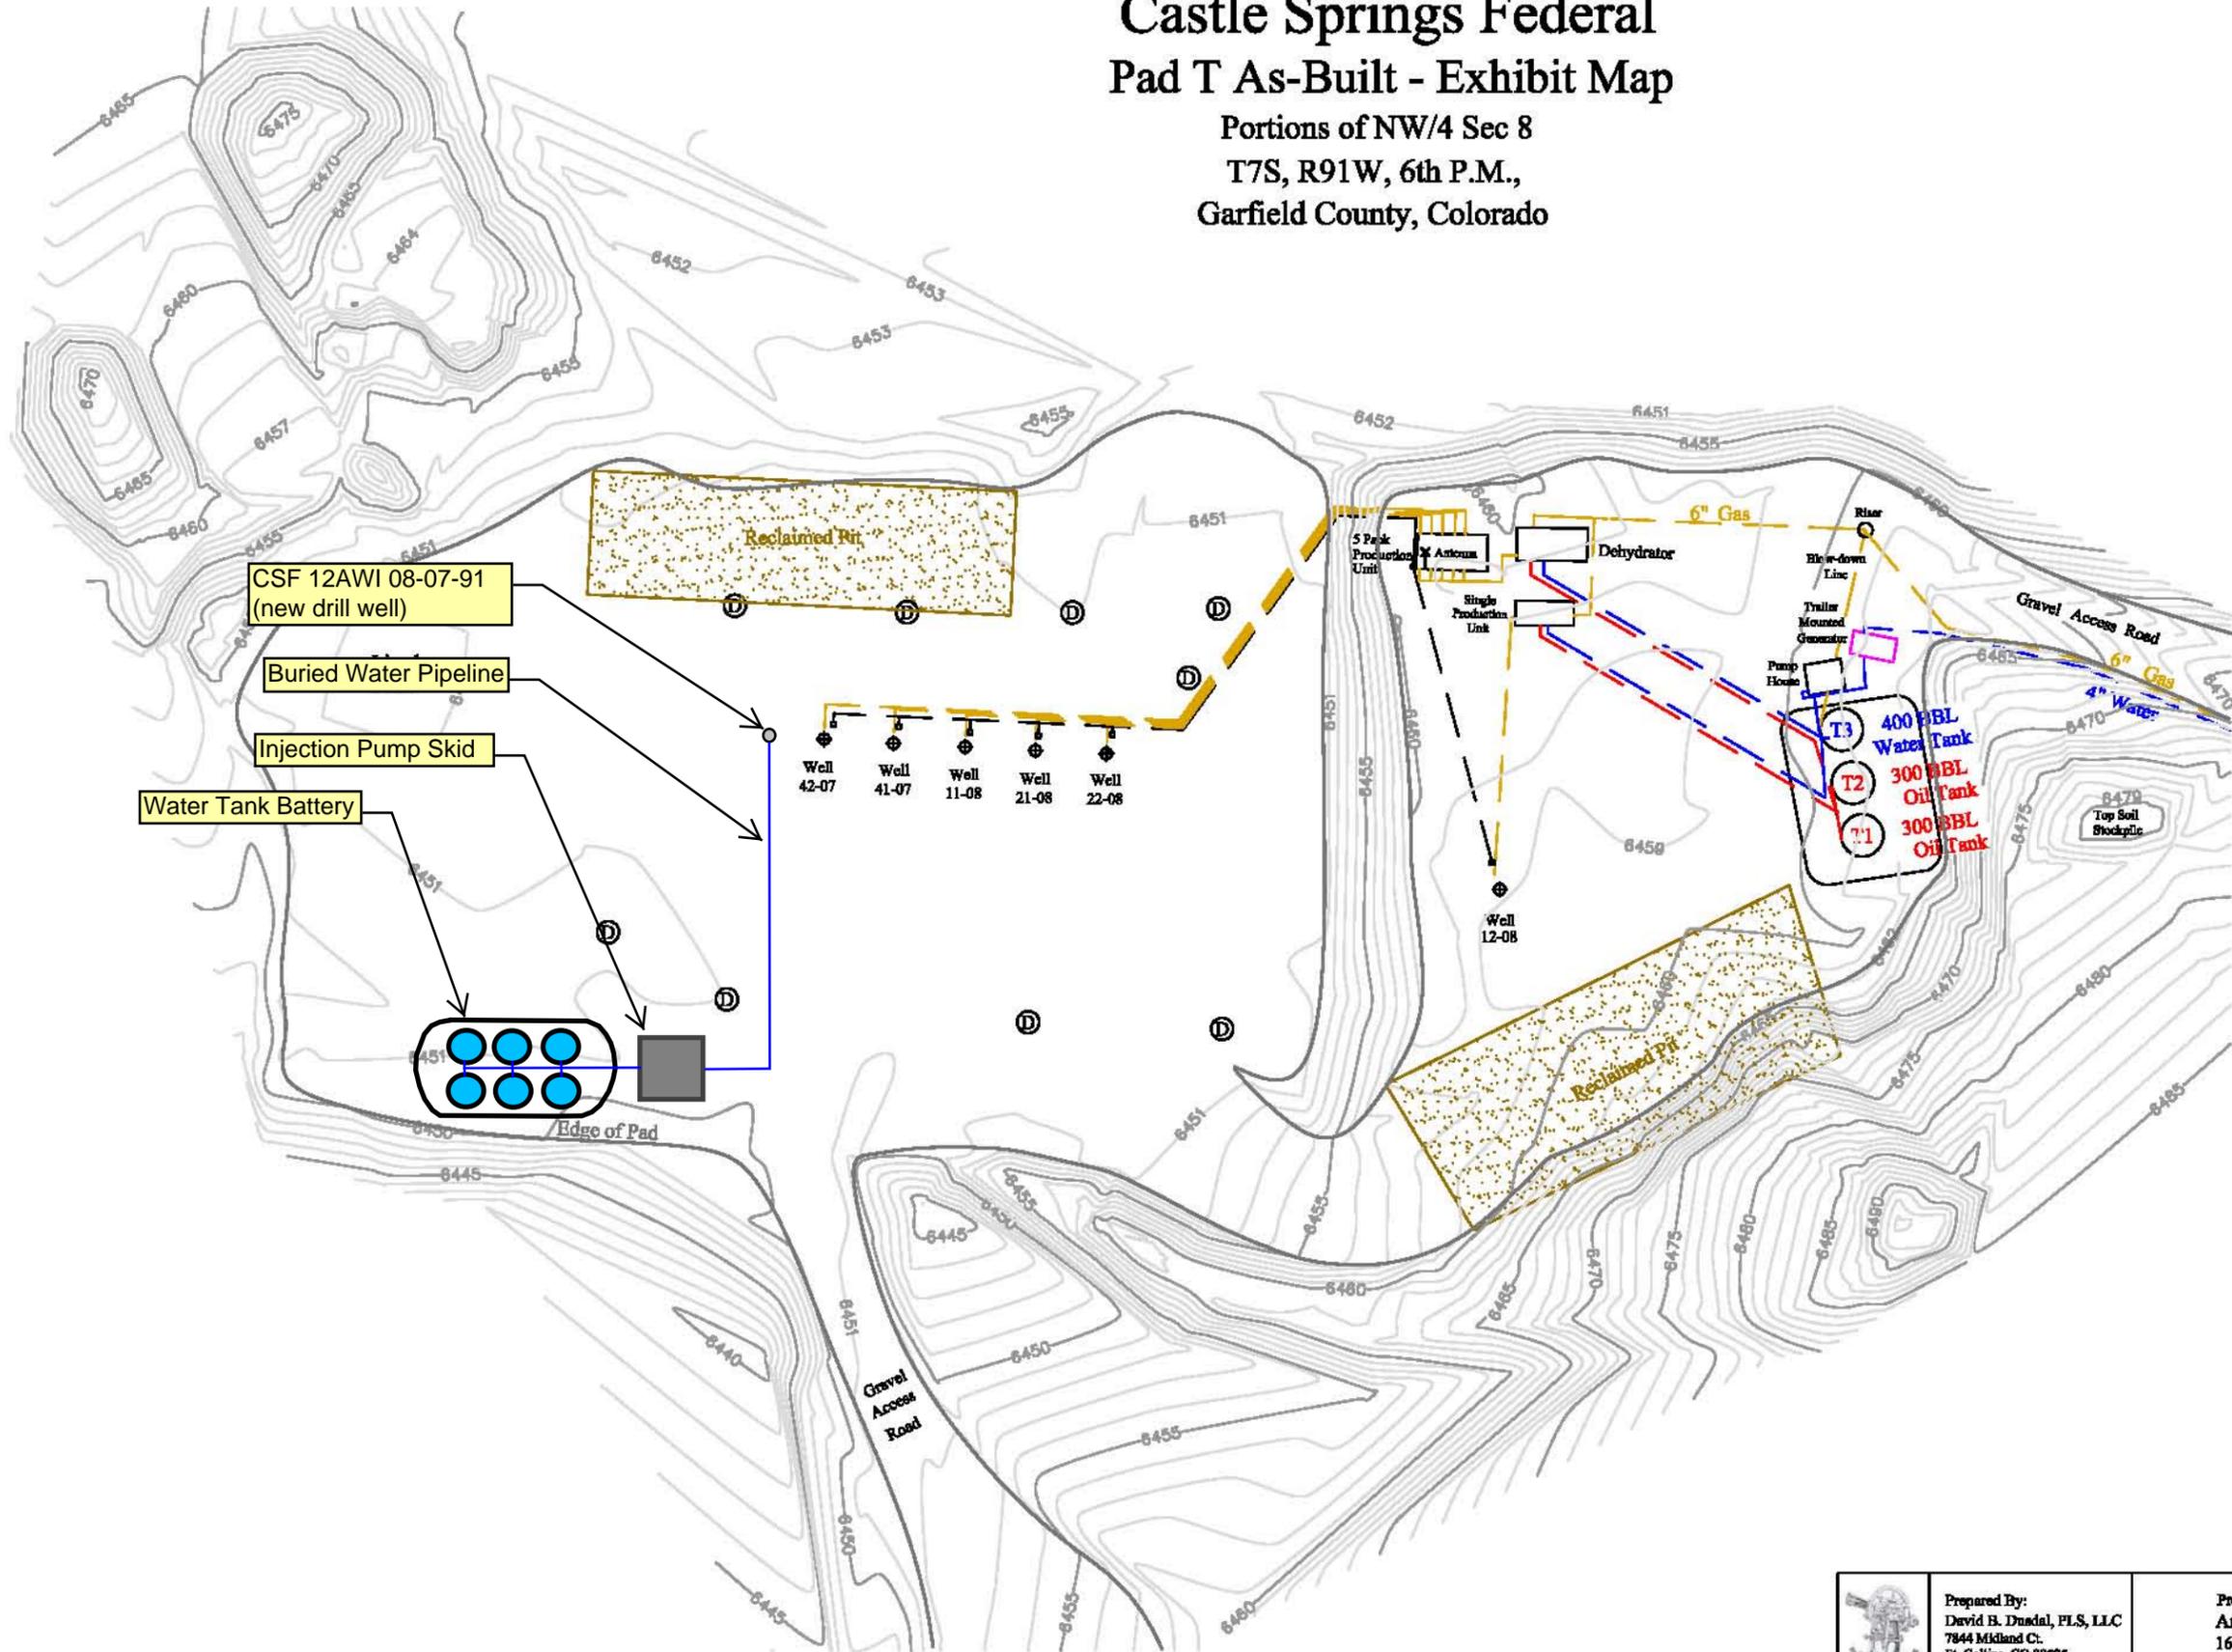

Prepared By:
David B. Drundal, P.E., LLC
7844 Midland Ct.
Ft. Collins, CO 80525
(970) 217-2450
(970) 663-9317 Fax

Prepared For:
Antero Resources
1625 17th Street
Suite 300
Denver, CO 80202

Project Name: Castle Springs Federal
Project Number: FC04200
Drawing Name: Pad T As-Built
Drawing Date: 7/2/08
Date Surveyed: 6/12/08