

Free Leases
 East 1/2
 12-40N-18W

COG-15396
 13-40N-18W


Free Lease
 S/2 13-40N-18W
 x/2 13/40N/18W

COGCC GIS Online

Pr J.A
 all in Sect 1, 12, 13, 24 in

Free Lease
 COG 15396
 in PA DCE Canyon

- Red Lines
- OIL AND GAS WELLS**
- Oil and Gas Wells
- CITIES TOWNS PLACES**
- Cities
- Towns and Places
- ROADS AND RRS**
- Major Highways
- BLM LEASE STIPS**
- 1/4' Lease Notice
- BLM O&G/LAND INFO**
- Participating Areas
- Exploratory Units
- SAN JUAN BASIN**
- Fruitland PC
- MUNICIPAL BOUNDARIES

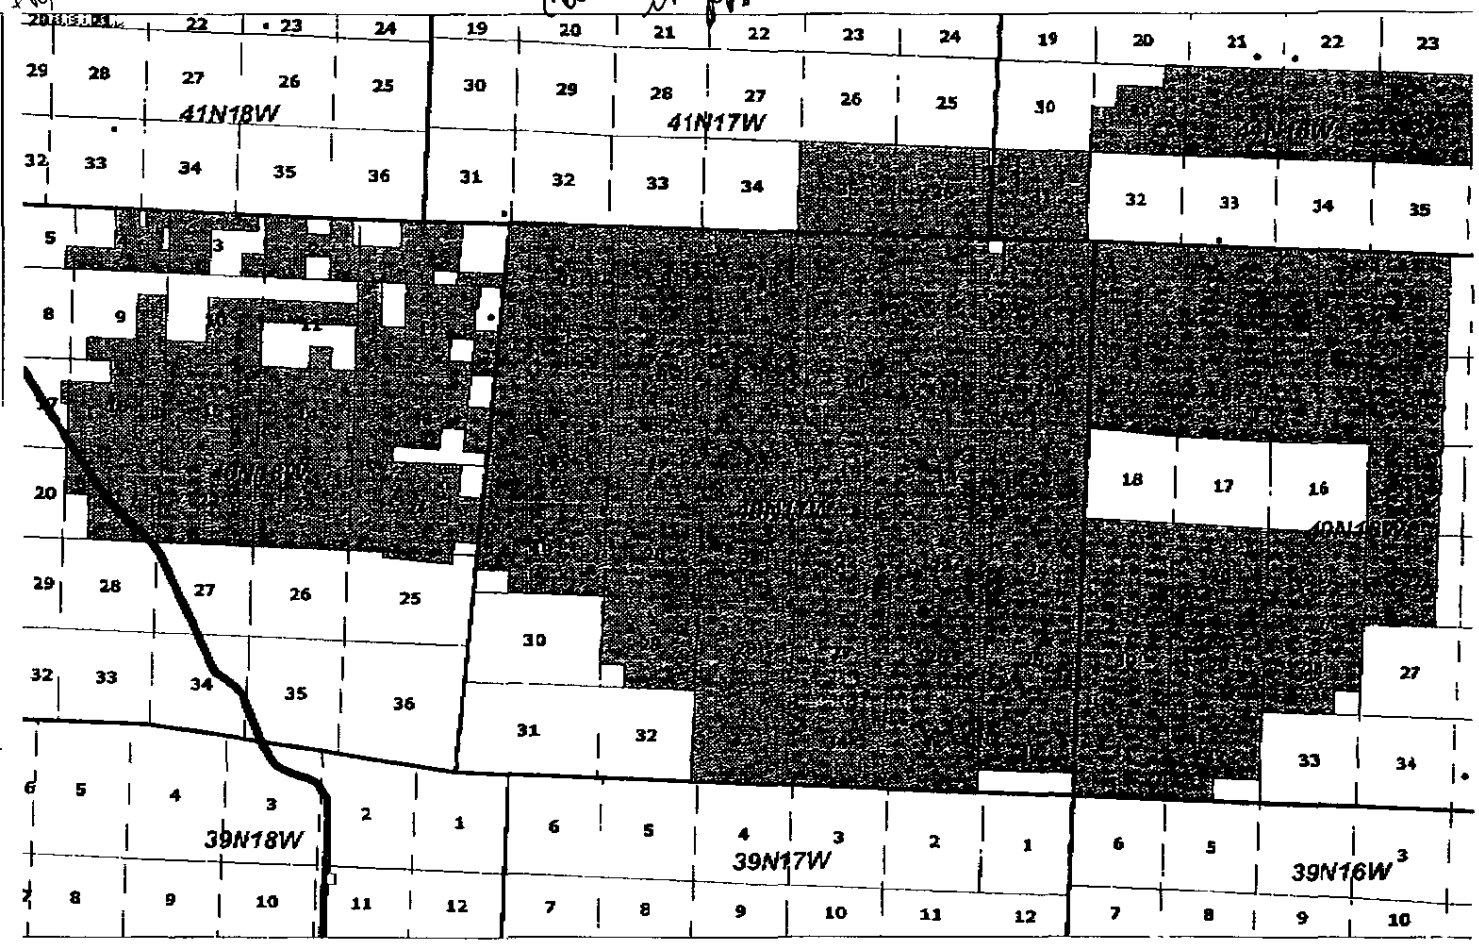

SCALE 1 : 130,572

