


PLOTTED: THU, 12/09/10 12:24PM BY: CDDGER MCCARY
 DRAWING: E:\3977\...LDD-589-7\DWG\589-7-WELL_PADS\589-7-WELL_PADS-REV-4.DWG

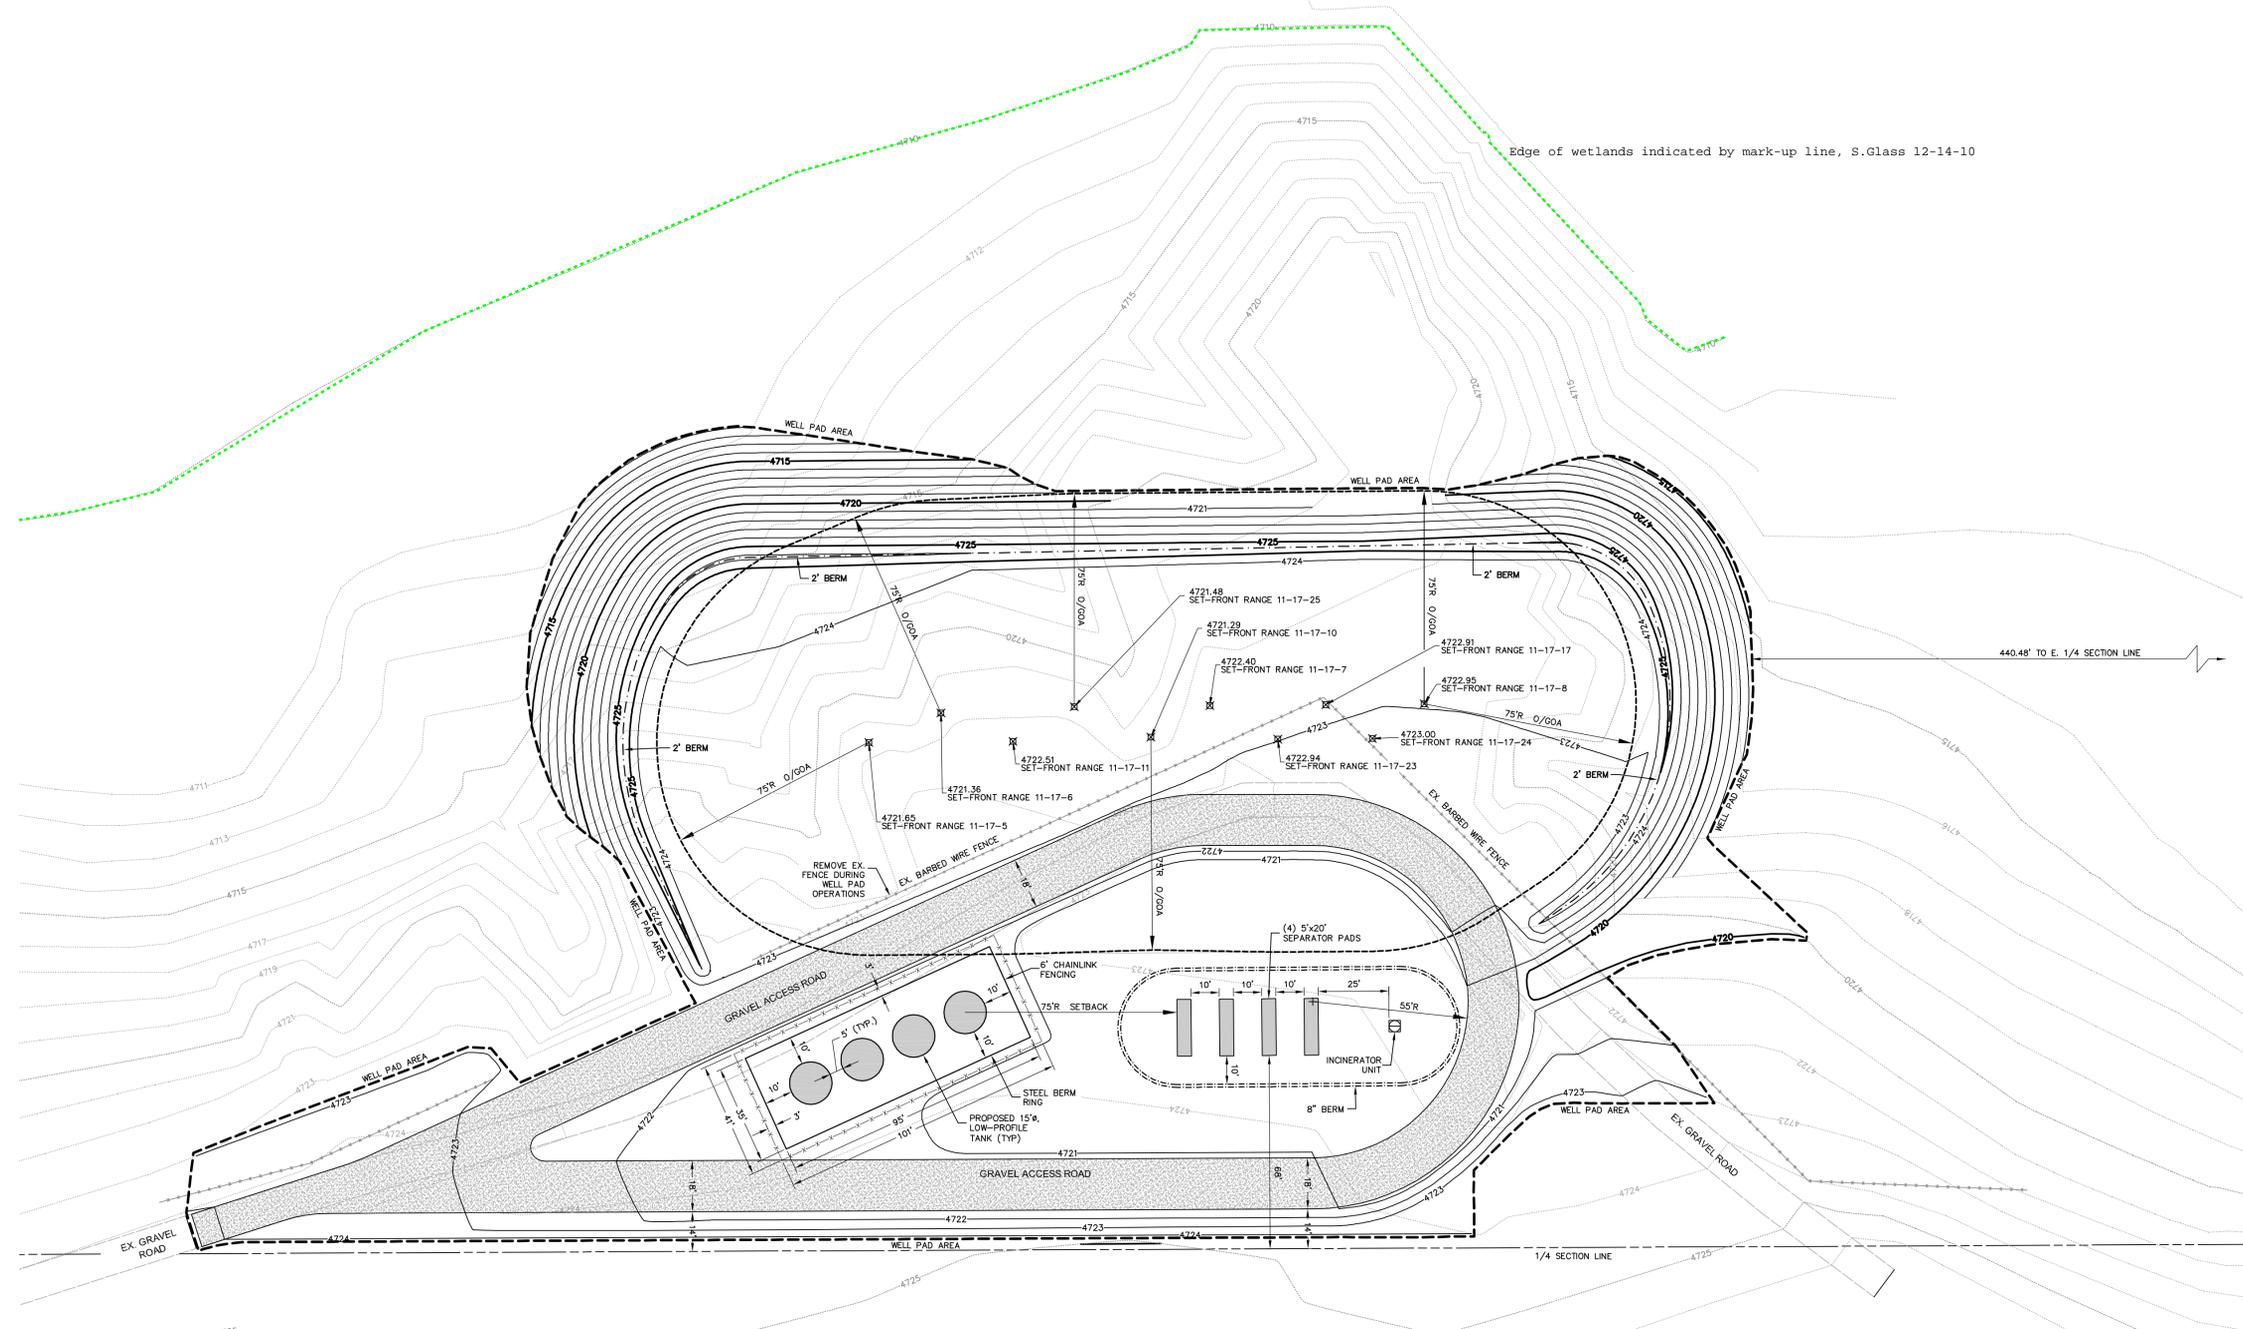


Edge of wetlands indicated by mark-up line, S.Glass 12-14-10

WELL PAD LOCATION


IN THE NE1/4 OF THE SW1/4
 OF SECTION 17, T4N, R66W
 OF THE 6TH P.M., COUNTY
 OF WELD, STATE OF COLORADO.

WELL PAD AREA

2.579 ACRES (112,351.193 SQ. FEET)

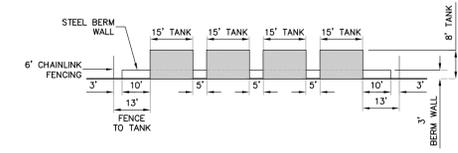


TANK AREA CROSS-SECTION
 SCALE: 1"=30'

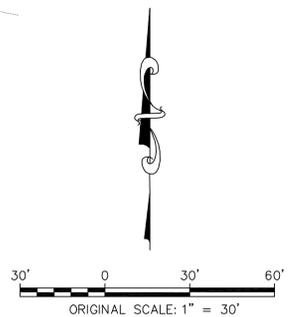

NO.	DESCRIPTION	DATE	BY
1.	REVISED LOCATION OF INCINERATOR & SEPARATORS	10.07.10	CM
2.	REVISED GRADING, ADDED BERMS	10.14.10	CM
3.	ADDED GRADING PLAN & CROSS-SECTIONS	11.09.10	CM
4.	REVISED PAD LAYOUT, ACCESS ROAD, GRADING & SECTIONS	12.09.10	CM

ENGINEERING : 1880 Leffland Circle, Suite A
 PLANNING : Longmont, CO 80501
 SURVEYING : P. 303.682.1131
 : F. 303.682.1149

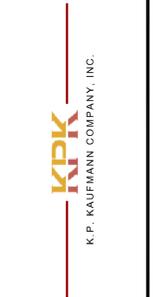

**FRONT RANGE
 11-17-SERIES**
 CONCEPTUAL WELL PAD LAYOUT

DATE: 12.09.2010
 DRAWN BY: CM
 CHECKED BY: PB
 JOB NO: 597-7

EX-A
 1 OF 2

