



H29OU 8SR96 29NE5E WATER TRANSFER PAD SEC 29 8S-96W

-  Red Lines
- OIL AND GAS WELLS**
 -  Oil and Gas Wells
 -  Temporary Point
-  Buffer layer
- CITIES TOWNS PLACES**
 -  Towns and Places
- ROADS AND RRS**
 -  Major Highways
 -  Major Roads
- WATER RESOURCES**
 -  Water Wells
 -  Lakes
 -  Major Rivers
 -  Streams
- SAN JUAN BASIN**
 -  Fruitland PC
- TOPOS (1: 24K)**
 -  NW Colorado Topo
 -  NE Colorado Topo

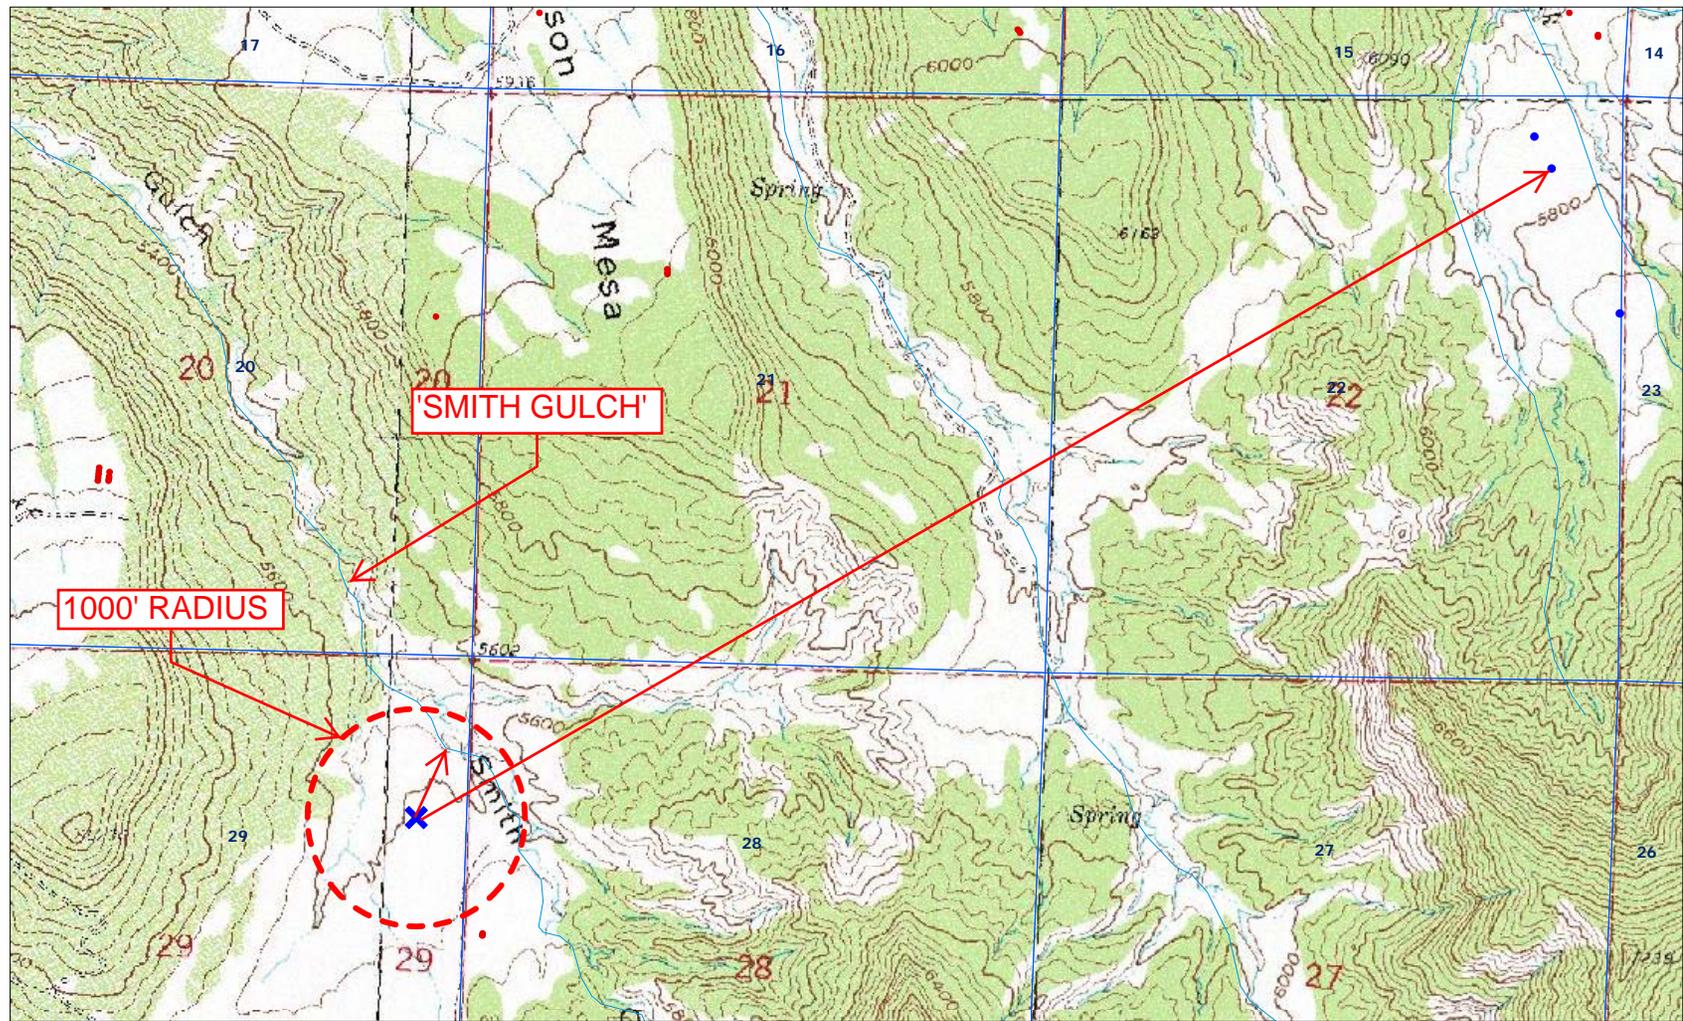

SCALE 1 : 21,066

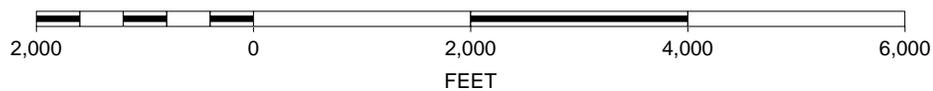

700' TO SURFACE WATER-
('SMITH GULCH')
12038' TO WATER WELL-
(46651-MH) (NEAREST WELL
WITH STATIC LEVEL DATA)

