



# STELLING 61N65W 4SESW MULTI WELL PAD HYDRO MAP SEC 4 1N-65W

-  Red Lines
- OIL AND GAS WELLS**
  -  Oil and Gas Wells
  -  Temporary Point
-  Buffer layer
- CITIES TOWNS PLACES**
  -  Towns and Places
- ROADS AND RRS**
  -  Major Highways
- WATER RESOURCES**
  -  Water Wells
- SAN JUAN BASIN**
  -  Fruitland PC
-  MUNICIPAL BOUNDARIES
- TOPOS (1: 24K)**
  -  NE Colorado Topo

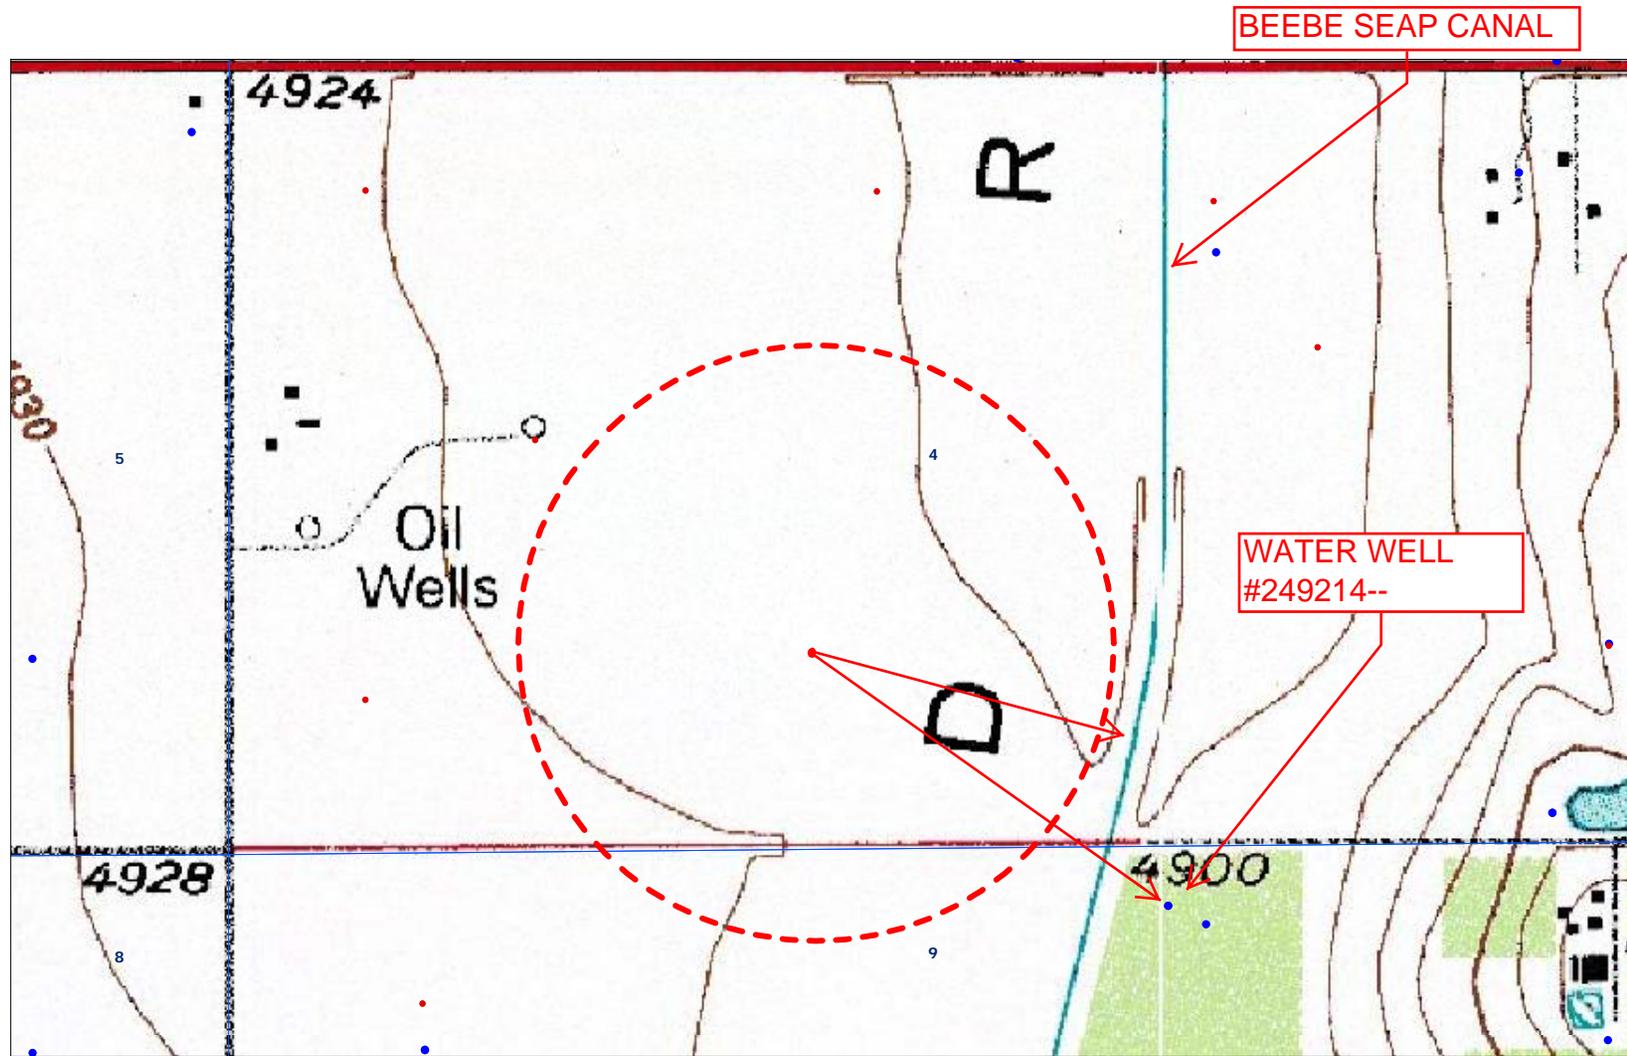

SCALE 1 : 7,695

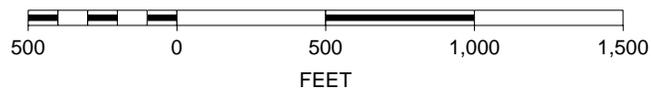

1100' TO BEEBE SEEP CANAL  
 1490' TO WATER WELL  
 #249214-- (150' STATIC)  
 LOC ID #331527

