
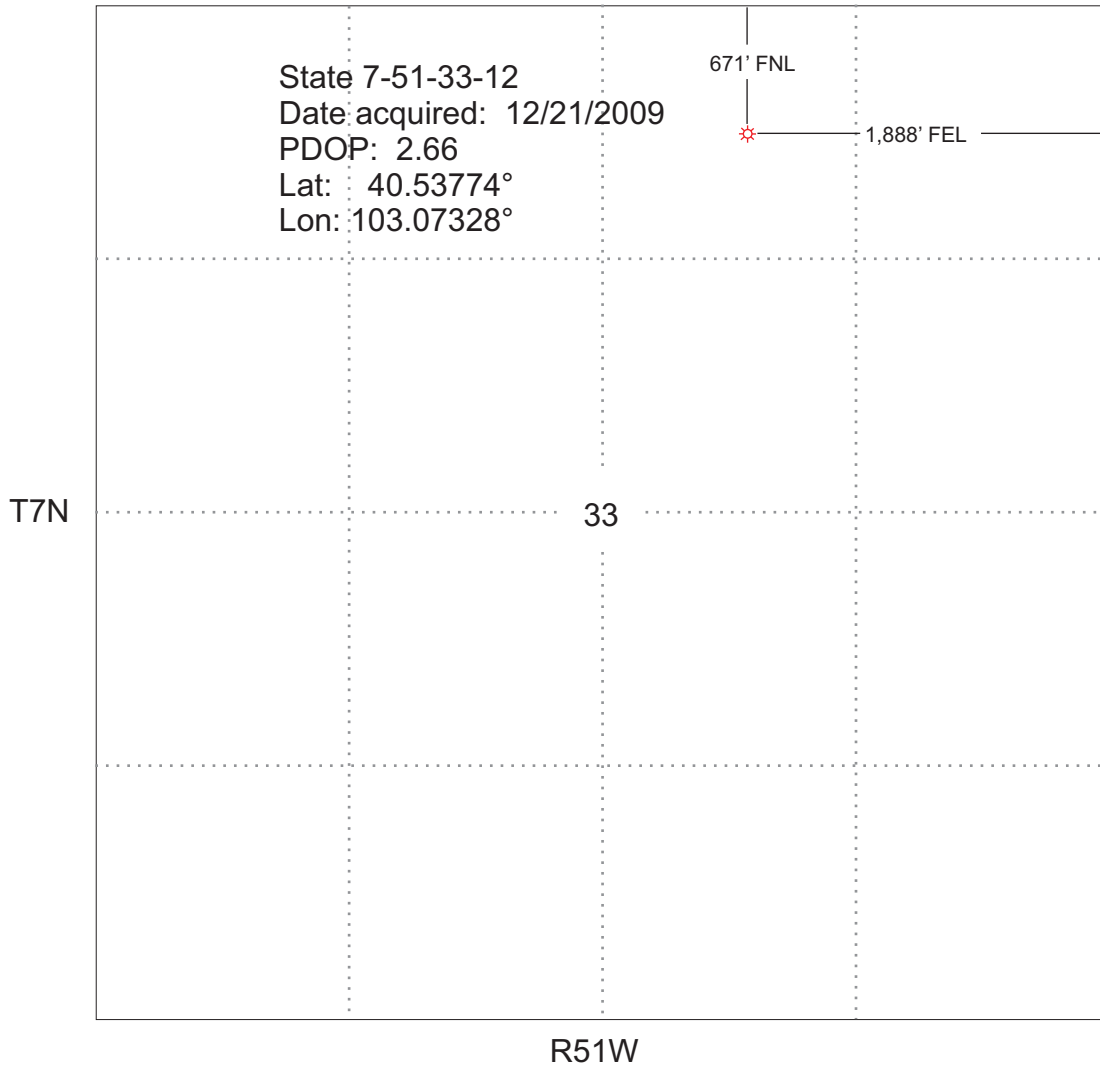


AS-BUILT LOCATION

State 7-51-33-12 Well



Dated 12/22/2009

Compiled and drawn by Duane Russell
James C. Karo Associates
Telephone: 303.279.0789
Email: duane@jameskaro.com