



OXY USA Inc.

A subsidiary of Occidental Petroleum Corporation



5 Greenway Plaza, Suite 110, Houston, Texas 77046-0521
P O Box 27570, Houston, Texas 77227-7570

Bruce Vollertsen
Land Negotiator
Mid-Continent Asset Team
Office (713) 366-5521
Cell (713) 885-2950

RECEIVED

JUL 23 2007

COGCC

July 11, 2007

Jones Farms
C/O Mr. Ray Don Jones
P.O. Box 1001
Elkhart, KS 67950

**RE: Request for Surface Owner Waiver of Rule 305 and 306
N1/2 and SW/4 Section 13: T 33S R 42W
Baca County, CO
OXY Jones A-1 Well**

Dear Mr. Jones:

In accordance with Mr. ~~Charles Berry's conversation~~ with you on ~~July 3, 2007~~ during the ~~surveying of the subject property~~, OXY USA, Inc (OXY) wishes to confirm Mr. Berry's request that you waive the thirty (30) day notice period required under Rule 305 b of the Colorado Oil and Gas Conservation Commission (COGCC)

By your execution of this letter, you further acknowledge receiving a ~~copy of the COGCC informational brochure~~ which was provided to you at the aforementioned meeting

With the granting of this waiver, it is agreed and understood between the parties hereto that ~~State Rules 305 and 306 are waived~~ for the purposes of operations to be conducted related to the proposed Jones A-1 well and that ~~Ray Don Jones~~, the authorized representative of Jones Farms expressly acknowledges that this Agreement satisfies OXY's obligation under COGCC rules to consult in good faith with the surface owner regarding the proposed oil and gas operations


Jones Farms further expressly acknowledges that this Agreement shall be deemed to be ~~specifically applicable to~~, and to fully satisfy, the obligation of OXY to accommodate Jones Farm's use of the surface of the described lands, existing or future, and waives any statutory or common law claims to the contrary

If your are in agreement with the above, please forward one (1) original copy of this letter to my attention after signing. Thank you for your consideration in this matter. Should you have any questions, please feel free to contact me at the above address.

Sincerely,

Bruce Vollertsen
Land Negotiator
OXY USA Inc.

July 12, 2007
Page 2

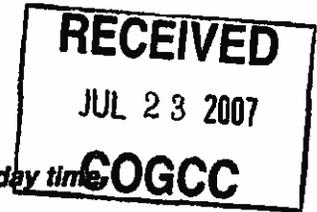


The undersigned hereby approves and grants a waiver of the thirty (30) day time period and waiver of COGCC Rules 305 b and 306.

Jones Farms

By ~~Ray [unclear]~~

Title Partner

Date. 7-16-07

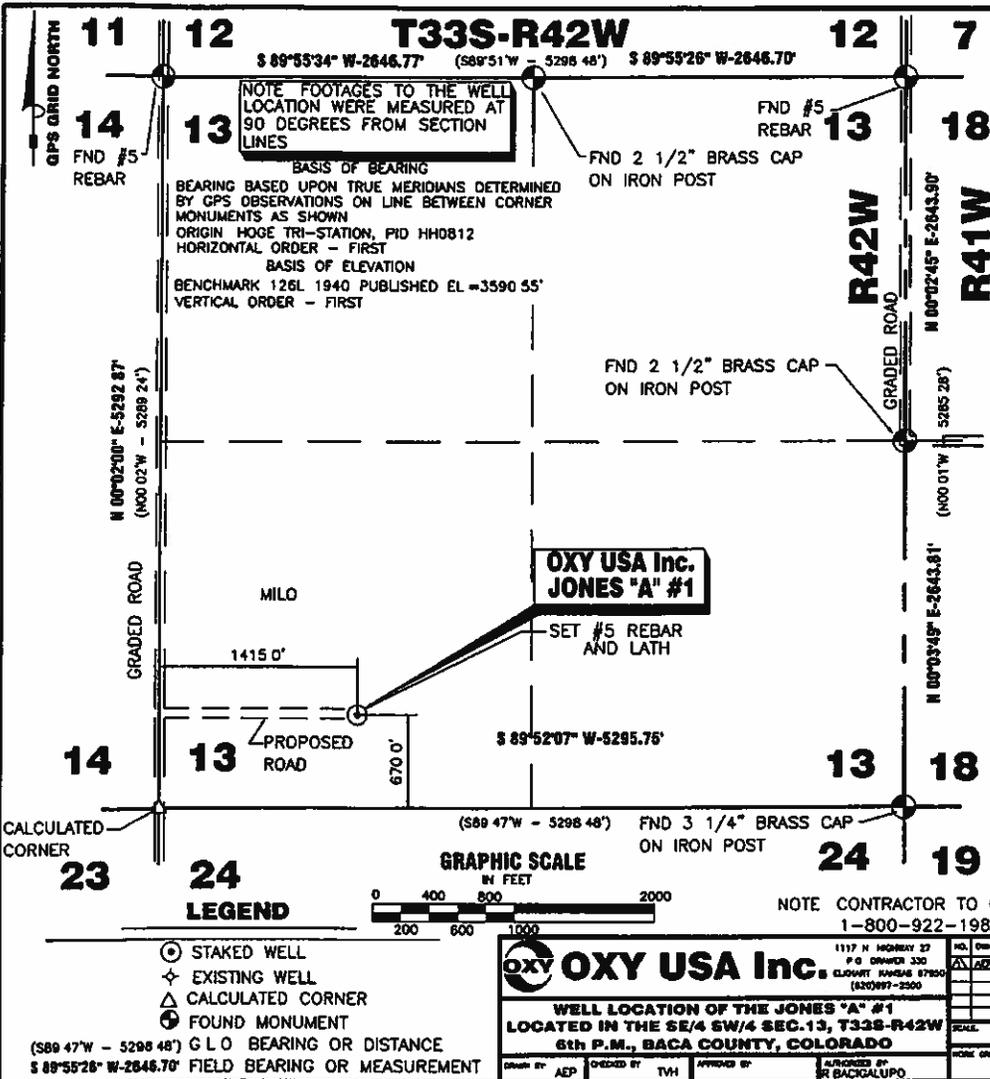

DATE of SURVEY 7/3/07
 OPERATOR OXY USA Inc.
 WELL NAME JONES "A" #1
 LOCATION SE/4 SW/4 SEC.13, T33S-R42W, 6th P.M.
 FOOTAGES & 670.0' F S L
 RELATIONS Δ 1415.0' F W L
 ELEVATION 3755.2'
 DISTANCE TO EXISTING WELL N/A NONE
 AUTHORIZED BY R.BACIGALUPO
 CROP MILO
 WATER WELL N/A
 NEAREST IMPROVEMENT NONE VISIBLE
 LATITUDE 37.165603°N
 LONGITUDE 102.108334°W
 STATE PLANE COORD. X=3988119.92
 COLORADO SOUTH ZONE Y=1199614.45
 NAD 83
 POOP VALUE 6.0
 GPS OPERATOR T.HARDER



RECEIVED
 28271
 7-13-07
 COLORADO REGISTERED SURVEYOR
 Theodore V Harder P.L.S. NO 28271

NOTE CONTRACTOR TO CONTACT UTILITY NOTIFICATION OF COLORADO
 1-800-922-1987 PRIOR TO ANY EXCAVATION OR CONSTRUCTION

OXY USA Inc.		1117 N HIGHWAY 27 P.O. DRAWER 330 ELDORADO, KANSAS 67801 (620)997-2500	NO. 001	DATE 7/13/07
WELL LOCATION OF THE JONES "A" #1		LOCATED IN THE SE/4 SW/4 SEC.13, T33S-R42W	SCALE 1" = 1000'	DATE 7/3/07
6th P.M., BACA COUNTY, COLORADO		DRAWN BY AEP	CHECKED BY TVH	APPROVED BY R.BACIGALUPO

HARDER
 AND ASSOCIATES "locating our world"
 LAND SURVEYING GPS SPECIALISTS
 P.O. BOX 514 HINCHON
 Elkhart, Kansas 67550
 Phone (620) 697-2996
 Fax (620) 697-4178
 E-Mail: thard@harter.com

DRAWING NO OX067A09