


COGCC_GISOnline

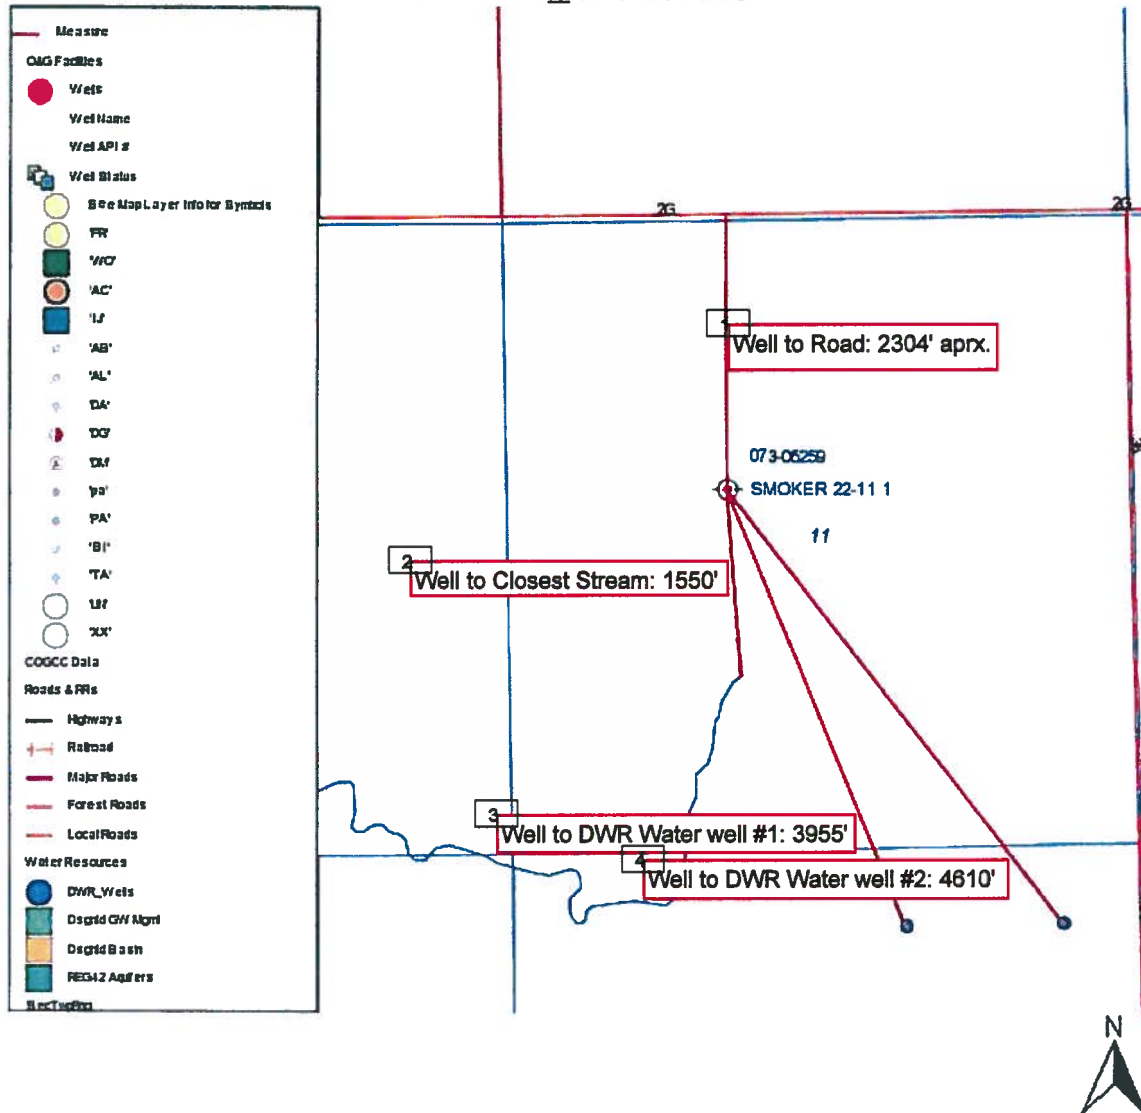

Summary of Comments on Smoker 22-11 #1 - Wellsite

Notable Distances

Page:1



Number: 1 Author:paulg Subject:TextBox Date:9/14/2012 3:33:05 PM

Well to Road: 2304' aprx.



Number: 2 Author:paulg Subject:TextBox Date:9/14/2012 3:33:08 PM

Well to Closest Stream: 1550'



Number: 3 Author:paulg Subject:TextBox Date:9/14/2012 3:33:18 PM

Well to DWR Water well #1: 3955'



Number: 4 Author:paulg Subject:TextBox Date:9/14/2012 3:33:26 PM

Well to DWR Water well #2: 4610'