





Lat40°, Inc. 1635 Foxtrail Drive, Suite 325 Loveland, CO 970-776-3321

# AS-BUILT DRAWING

## HARPER USX EE27 FACILITY

SECTION: 27  
TOWNSHIP: 7N  
RANGE: 65W

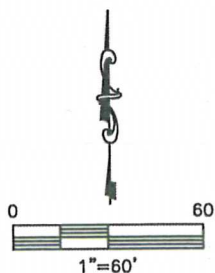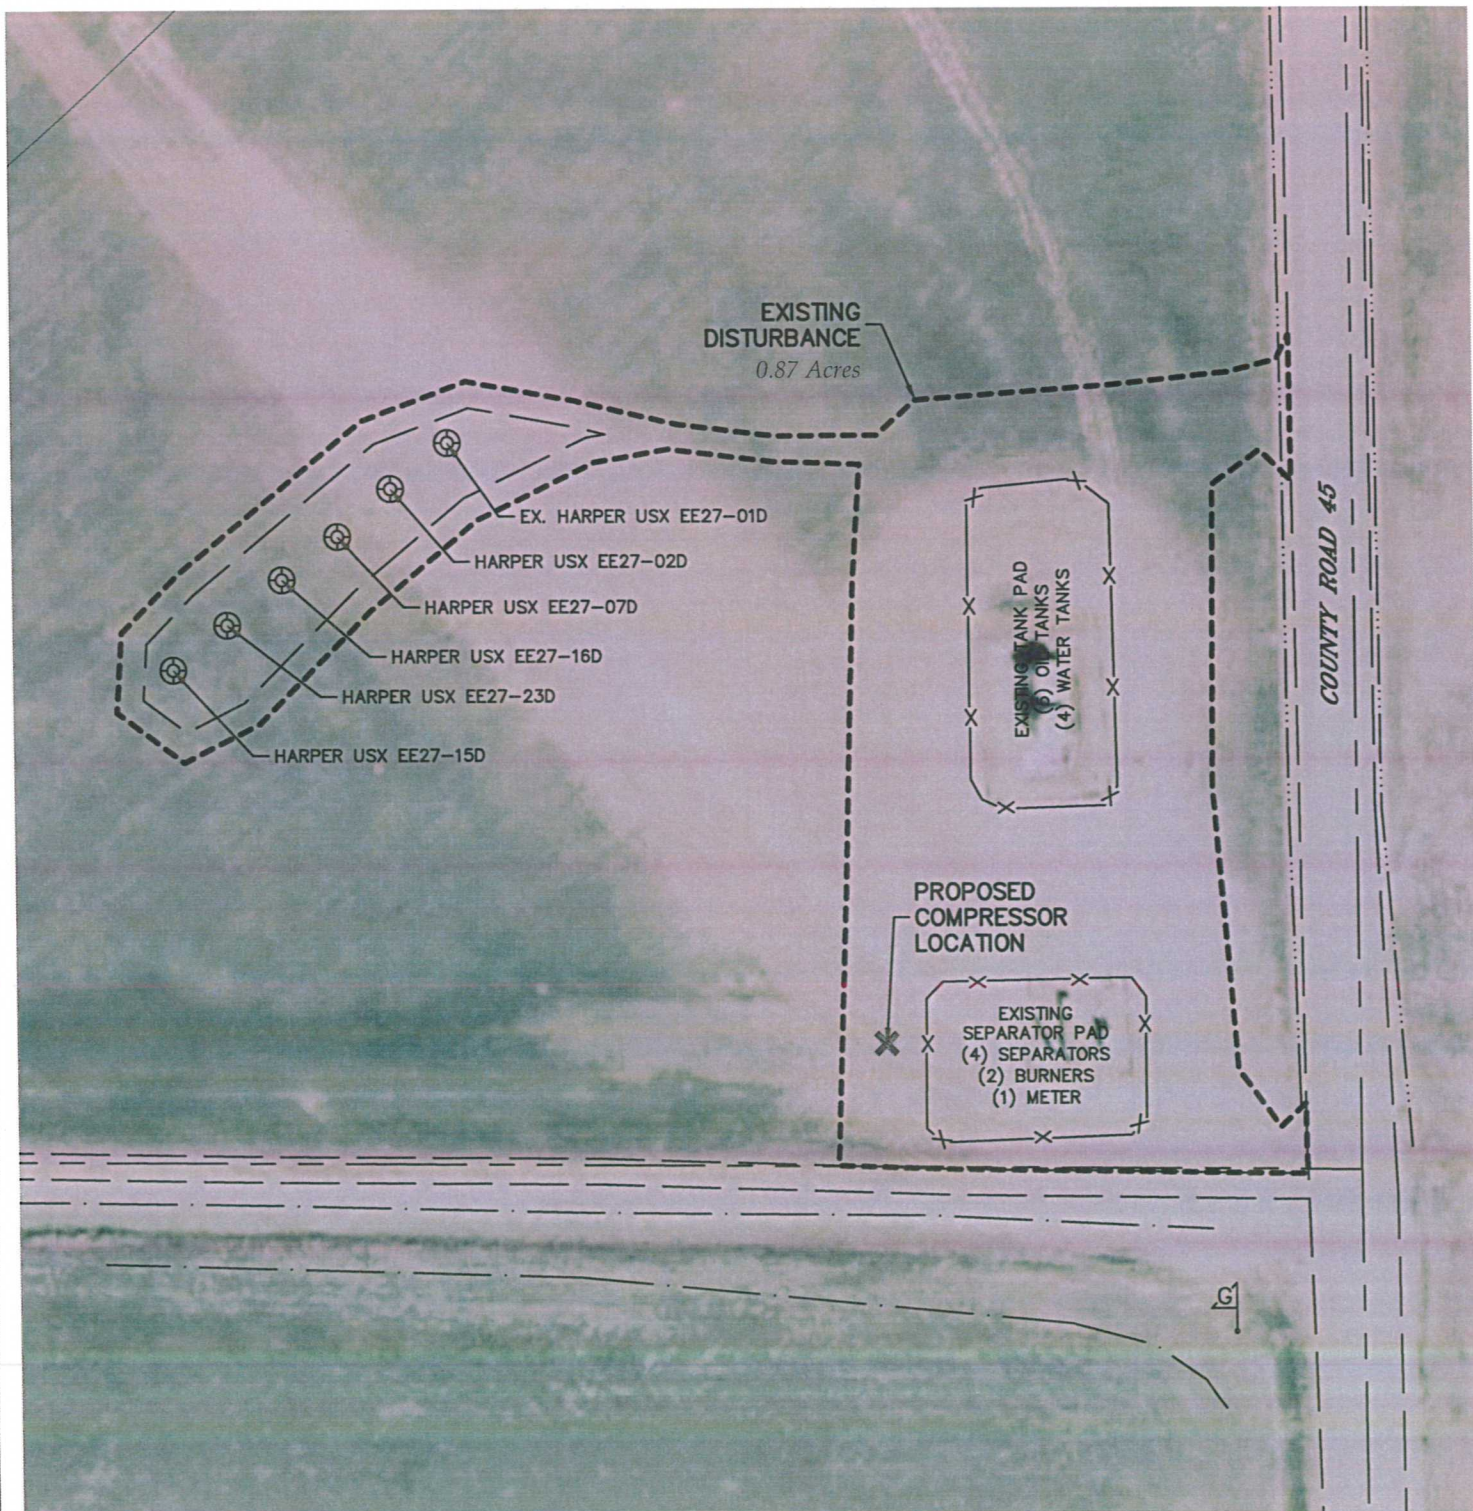

DATE: 01/16/2014  
PROJECT#: 2011070