






Lat40°, Inc. 1635 Foxtrail Drive, Suite 325 Loveland, CO 970-776-3321

AS-BUILT DRAWING

JOHNSON PC EE33 PAD

SECTION: 33
TOWNSHIP: 7N
RANGE: 65W

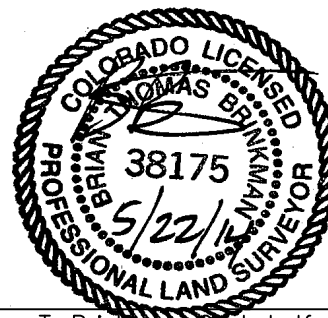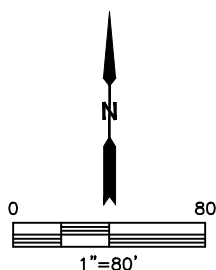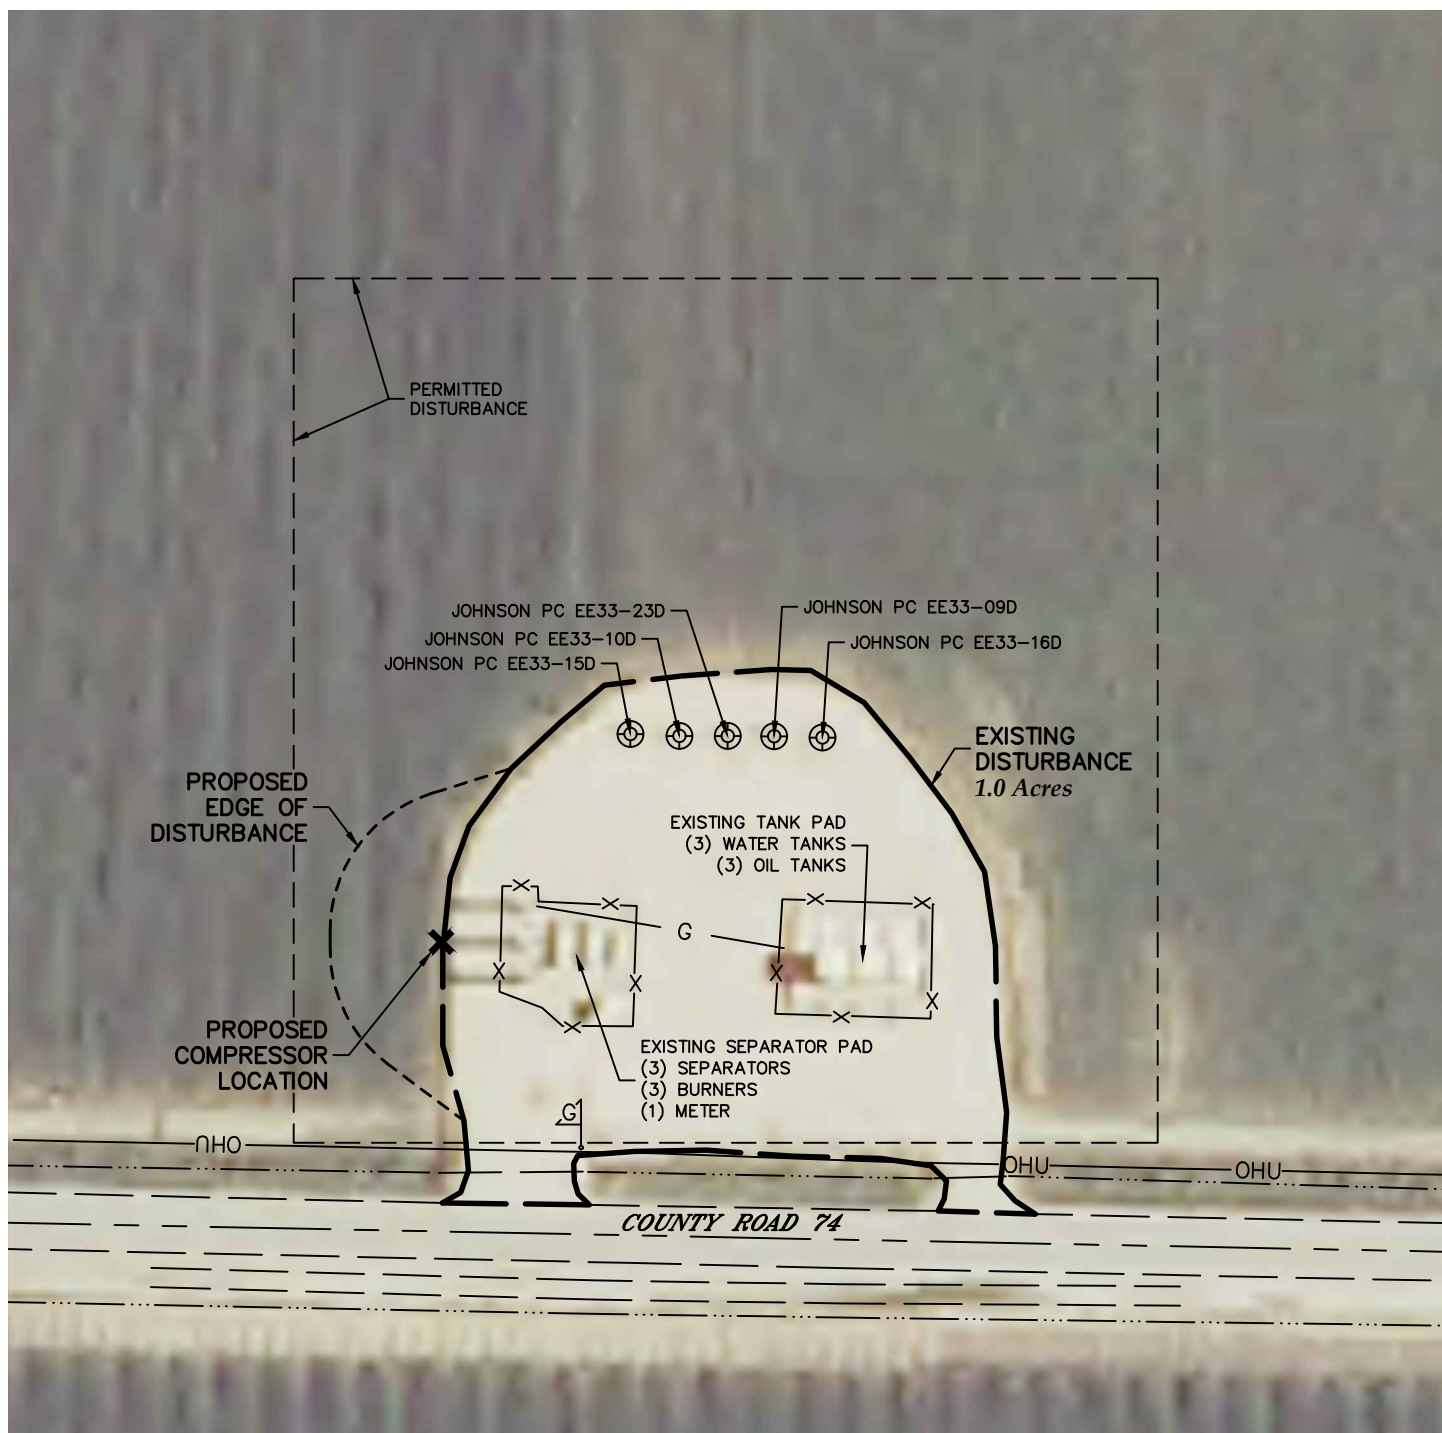

Brian T. Brinkman On behalf of Lat40°, Inc.
Colorado Licensed Professional
Land Surveyor No. 38175
DATE: 5/22/2014
PROJECT#: 2014079