


(THE) N 44°31'15" W 3554.12'

PINTO #3-17
WELL HEAD (BELOW GRADE)
LATITUDE: 37.63952° (M)
LONGITUDE: 108.96761° (M)

PLOWED FIELD

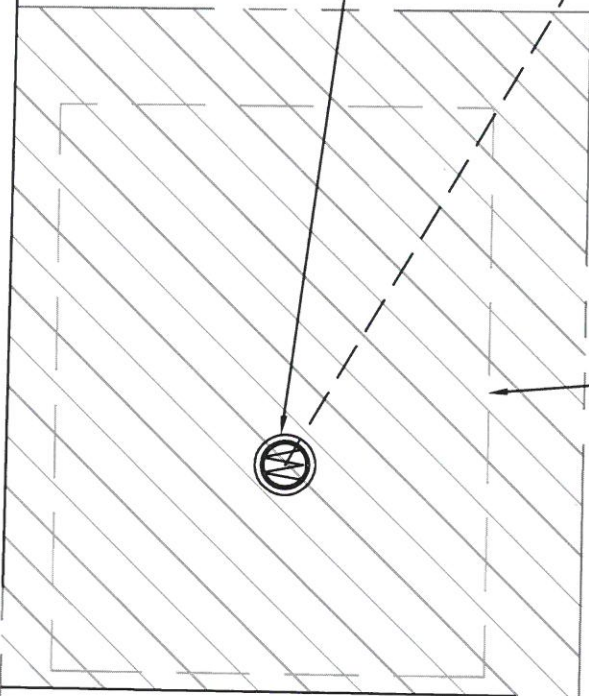

AS-BUILT FOR
DJ SIMMONS
PINTO #3-17
2498' FNL 2523' FWL
SEC. 17 T-39-N R-19-W
LAT: 37° .63952
LONG: 108° .96761
DOLORES COUNTY, COLORADO

LEGEND

-  WELLHEAD
-  (M) MEASURED
-  EDGE OF DISTURBANCE
-  PAD EXTENTS

CERTIFICATION

I, JOHN D. WAYNE, COLORADO PROFESSIONAL SURVEYOR No. 23525, DO HEREBY CERTIFY THAT THIS SURVEY PLAT AND THE ACTUAL SURVEY ON THE GROUND UPON WHICH IT IS BASED WERE PERFORMED BY ME OR UNDER MY DIRECT SUPERVISION.

DATE 12/15/14

JOHN D. WAYNE
COLORADO REG. NO. 23525



SCALE: 1" = 300'



DJ SIMMONS INC
AS-BUILT
PINTO #3-17
SE/NE 1/4 SEC 17
T-39-N, R-19-W, N.M.P.M.
DOLORES COUNTY, COLORADO
SCALE: 1"=300' DATE: 12/11/2014