



Profile View of X Section SW-NE

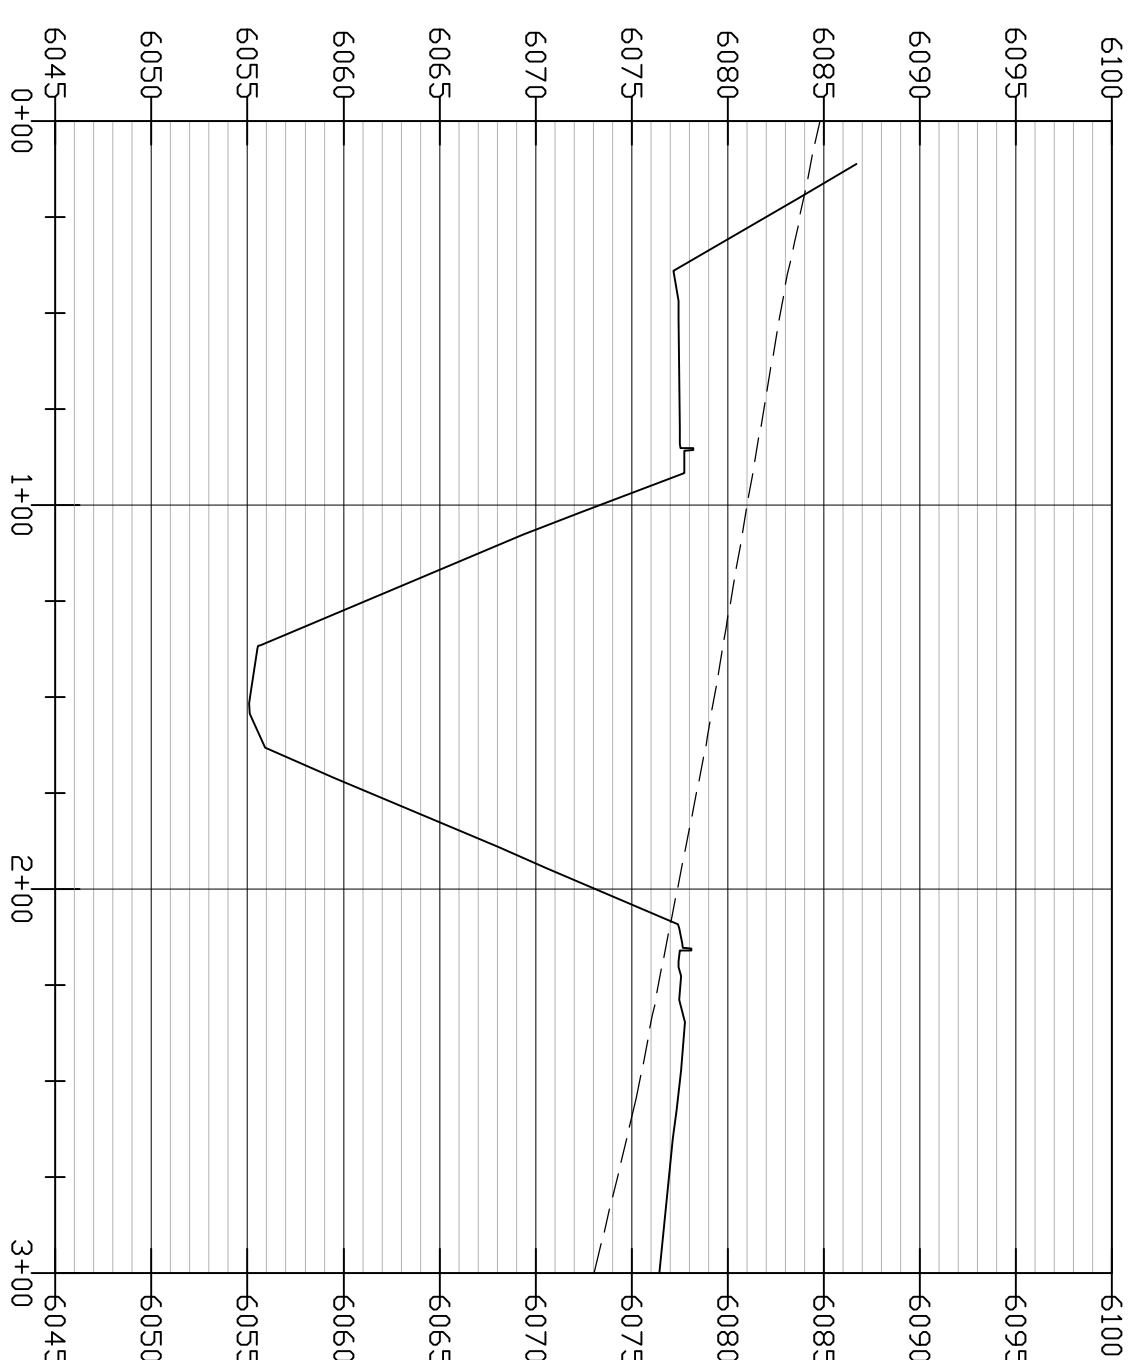

Profile View of X Section NW-SE

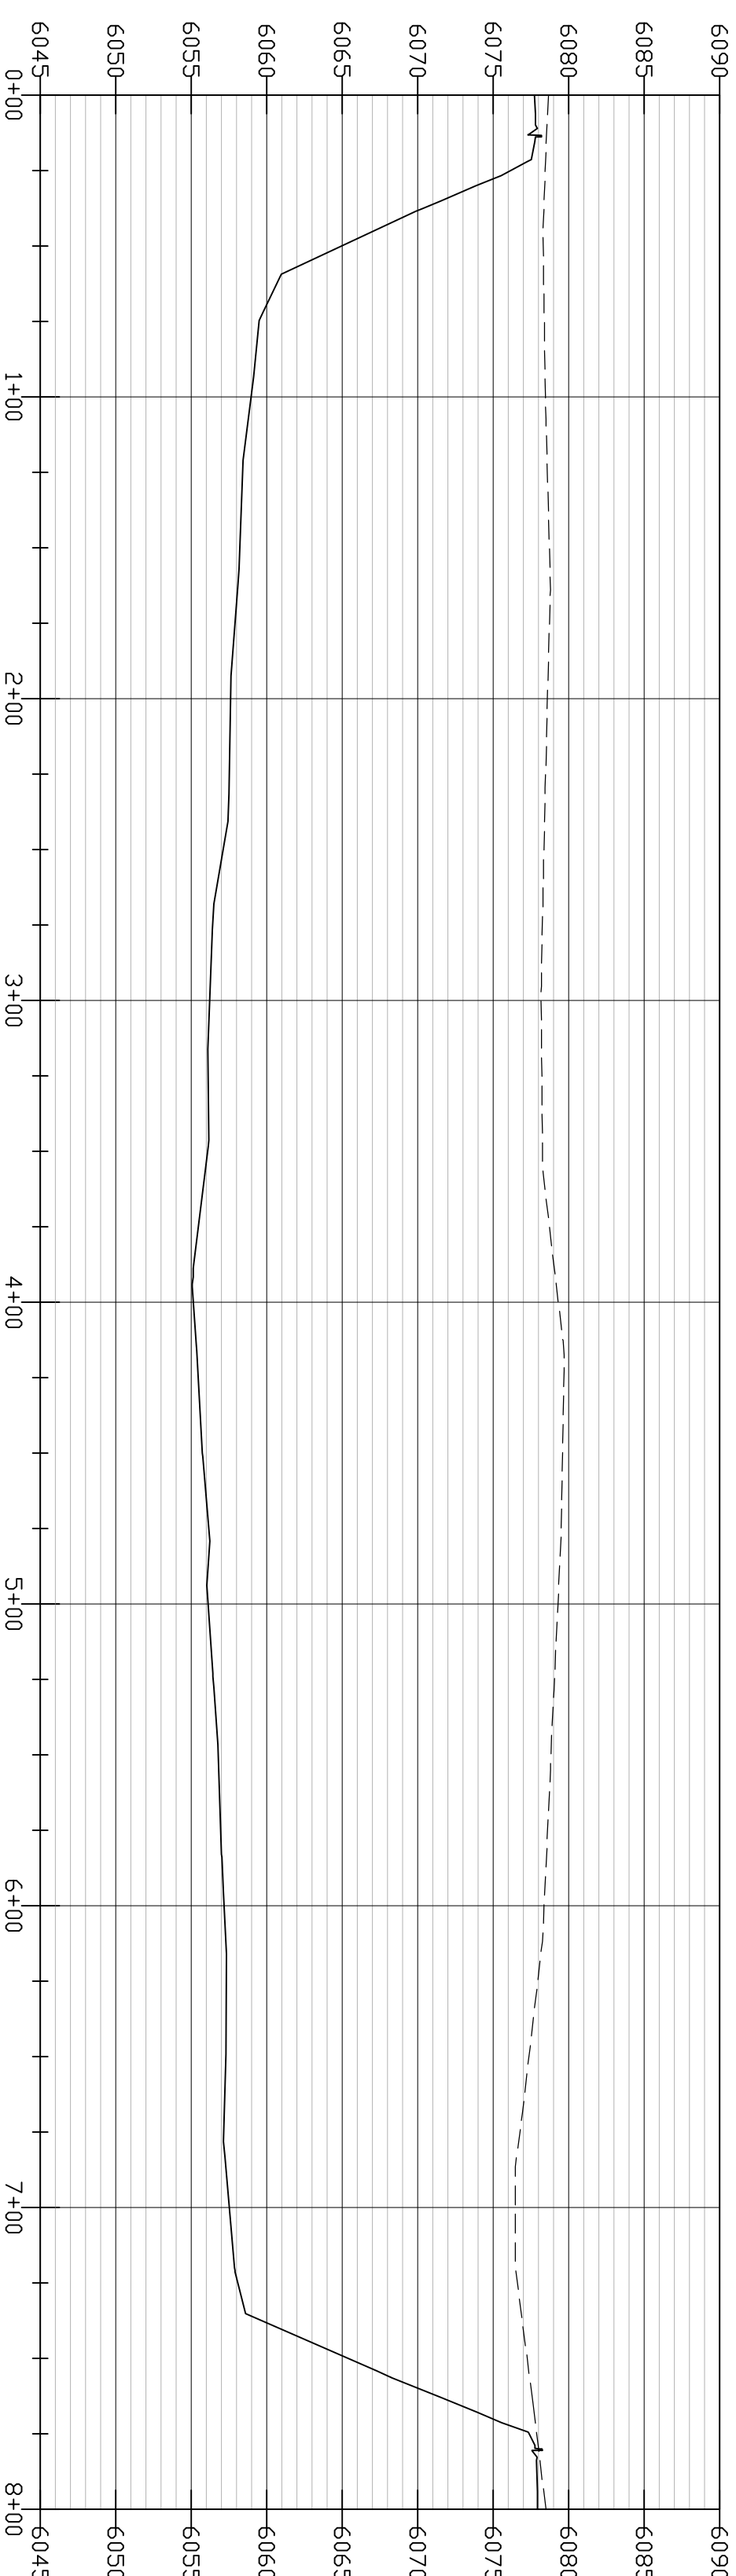

Notes:
1. As-Built survey information provided by Westch Surveying.

As-Built Pond 4 Volume (using conic method):
1,105,402 cubic feet
8,258,951 gallons
262,807 barrel (bu)
156,580.5 barrel (oil)



REFERENCE DRAWINGS	DWG. NO.

NO.	DATE	PROJECT DESCRIPTION	PROJ.	AFE	EPCM Co.	EPCM No.	APPD.

REV. NUMBER	ISSUE STAGE	DATE	BY	CHKD.	APPD.
1	Prelim. (A)				
	Bid (B)				
	Contr. (C)				
	As-Built (D)	2014-06-30	mjk	mjk	

PERMIT STAMP



ENCANA

ENCANA RIVER CITY CONSULTANTS, INC.

Cross Sections for Pond 4
Hunter Mesa Water Park
SOUTH PARACHUTE

DATE	Hunter Mesa Pond 4
PLAN	SE1/4 S1, T7S, R93WW, 6th P.M.
SITE	Water Treatment
SCALE	1" = 50' (0 Size)
ENC. NO.	1086-073