


WELLBORE DIAGRAM
AS BUILT

Surface Loc: NENE Sec 29 T44N - R16W

Operator: EnCana Oil and Gas
 Well Name: Andy's Mesa 67
 Lease Number: _____
 Location: _____
 Field: Andy's Mesa
 County: San Miguel
 API Number: 05-113-06239
 Diagram Date: 3/13/2012

FORMATIONS
 Cutler 4650
 Honaker Trail 6495

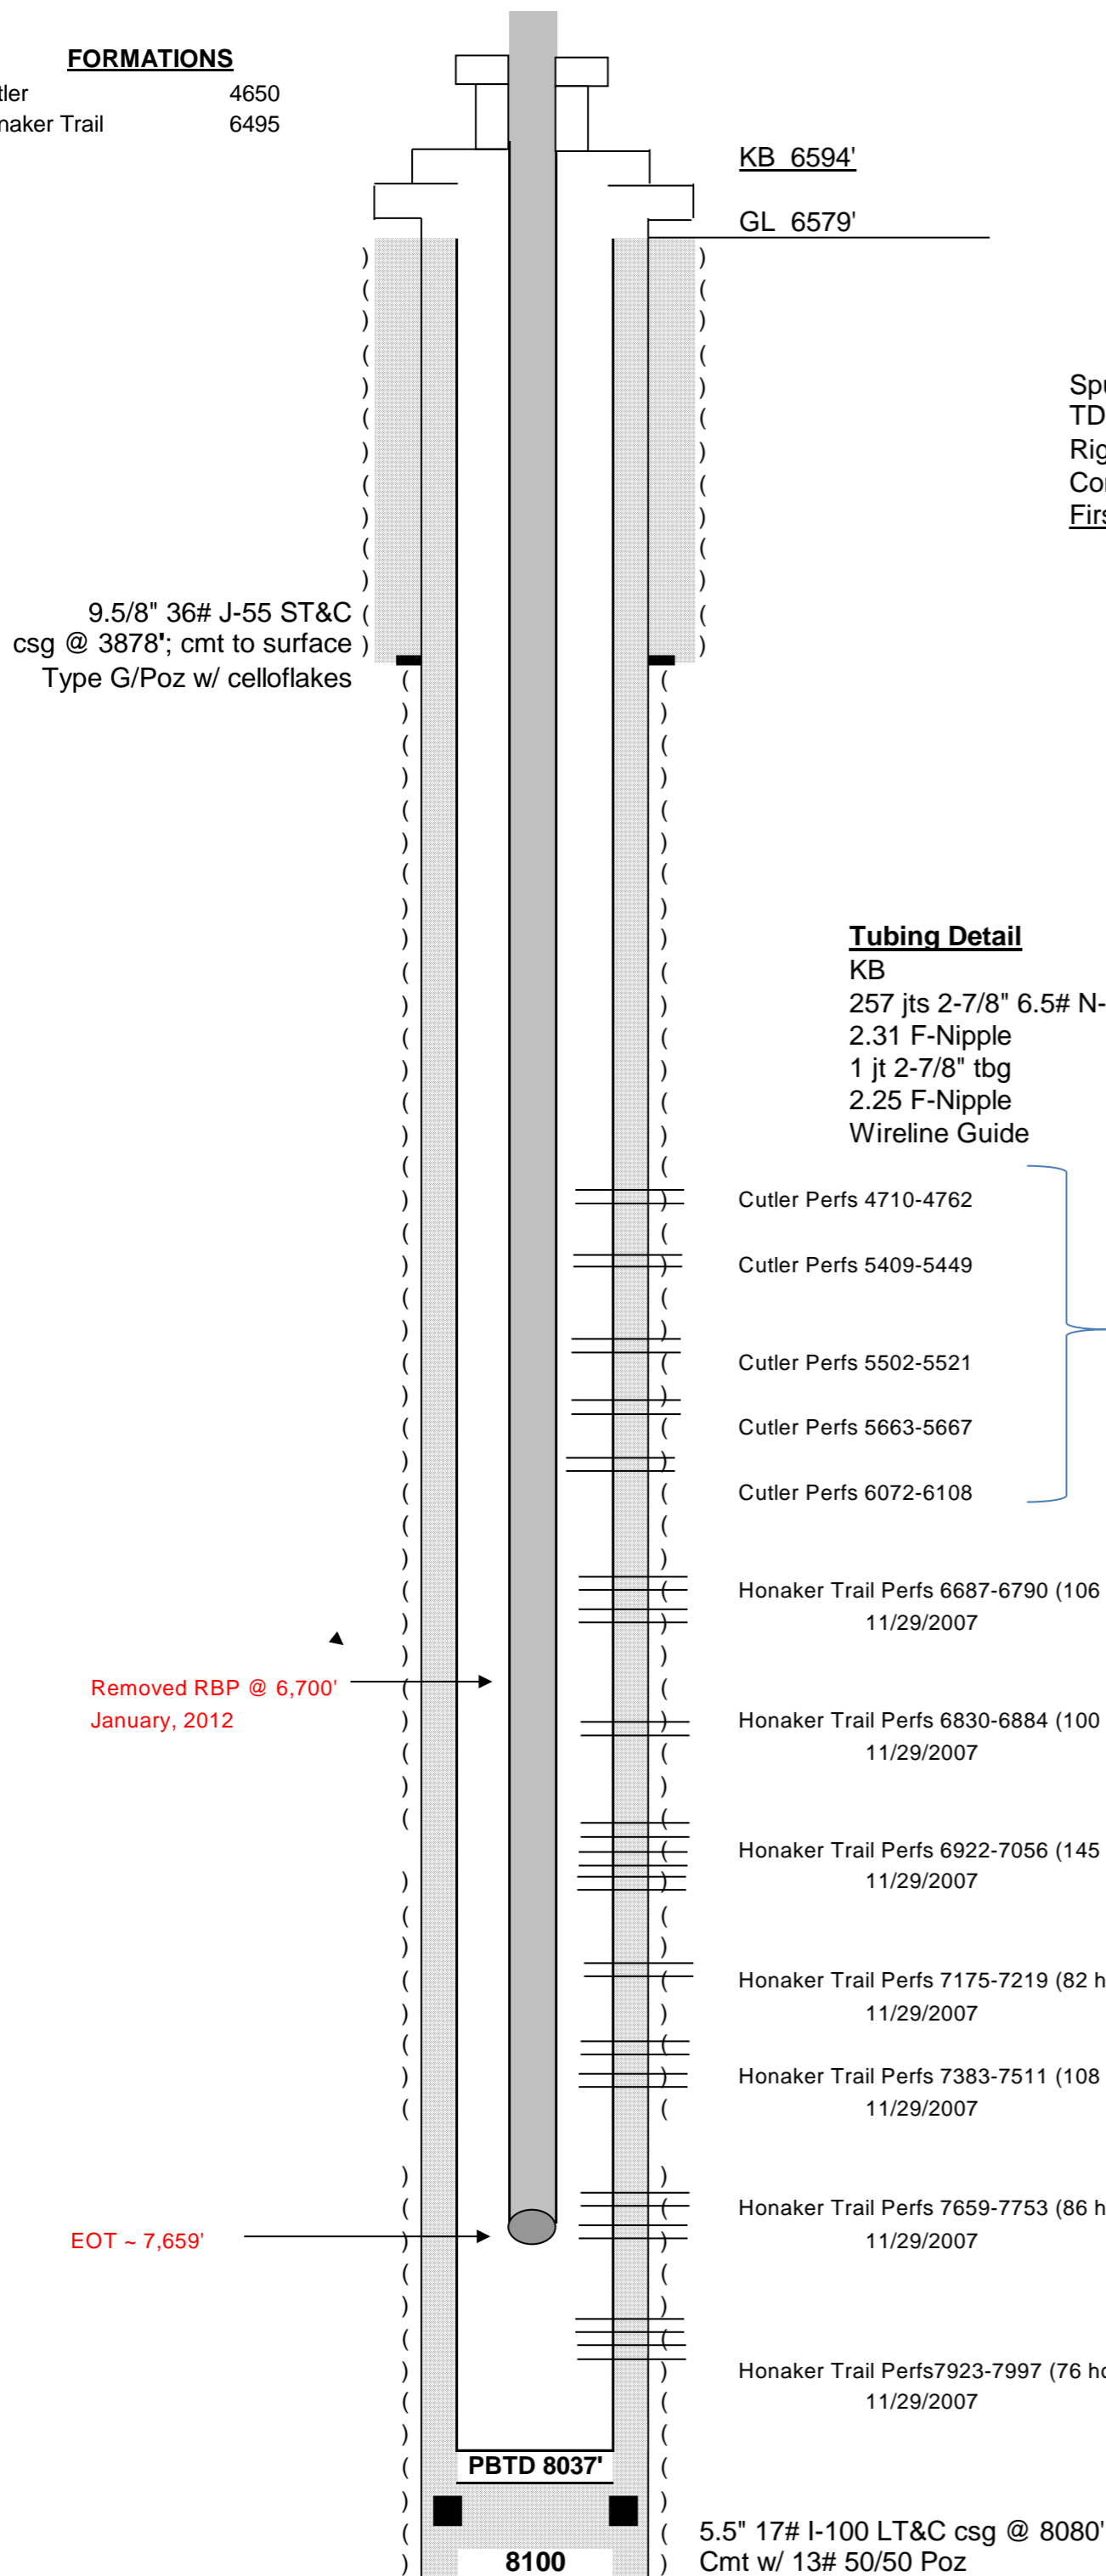

Well History

Spud Date
 TD Reached
 Rig Released
 Completion Date
 First Sales:

Tubing Detail

KB
 257 jts 2-7/8" 6.5# N-80 new tbg
 2.31 F-Nipple
 1 jt 2-7/8" tbg
 2.25 F-Nipple
 Wireline Guide

Depth

Cutler Perfs 4710-4762
 Cutler Perfs 5409-5449
 Cutler Perfs 5502-5521
 Cutler Perfs 5663-5667
 Cutler Perfs 6072-6108
 Honaker Trail Perfs 6687-6790 (106 holes)
 11/29/2007
 Honaker Trail Perfs 6830-6884 (100 holes)
 11/29/2007
 Honaker Trail Perfs 6922-7056 (145 holes)
 11/29/2007
 Honaker Trail Perfs 7175-7219 (82 holes)
 11/29/2007
 Honaker Trail Perfs 7383-7511 (108 holes)
 11/29/2007
 Honaker Trail Perfs 7659-7753 (86 holes)
 11/29/2007
 Honaker Trail Perfs 7923-7997 (76 holes)
 11/29/2007

Perforated and completed approximately April 2009

Removed RBP @ 6,700'
 January, 2012

EOT ~ 7,659'

PBT 8037'

8100

5.5" 17# I-100 LT&C csg @ 8080'
 Cmt w/ 13# 50/50 Poz