


WEXPRO COMPANY
AS-BUILT SITE PLAN FOR
STATE OF COLORADO #1
SECTION 16, T11N, R97W, 6th P.M.
NE 1/4 NE 1/4

FIGURE #1
SCALE: 1" = 50'
DATE: 07-12-12
DRAWN BY: J.M.H.

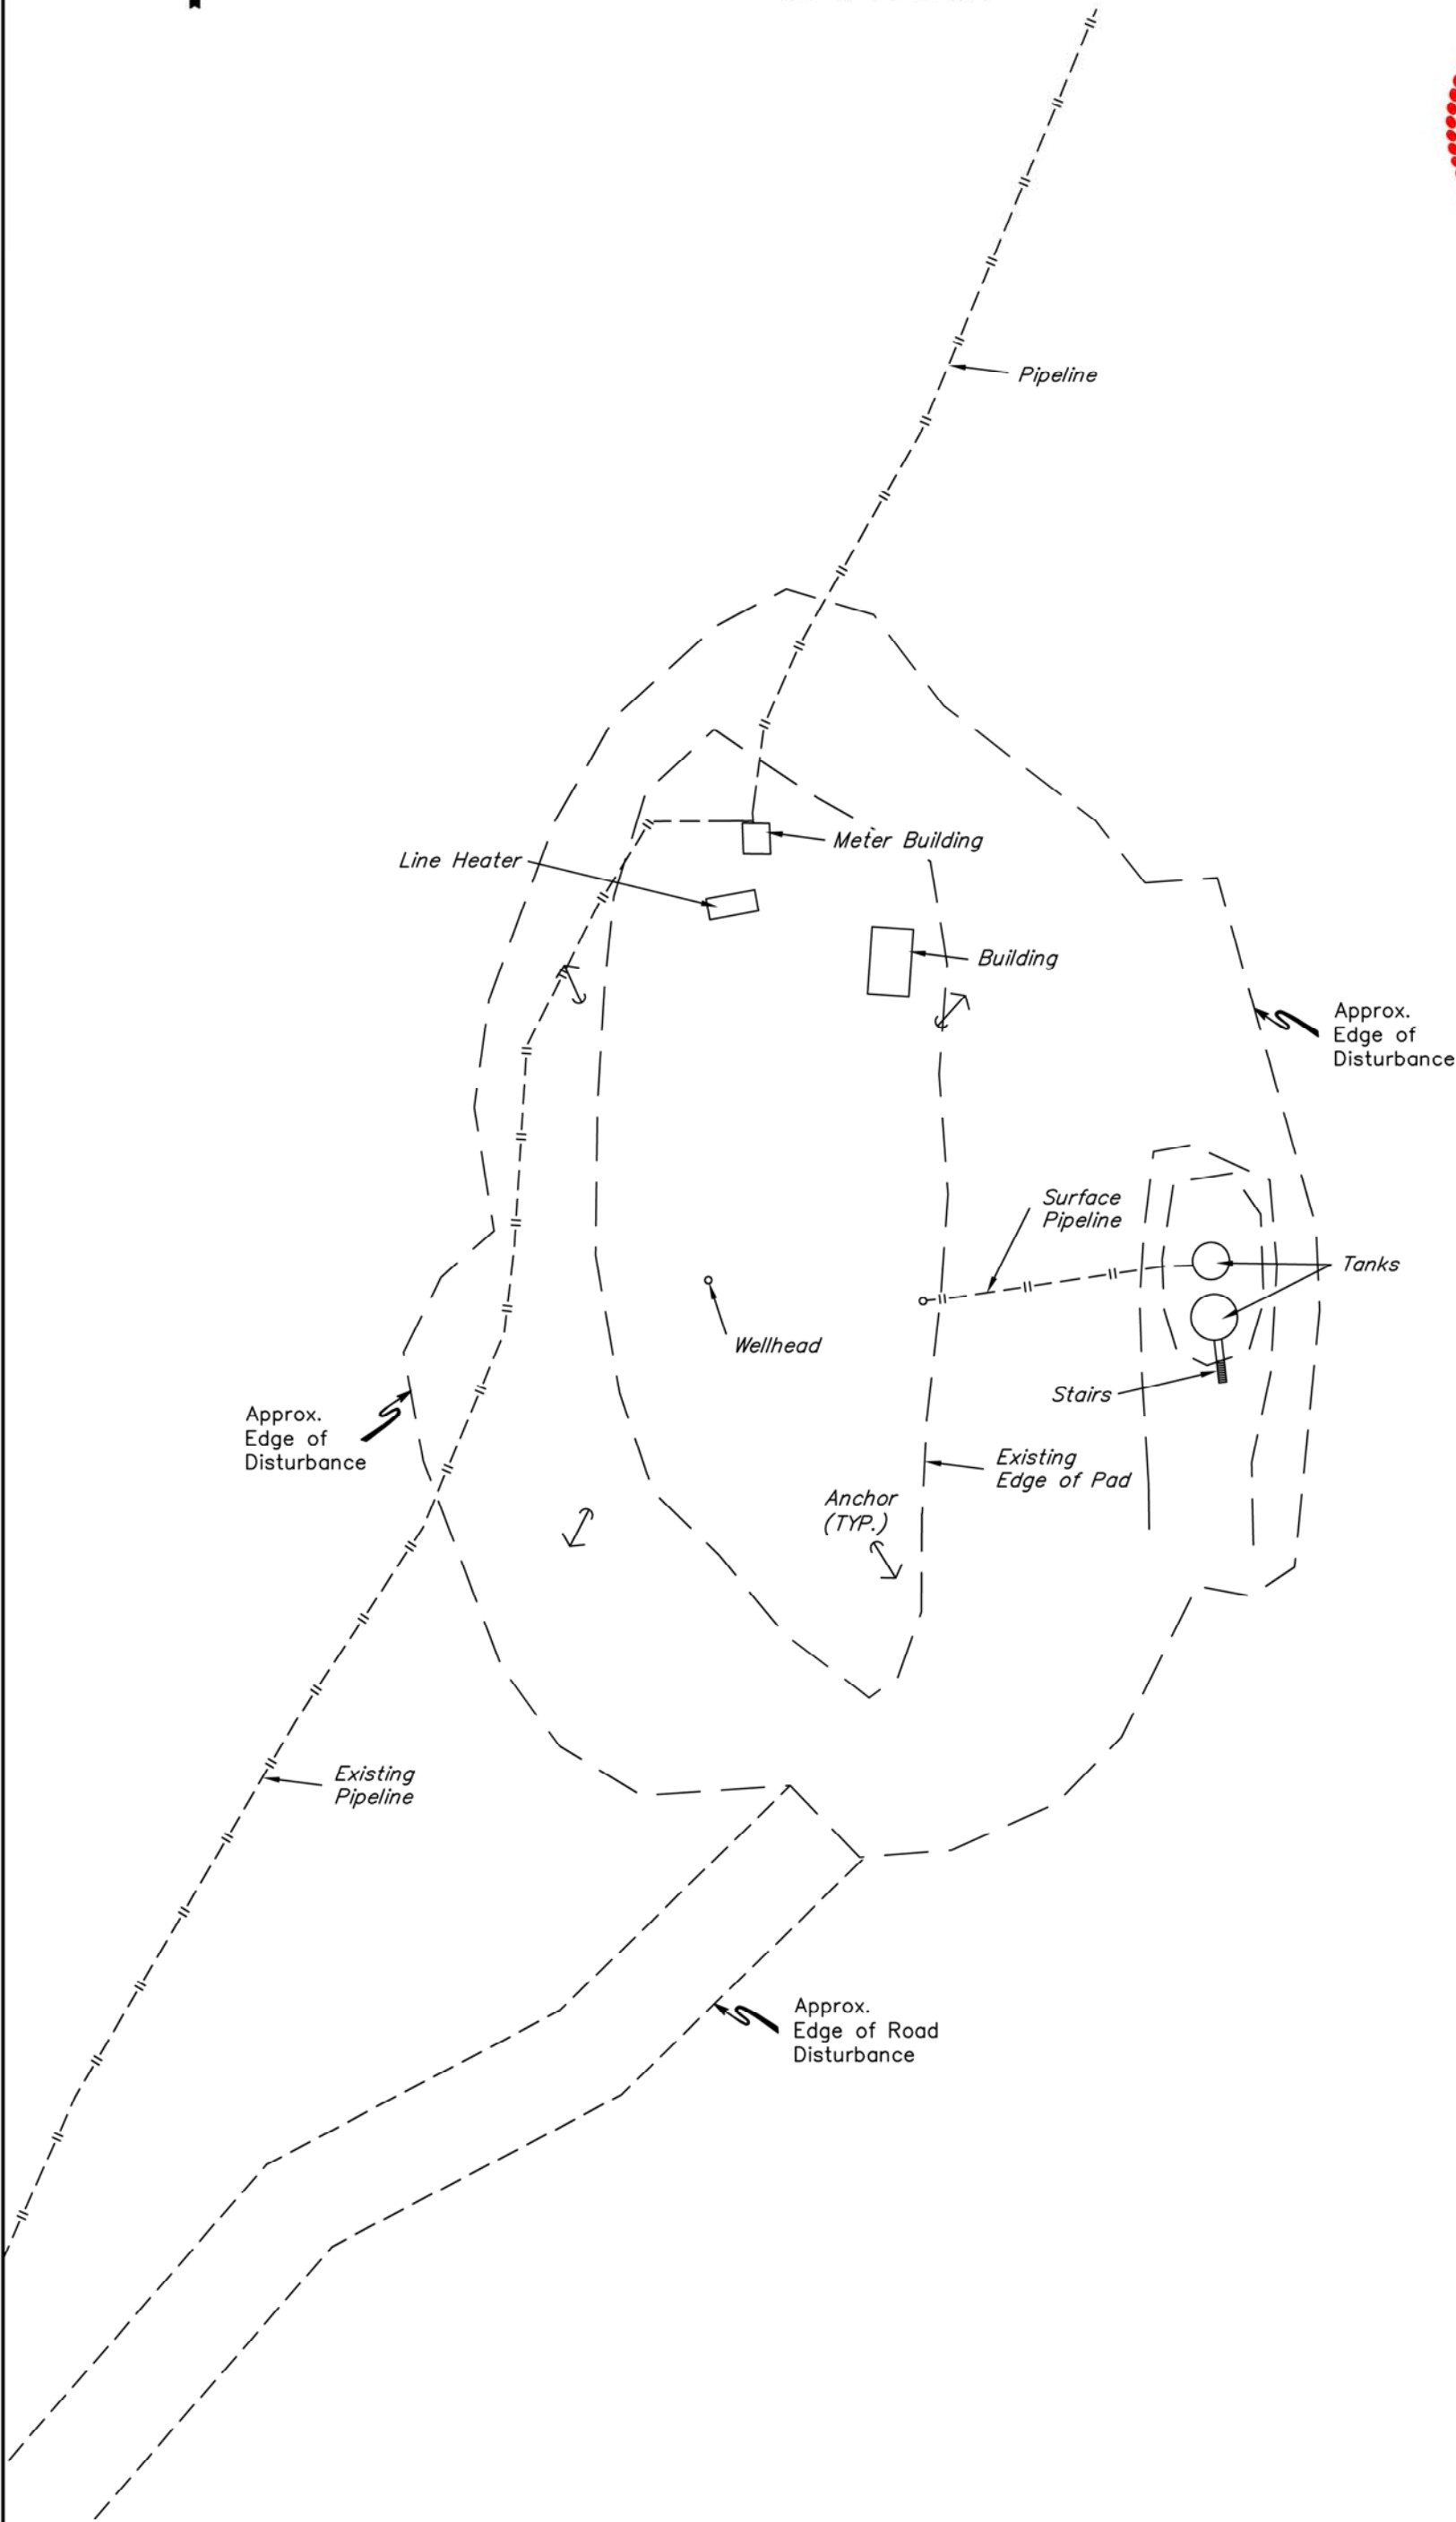

FINISHED GRADE ELEV. AT LOC. STAKE = 6827.4'

▲ = SECTION CORNERS LOCATED.

Set Marked Stone,
File of Stones 7,
Lat: 40.913300°
Long: 108.260178°

N89°36'15"E - 2642.64' (Meas.)

Set Marked Stone
Lat: 40.926600°
Long: 108.267078°

WEXPRO COMPANY

AS-BUILT SURFACE USE
AREA & ROAD RIGHT-OF-WAY
DISTURBANCE
ON BLM LANDS

(For STATE OF COLORADO #1)

LOCATED IN
SECTIONS 15 & 16, T11N, R97W, 6th P.M.,
MOFFAT COUNTY, COLORADO

BASIS OF BEARINGS

BASIS OF BEARINGS IS A G.P.S. OBSERVATION.

LINE	DIRECTION	LENGTH	LINE	DIRECTION	LENGTH
L1	N85°56'14"E	20.79'	L28	S38°45'20"E	22.88'
L2	S15°46'53"E	105.37'	L29	S43°38'56"W	91.03'
L3	S02°31'07"E	24.35'	L30	S28°58'19"W	88.05'
L4	S05°34'25"W	75.05'	L31	S28°58'19"W	140.15'
L5	S57°18'25"W	15.16'	L32	S27°48'45"W	379.25'
L6	N79°32'12"W	15.89'	L33	S30°33'53"W	143.95'
L7	S26°29'07"W	49.14'	L34	S43°41'48"W	109.32'
L8	S42°21'16"W	24.86'	L35	S69°07'55"W	80.43'
L9	S66°00'26"W	35.86'	L36	N84°21'23"W	79.88'
L10	S83°46'29"W	26.07'	L37	N57°52'36"W	76.18'
L11	N44°18'10"W	30.00'	L38	N40°07'52"W	107.59'
L12	S86°12'32"W	43.28'	L39	N30°10'57"W	70.84'
L13	N58°49'44"W	27.68'	L40	N16°42'28"W	139.46'
L14	N36°38'06"W	28.04'	L41	N06°24'56"W	64.07'
L15	N20°49'34"W	64.55'	L42	N02°43'34"E	105.53'
L16	N10°20'27"W	32.15'	L43	N65°48'54"W	45.95'
L17	N26°36'49"E	24.33'	L44	S40°48'24"W	42.04'
L18	N48°40'39"E	20.49'	L45	S16°27'21"W	83.59'
L19	N09°03'40"W	36.41'	L46	S39°18'05"W	68.15'
L20	N07°52'33"E	31.70'	L47	N81°11'34"W	37.65'
L21	N20°14'10"E	55.05'	L48	N31°16'33"W	62.97'
L22	N30°04'06"E	35.09'	L49	N07°45'21"W	97.91'
L23	N47°50'04"E	39.14'	L50	N06°50'42"E	156.82'
L24	N62°28'56"E	23.32'	L51	N41°05'35"E	113.28'
L25	S73°38'14"E	26.46'	L52	N62°18'05"E	95.56'
L26	S37°33'42"E	33.36'	L53	N45°41'50"E	95.64'
L27	S52°51'34"E	55.27'			

END OF AS-BUILT ROAD
RIGHT-OF-WAY
DISTURBANCE
STA. 25+75.69
(At Surface Use
Area Disturbance)

Existing Pipeline
See Detail "A"
Below

BEGINNING OF AS-BUILT
ROAD DISTURBANCE
STA. 0+00
(At Existing Road)

AS-BUILT ROAD
RIGHT-OF-WAY
DISTURBANCE FOR
STATE OF COLORADO #1
Contains 1.774 Acres, More or Less

BLM
Lands

1/4 Section Line

Sec. 16

SW 1/4

AS-BUILT SURFACE USE AREA
DISTURBANCE DESCRIPTION

BEGINNING AT A POINT IN THE NE 1/4 NE 1/4 OF SECTION 16, T11N, R97W, 6th P.M. WHICH BEARS S45°13'17"W 911.62' FROM THE NORTHEAST CORNER OF SAID SECTION 16, THENCE N85°56'14"E 20.79'; THENCE S15°46'53"E 105.37'; THENCE S02°31'07"E 24.35'; THENCE S05°34'25"W 75.05'; THENCE S57°18'25"W 15.16'; THENCE N79°32'12"W 15.89'; THENCE S26°29'07"W 49.14'; THENCE S42°21'16"W 24.66'; THENCE S66°00'26"W 35.86'; THENCE S83°46'29"W 26.07'; THENCE N44°18'10"W 30.00'; THENCE S86°12'32"W 43.28'; THENCE N58°49'44"W 27.68'; THENCE N36°38'06"W 28.04'; THENCE N20°49'34"W 64.55'; THENCE N10°20'27"W 32.15'; THENCE N26°36'49"E 24.33'; THENCE N48°40'39"E 20.49'; THENCE N09°03'40"W 36.41'; THENCE N07°52'33"E 31.70'; THENCE N20°14'10"E 55.05'; THENCE N30°04'06"E 35.09'; THENCE N47°50'04"E 39.14'; THENCE N62°28'56"E 23.32'; THENCE S73°38'14"E 26.46'; THENCE S37°33'42"E 33.36'; THENCE S52°51'34"E 55.27'; THENCE S38°45'20"E 22.88' TO THE POINT OF BEGINNING. BASIS OF BEARINGS IS A G.P.S. OBSERVATION. CONTAINS 1.602 ACRES MORE OR LESS.

AS-BUILT ROAD RIGHT-OF-WAY
DISTURBANCE DESCRIPTION

A 30' WIDE RIGHT-OF-WAY 15' ON EACH SIDE OF THE FOLLOWING DESCRIBED CENTERLINE.

BEGINNING AT A POINT IN THE NW 1/4 NW 1/4 OF SECTION 15, T11N, R97W, 6th P.M. WHICH BEARS S05°34'43"E 941.29' FROM THE NORTHEAST CORNER OF SAID SECTION 15, THENCE S43°38'56"W 91.03'; THENCE S26°58'19"W 88.05' TO A POINT ON THE WEST LINE OF THE NW 1/4 NW 1/4 OF SAID SECTION 15, WHICH BEARS S00°35'48"W 1081.22' FROM THE NORTHEAST CORNER OF SAID SECTION 15; THENCE S26°58'19"W 140.15'; THENCE S27°48'45"W 379.25'; THENCE S30°33'53"W 143.95'; THENCE S43°41'49"W 109.32'; THENCE S69°07'55"W 80.43'; THENCE N84°21'23"W 79.88'; THENCE N57°52'36"W 76.18'; THENCE N40°07'52"W 107.59'; THENCE N30°10'57"W 70.84'; THENCE N16°42'29"W 139.46'; THENCE N06°24'56"W 64.07'; THENCE N02°43'34"E 105.93'; THENCE N65°48'54"W 45.95'; THENCE S40°48'24"W 42.04'; THENCE S16°27'21"W 83.59'; THENCE S39°18'06"W 68.15'; THENCE N81°11'34"W 37.65'; THENCE N31°16'33"W 62.97'; THENCE N07°45'21"W 97.91'; THENCE N06°50'42"E 156.82'; THENCE N45°41'50"E 95.64' TO A POINT IN THE NE 1/4 NE 1/4 SECTION 16, T11N, R97W th P.M., WHICH BEARS S38°57'21"W 1176.97' FROM THE NORTHEAST CORNER OF SAID SECTION 16. THE SIDE LINES OF SAID DESCRIBED RIGHT-OF-WAY BEING SHORTENED OR ELONGATED TO MEET THE GRANTOR'S PROPERTY LINES. BASIS OF BEARINGS IS A G.P.S. OBSERVATION. CONTAINS 1.774 ACRES MORE OR LESS.

POB #1 BEARS S44°21'14"W 895.97' FROM THE NORTHEAST CORNER OF SECTION 16, T11N, R97W, 6th P.M.

BEGINNING AT STA. 0+00 BEARS S05°34'43"E 941.29' FROM THE NORTHEAST CORNER OF SECTION 15, T11N, R97W, 6th P.M.

P.O.S.L. STA. 1+79.07 BEARS S00°35'48"W 1081.22' FROM THE NORTHEAST CORNER OF SECTION 15, T11N, R97W, 6th P.M.

ENDING AT STA. 25+75.69 BEARS S38°57'21"W 1176.97' FROM THE NORTHEAST CORNER OF SECTION 15, T11N, R97W, 6th P.M.



CERTIFICATE

THIS IS TO CERTIFY THAT THE ABOVE PLAT WAS PREPARED FROM THE SURVEY MADE BY ME OR UNDER MY SUPERVISION AND THAT THE SAME ARE TRUE AND CORRECT TO THE BEST OF MY KNOWLEDGE AND BELIEF.

REGISTERED LAND SURVEYOR
REGISTRATION NO. 17442
STATE OF COLORADO
6952312

UINTAH ENGINEERING & LAND SURVEYING
85 SOUTH - 200 EAST • (435) 789-1017
VERNAL, UTAH - 84078

SCALE
1" = 300'

PARTY
G.O. S.R. J.M.H.

WEATHER
HOT

DATE
07-12-12

REFERENCES
G.L.O. PLAT

FILE
3 2 8 2 0

AS-BUILT SURFACE
USE AREA DISTURBANCE
STATE OF COLORADO #1
Contains 1.602 Acres, More or Less

Detail "A"
No Scale

AS-BUILT
ROAD
DISTURBANCE

▲ = SECTION CORNERS LOCATED.

WEXPRO COMPANY


AS-BUILT PIPELINE
RIGHT-OF-WAY DISTURBANCE
ON BLM LANDS

(For STATE OF COLORADO #1)

LOCATED IN
SECTIONS 9, 10 & 16, T11N, R97W, 6th P.M.,
MOFFAT COUNTY, COLORADO

BASIS OF BEARINGS

BASIS OF BEARINGS IS A G.P.S. OBSERVATION.

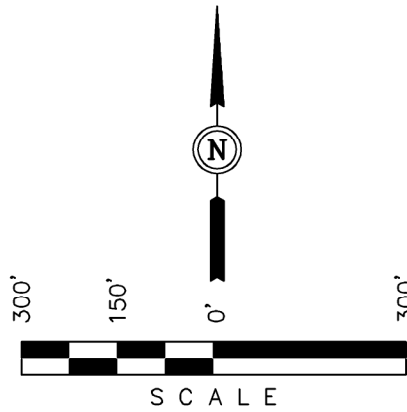

AS-BUILT PIPELINE RIGHT-OF-WAY
DISTURBANCE DESCRIPTION

A 20' WIDE RIGHT-OF-WAY 5' ON LEFT SIDE AND 15' ON RIGHT SIDE
OF THE FOLLOWING DESCRIBED CENTERLINE.

BEGINNING AT A POINT IN THE NE 1/4 NE 1/4 OF SECTION 16, T11N, R97W, 6th P.M., WHICH BEARS S50°37'40"W 984.65' FROM THE NORTHEAST CORNER OF SAID SECTION 16, THENCE N14°35'01"E 53.44'; THENCE N29°43'48"E 70.81'; THENCE N22°31'30"E 164.49'; THENCE N15°47'05"E 174.26'; THENCE N11°04'43"E 144.55'; THENCE N22°54'01"E 50.04' TO A POINT ON THE NORTH LINE OF THE NE 1/4 NE 1/4 OF SAID SECTION 16, WHICH BEARS S89°36'15"W 554.95' FROM THE NORTHEAST CORNER OF SAID SECTION 16, THENCE N22°54'01"E 207.72'; THENCE N02°39'07"E 145.38'; THENCE N12°59'37"E 400.86'; THENCE N14°18'57"E 211.29'; THENCE N11°57'34"E 361.01'; THENCE N14°34'55"E 220.31'; THENCE N12°42'43"E 175.50'; THENCE N13°41'59"E 688.37' TO A POINT ON THE EAST LINE OF THE NE 1/4 SE 1/4 OF SECTION 9, T11N, R97W, 6th P.M., WHICH BEARS N00°10'11"E 2334.46' FROM THE SOUTHEAST CORNER OF SAID SECTION 9, THENCE N13°41'59"E 99.06'; THENCE N10°56'46"E 232.83'; THENCE N24°50'24"E 8.04' TO A POINT IN THE SW 1/4 NW 1/4 OF SECTION 10, T11N, R97W, 6th P.M., WHICH BEARS N80°48'14"E 60.78' FROM THE WEST 1/4 CORNER OF SAID SECTION 10. THE SIDE LINES OF SAID DESCRIBED RIGHT-OF-WAY BEING SHORTENED OR ELONGATED TO MEET THE GRANTOR'S PROPERTY LINES. BASIS OF BEARINGS IS A G.P.S. OBSERVATION. CONTAINS 1.565 ACRES MORE OR LESS.

BEGINNING AT STA. 0+00 BEARS S50°37'40"W 984.65' FROM THE NORTHEAST CORNER OF SECTION 16, T11N, R97W, 6th P.M.

P.O.S.L. STA. 6+57.59 BEARS S89°36'15"W 554.95' FROM THE NORTHEAST CORNER OF SECTION 16, T11N, R97W, 6th P.M.

P.O.S.L. STA. 31+06.49 BEARS S00°23'13"W 285.05' FROM THE EAST 1/4 CORNER OF SECTION 9, T11N, R97W, 6th P.M.

ENDING AT STA. 34+21.99 BEARS N80°48'14"E 60.78' FROM THE WEST 1/4 CORNER OF SECTION 10, T11N, R97W, 6th P.M.

CERTIFICATE

THIS IS TO CERTIFY THAT THE ABOVE PLAT WAS PREPARED FROM
FIELD NOTES OF ACTUAL SURVEYS MADE BY ME OR UNDER MY DIRECT
SUPERVISION AND THAT THE SAME ARE TRUE AND CORRECT TO
THE BEST OF MY KNOWLEDGE AND BELIEF.

REGISTERED LAND SURVEYOR
REGISTRATION NO. 17482
STATE OF COLORADO

UINTAH ENGINEERING & LAND SURVEYING
85 SOUTH - 200 EAST • (435) 789-1017
VERNAL, UTAH - 84078

SCALE 1" = 300'	DATE 07-12-12
PARTY G.O. S.R. J.M.H.	REFERENCES G.L.O. PLAT
WEATHER HOT	FILE 3 2 8 2 1

