


PAD 596-35D

SCALE: 1"= 100'
CONTOUR
INTERVAL 2'

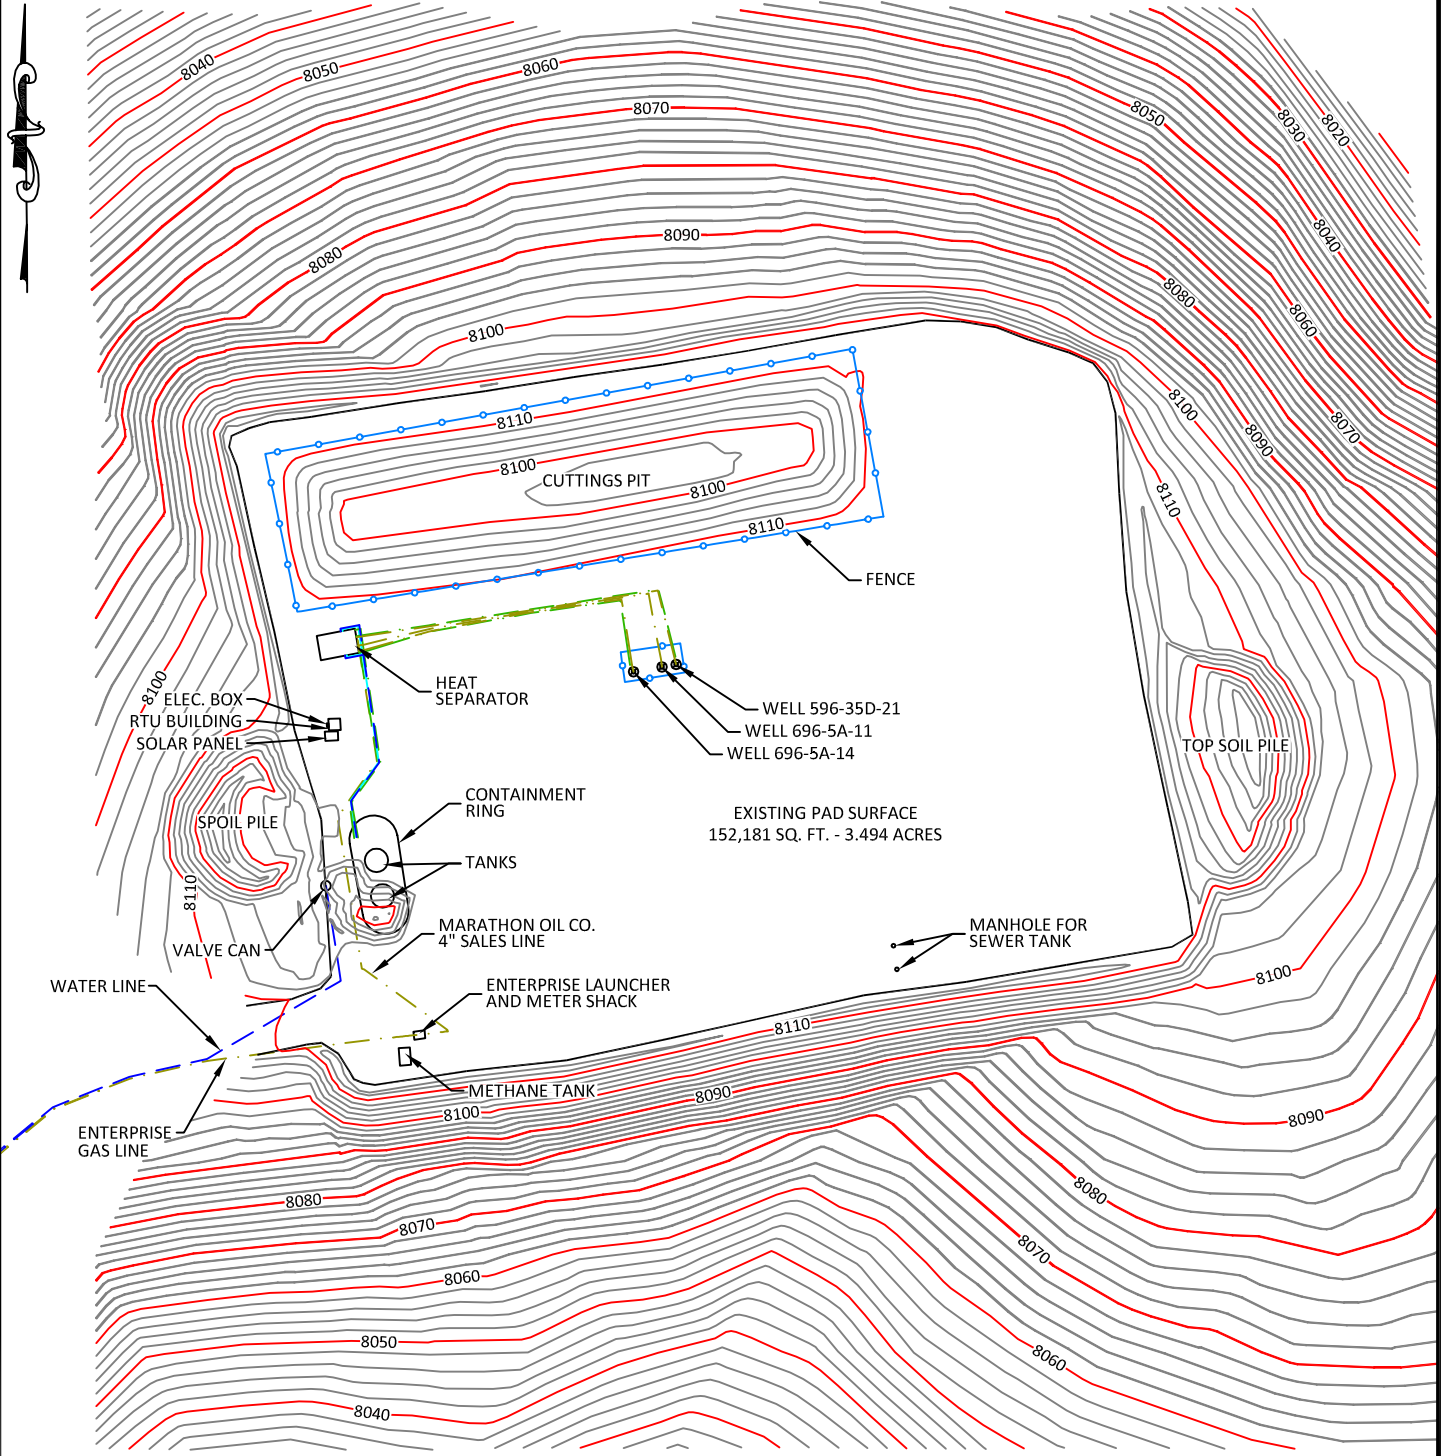

CONFIDENTIALITY NOTES:

The information contained in this plat is legally privileged and confidential information intended only for the use of the recipients. If you are not the intended recipients, you are hereby notified that any use, dissemination, distribution or copying of this information is strictly prohibited.



**WILLIAM H. SMITH
& ASSOCIATES P.C.**

SURVEYING CONSULTANTS
550 EAST SECOND NORTH PHONE: 307-875-3638
GREEN RIVER, WY 307-875-3639
www.whsmithpc.com

DRAWN BY: JSJ

CHECKED BY: WHD

JOB NO: 26099

PROJECT NO: N/A

REVISIONS:

LEGEND

- GAS LINES
- WATER LINES
- CONDENSATE LINES
- GLYCOL LINES
- ELECTRIC LINES

LOCATION:

596-35D
WITHIN THE SE/4
SECTION 35,
T 5 S, R 96 W,
6TH PM.
GARFIELD COUNTY,
COLORADO

MARATHON OIL COMPANY
PO BOX 3128, HOUSTON TX, 77253
5555 SAN FELIPE, HOUSTON TX, 77056

AS-BUILT PAD

SCALE: 1"=100'


DATE: 09/12/2011

EXHIBIT "A"

SHEET 1 OF 3

PAD 596-35D

SCALE: 1"= 100'
CONTOUR
INTERVAL 2'

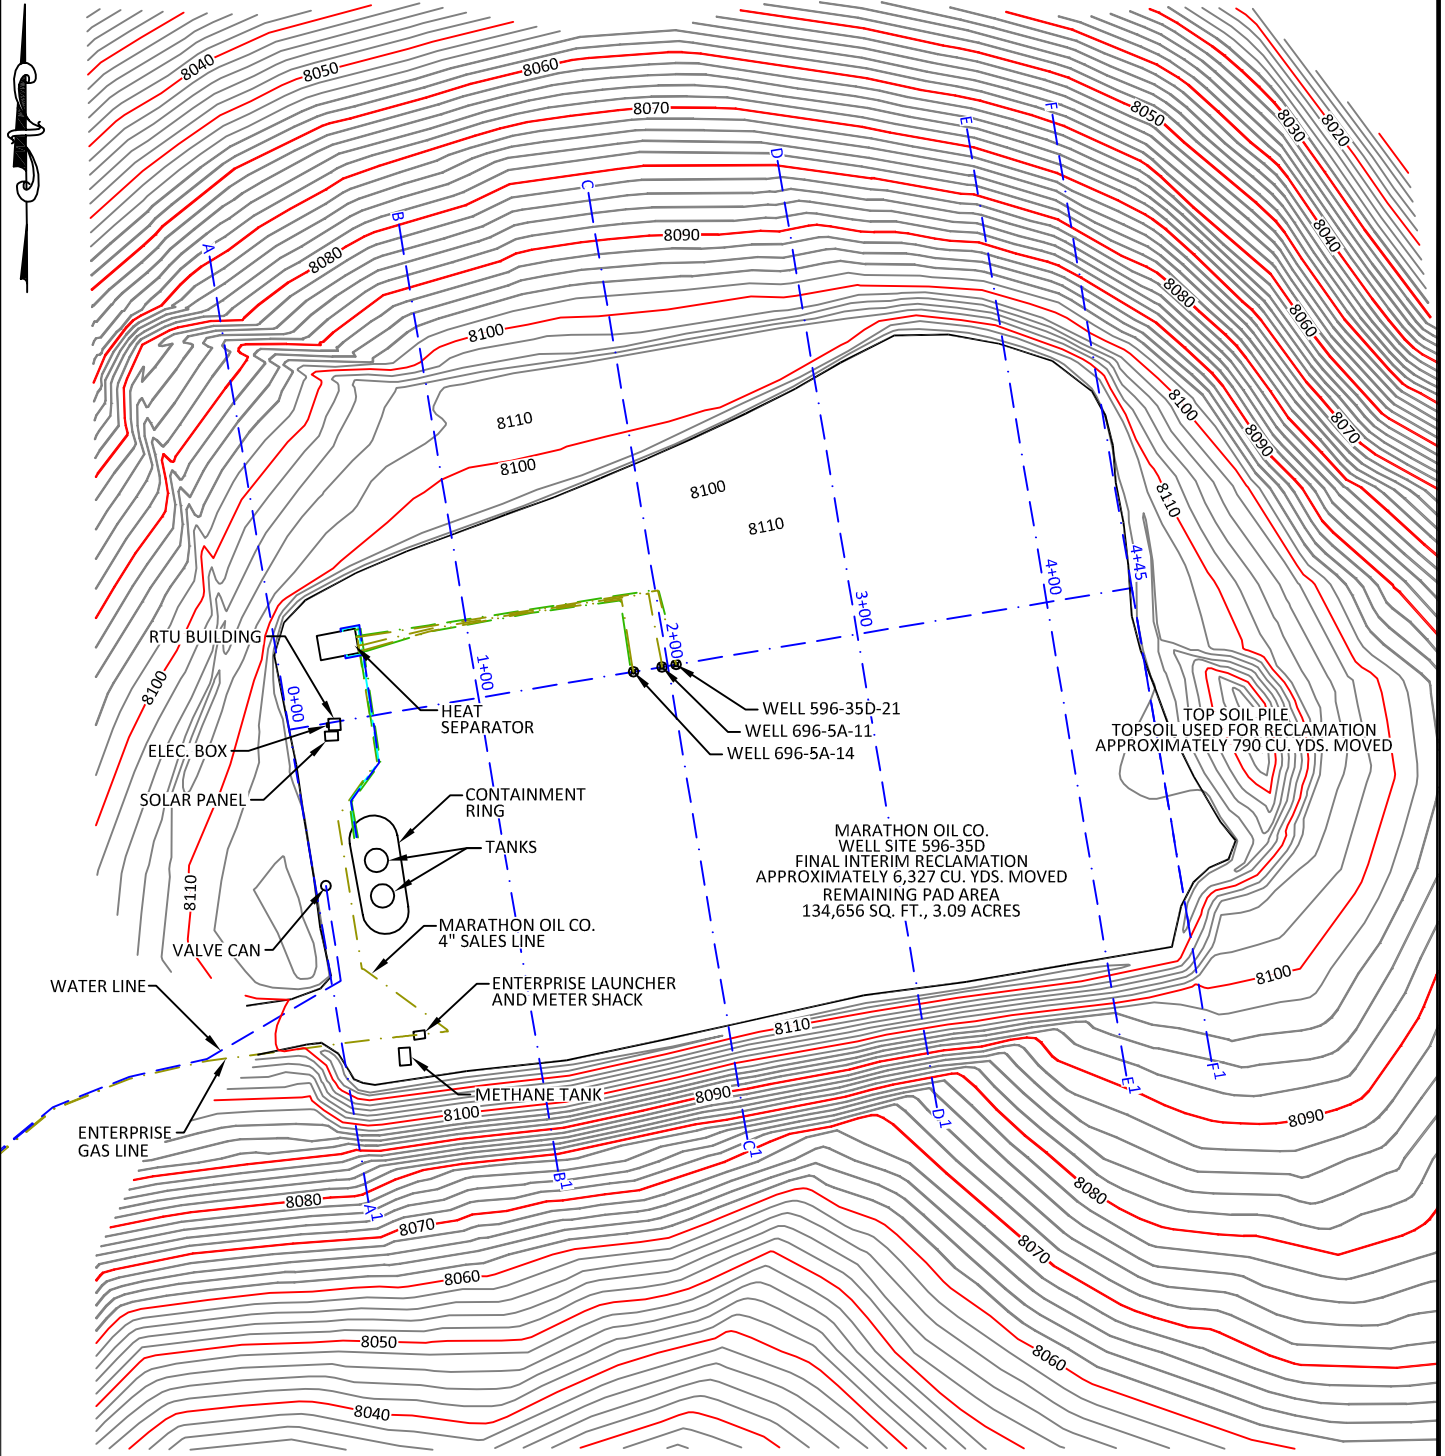

CONFIDENTIALITY NOTES:

The information contained in this plat is legally privileged and confidential information intended only for the use of the recipients. If you are not the intended recipients, you are hereby notified that any use, dissemination, distribution or copying of this information is strictly prohibited.



**WILLIAM H. SMITH
& ASSOCIATES P.C.**

SURVEYING CONSULTANTS

550 EAST SECOND NORTH PHONE: 307-875-3638
GREEN RIVER, WY 307-875-3639
www.whsmithpc.com

DRAWN BY: JSJ

CHECKED BY: WHD

JOB NO: 26099

PROJECT NO: N/A

REVISIONS:

DATA

FINAL INTERIM RECLAMATION
APPROXIMATELY 6,327 CU. YDS. MOVED

TOPSOIL USED FOR RECLAMATION
APPROXIMATELY 790 CU. YDS. MOVED

REMAINING PAD AREA
134,656 SQ. FT., 3.09 ACRES

LOCATION:

596-35D
WITHIN THE SE/4
SECTION 35,
T 5 S, R 96 W,
6TH PM.
GARFIELD COUNTY,
COLORADO

MARATHON OIL COMPANY
PO BOX 3128, HOUSTON TX, 77253
5555 SAN FELIPE, HOUSTON TX, 77056

INTERIM RECLAMATION ASBUILT


SCALE: 1"=100'

DATE: 09/12/2011

EXHIBIT "B"

SHEET 2 OF 3

PAD 596-35D

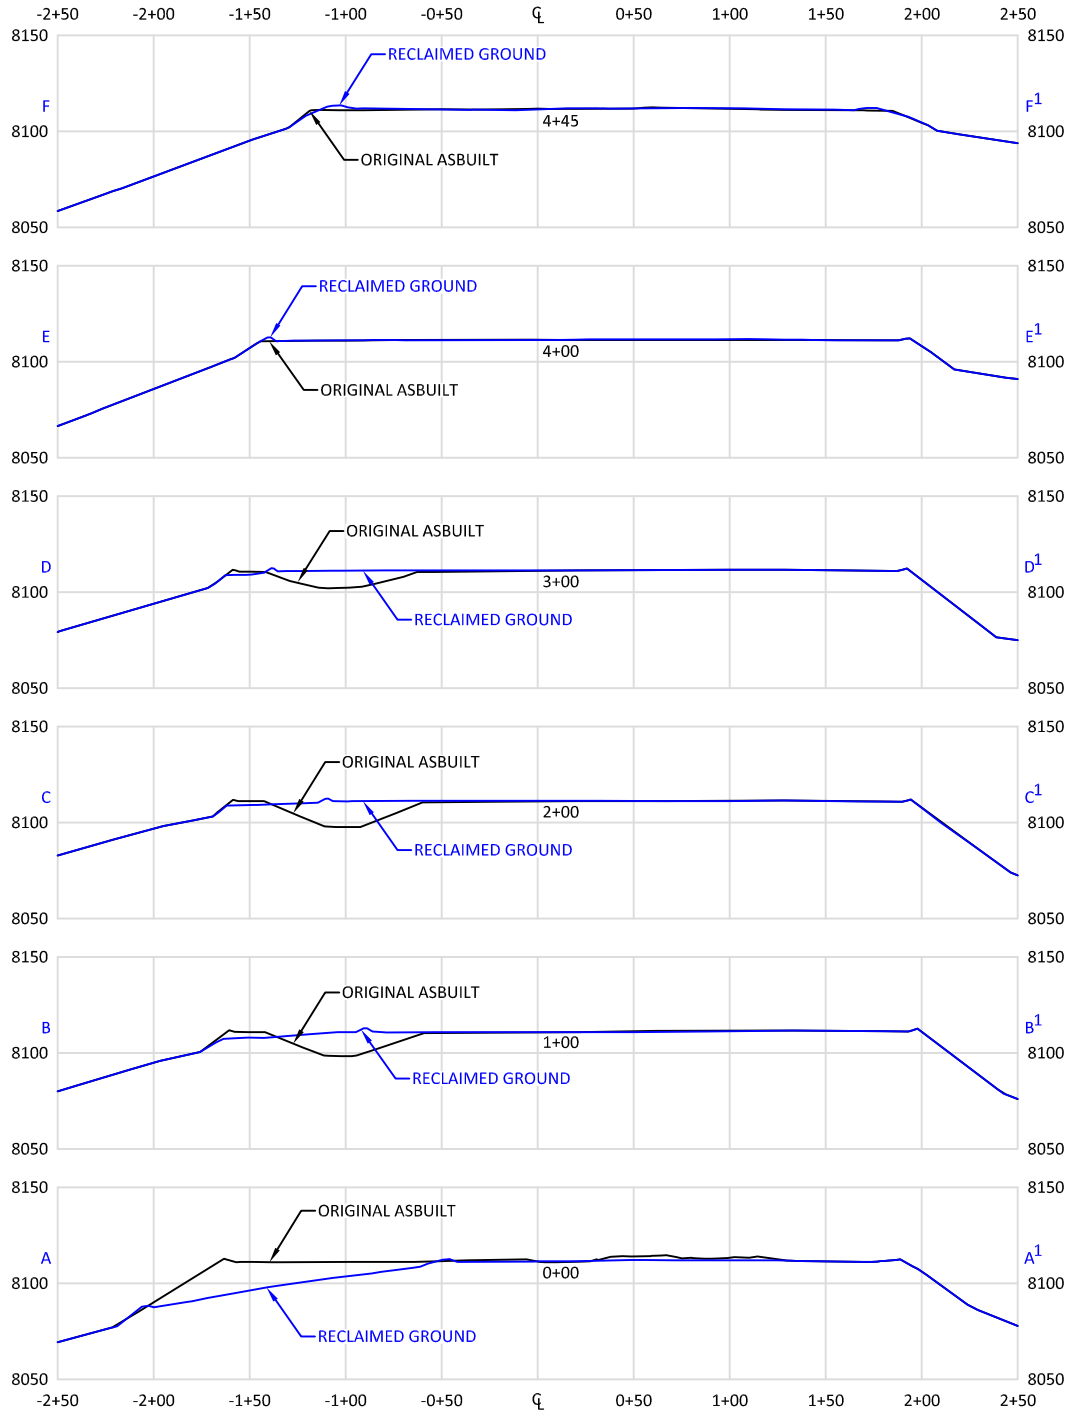

CONFIDENTIALITY NOTES:

THE INFORMATION CONTAINED IN THIS PLOT IS LEGALLY PRIVILEGED AND CONFIDENTIAL INFORMATION INTENDED ONLY FOR THE USE OF THE RECIPIENTS. IF YOU ARE NOT THE INTENDED RECIPIENTS, YOU ARE HEREBY NOTIFIED THAT ANY USE, DISSEMINATION, DISTRIBUTION OR COPYING OF THIS INFORMATION IS STRICTLY PROHIBITED.



**WILLIAM H. SMITH
& ASSOCIATES P.C.**

SURVEYING CONSULTANTS
550 EAST SECOND NORTH PHONE: 307-875-3638
GREEN RIVER, WY 307-875-3639
www.whsmithpc.com

DRAWN BY: JSJ

CHECKED BY: WHD

JOB NO: 26099

PROJECT NO: N/A

REVISIONS:

LEGEND

— ORIGINAL ASBUILT
— RECLAIMED GROUND

LOCATION:

596-35D
WITHIN THE SE/4
SECTION 35,
T 5 S, R 96 W,
6TH PM.
GARFIELD COUNTY,
COLORADO

MARATHON OIL COMPANY

P.O. BOX 3128
HOUSTON, TX 77253
5555 SAN FELIPE
HOUSTON, TX 77056

INTERIM RECLAMATION ASBUILT
CROSS SECTIONS


SCALE: 1"=100'H/100'V

DATE: 09/12/2011


EXHIBIT "C"

SHEET 3 OF 3

Receiving Waters:
Garden Gulch
1000 Feet Northeast
Tributary to Garden Gulch
1000 Feet Southeast
Garden Gulch
1100 Feet Northwest

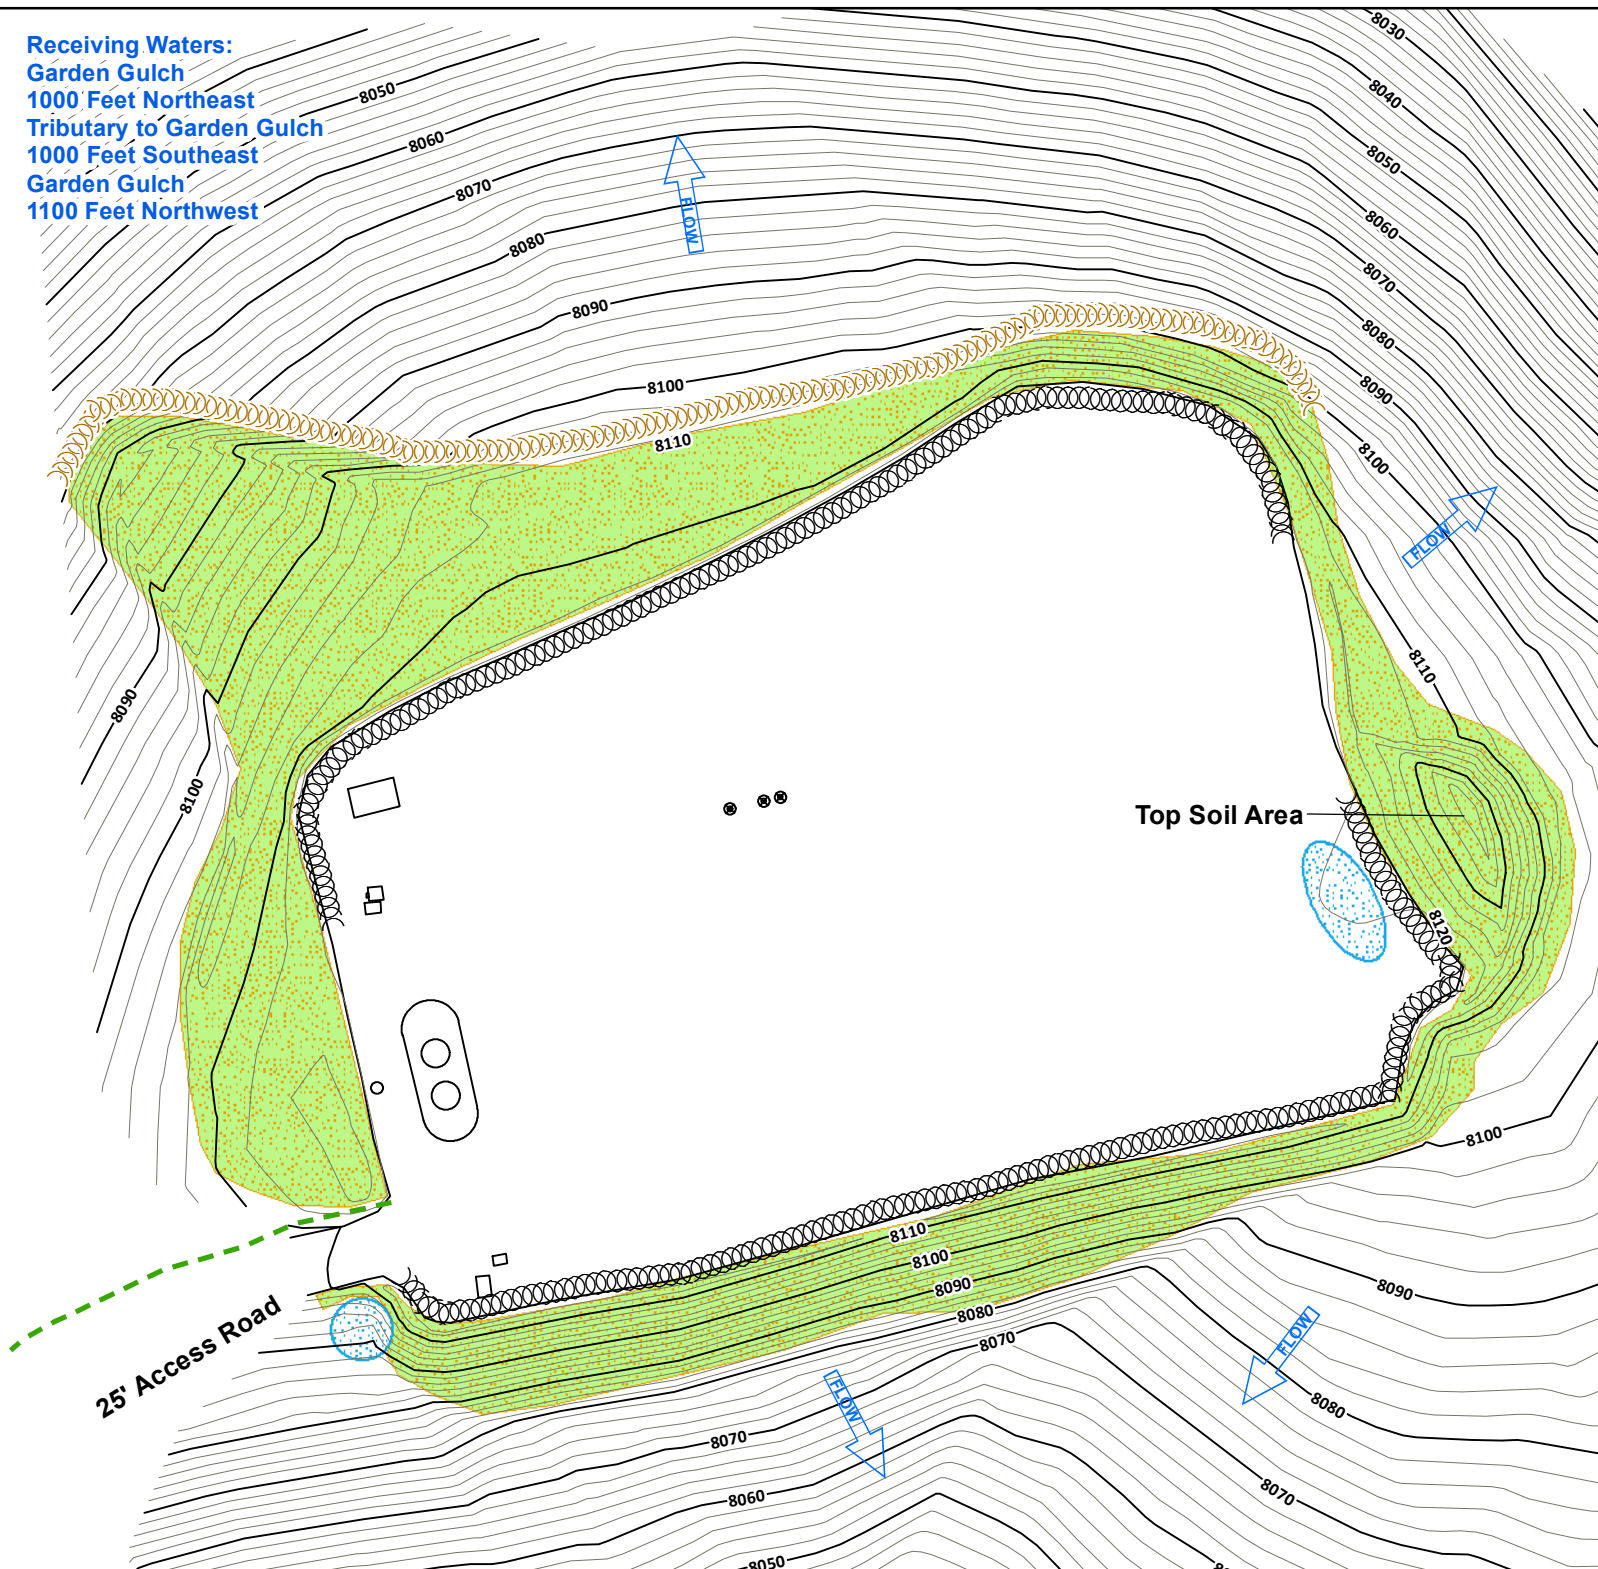


Legend

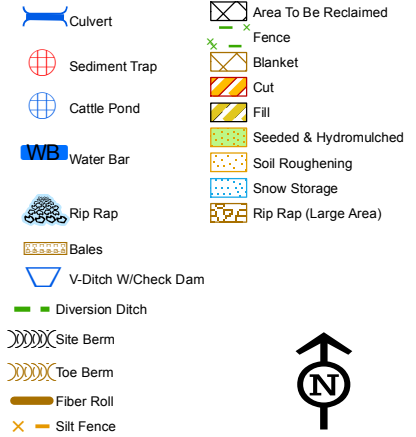


Not Present
Asphalt Or Concrete Batch Plants

Project Location

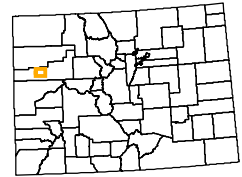

Garfield County

Map Index Overview

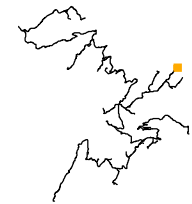

Pad Site 596-35D

Total Disturbed Area = 3.09 Acres

MARATHON OIL

REVISED	BY:	COMMENT:
3/28/2012	BJB	TEMPLATE CREATION
3/28/2012	BJB	MAP CREATION
8/27/2012	BJB	BMP REVISION
11/12/2013	BJB	BMP REVISION

















InterTech E&E, LLC
bbergstrom@cbmainc.com
M:\Projects\Marathon\Piceance\Projects\SWMP\
2013\596_35D\SWMP_596_35D_20131112.mxd


Receiving Waters:
Garden Gulch
1000 Feet Northwest

Existing Road To
Pad 596-35D

Existing Road To
Pad 696-5C


Legend

-  Culvert
-  Sediment Trap
-  Cattle Pond
-  Water Bar
-  Rip Rap
-  Bales
-  V-Ditch W/Check Dam
-  Diversion Ditch
-  Site Berm
-  Toe Berm
-  Fiber Roll
-  Silt Fence
-  Area To Be Reclaimed
-  Fence
-  Blanket
-  Cut
-  Fill
-  Seeded & Hydromulched
-  Soil Roughening
-  Snow Storage

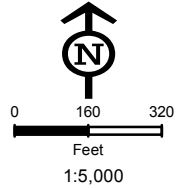


Not Present
Asphalt Or Concrete Batch Plants

Project Location

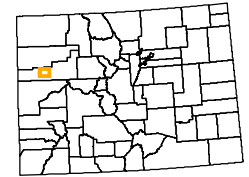

Garfield County

Map Index Overview

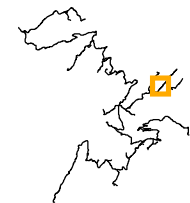

Access Road To Pad 596-35D Page 1 Of 2

Approximate Road Length = 2950 LF

MARATHON OIL

REVISED	BY:	COMMENT:
3/28/2012	BJB	MAP CREATION
8/27/2012	BJB	BMP REVISION
11/28/2012	BJB	BMP REVISION

*Detailed pad BMP's, contours, dimensions, etc.
are maintained on the individual pad diagram.



InterTech

InterTech E&E, LLC
bbergstrom@cbmainc.com
M:\Projects\Marathon\Picanceo\Projects\SWMP\
2012\596_35D\SWMP_596_35D_Road1_20121128.mxd



Receiving Waters:
Garden Gulch
1000 Feet Northwest


Pad 596-35D

20' Access Road

Existing Road To
Pad 696-5C


Legend

-  Culvert
-  Sediment Trap
-  Cattle Pond
-  Water Bar
-  Rip Rap
-  Bales
-  V-Ditch W/Check Dam
-  Diversion Ditch
-  Site Berm
-  Toe Berm
-  Fiber Roll
-  Silt Fence
-  Area To Be Reclaimed
-  Fence
-  Blanket
-  Cut
-  Fill
-  Seeded & Hydromulched
-  Soil Roughening
-  Snow Storage

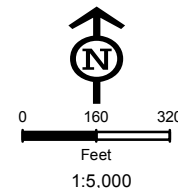

Not Present
Asphalt Or Concrete Batch Plants

Project Location

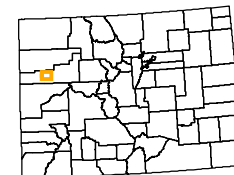

Garfield County

Map Index Overview



Access Road To Pad 596-35D Page 2 Of 2

Approximate Road Length = 4,100 LF

MARATHON OIL

REVISED	BY:	COMMENT:
3/28/2012	BJB	TEMPLATE CREATION
3/28/2012	BJB	MAP CREATION
5/8/2012	BJB	BMP REVISION
8/27/2012	BJB	BMP REVISION



InterTech E&E, LLC
bbergstrom@ctmainc.com
M:\Projects\Marathon\Peaceof\Projects\SWMP\2012\596_35D\SWMP_596_35D_Road2_20120827.mxd