


PAD 697-12A

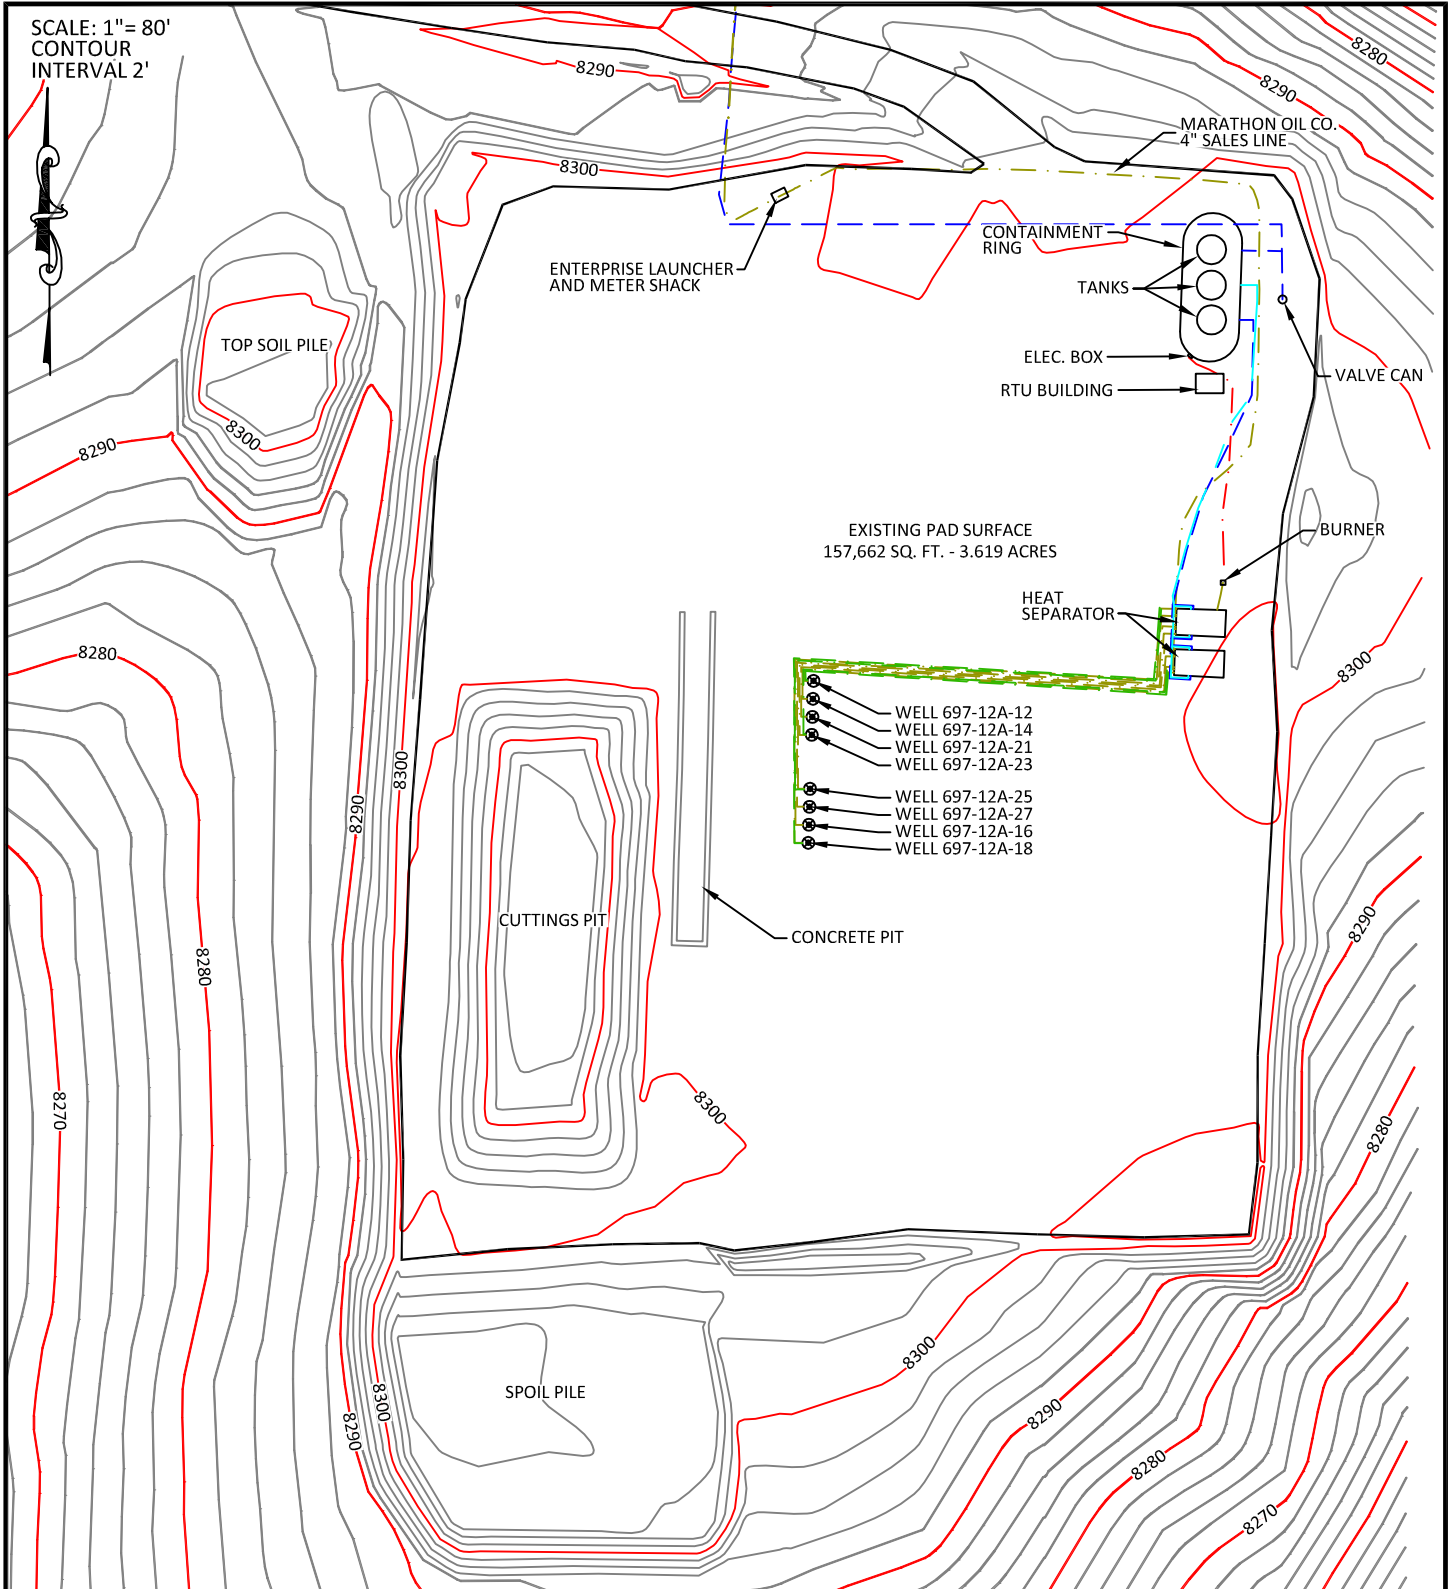

CONFIDENTIALITY NOTES:

The information contained in this plat is legally privileged and confidential information intended only for the use of the recipients. If you are not the intended recipients, you are hereby notified that any use, dissemination, distribution or copying of this information is strictly prohibited.



**WILLIAM H. SMITH
& ASSOCIATES P.C.**

SURVEYING CONSULTANTS
550 EAST SECOND NORTH PHONE: 307-875-3638
GREEN RIVER, WY 307-875-3639
www.whsmithpc.com

DRAWN BY: JSJ

CHECKED BY: WHD

JOB NO: 26099

PROJECT NO: N/A

REVISIONS:

LEGEND

- GAS LINES
- WATER LINES
- CONDENSATE LINES
- GLYCOL LINES
- ELECTRIC LINES

LOCATION:

697-12A
WITHIN THE NE/4
SECTION 12,
T 6 S, R 97 W,
6TH PM.
GARFIELD COUNTY,
COLORADO

MARATHON OIL COMPANY
PO BOX 3128, HOUSTON TX, 77253
5555 SAN FELIPE, HOUSTON TX, 77056

AS-BUILT PAD

SCALE: 1" = 80'


DATE: 10/05/2011

EXHIBIT "A"

SHEET 1 OF 3

PAD 697-12A

SCALE: 1"= 100'
CONTOUR
INTERVAL 2'

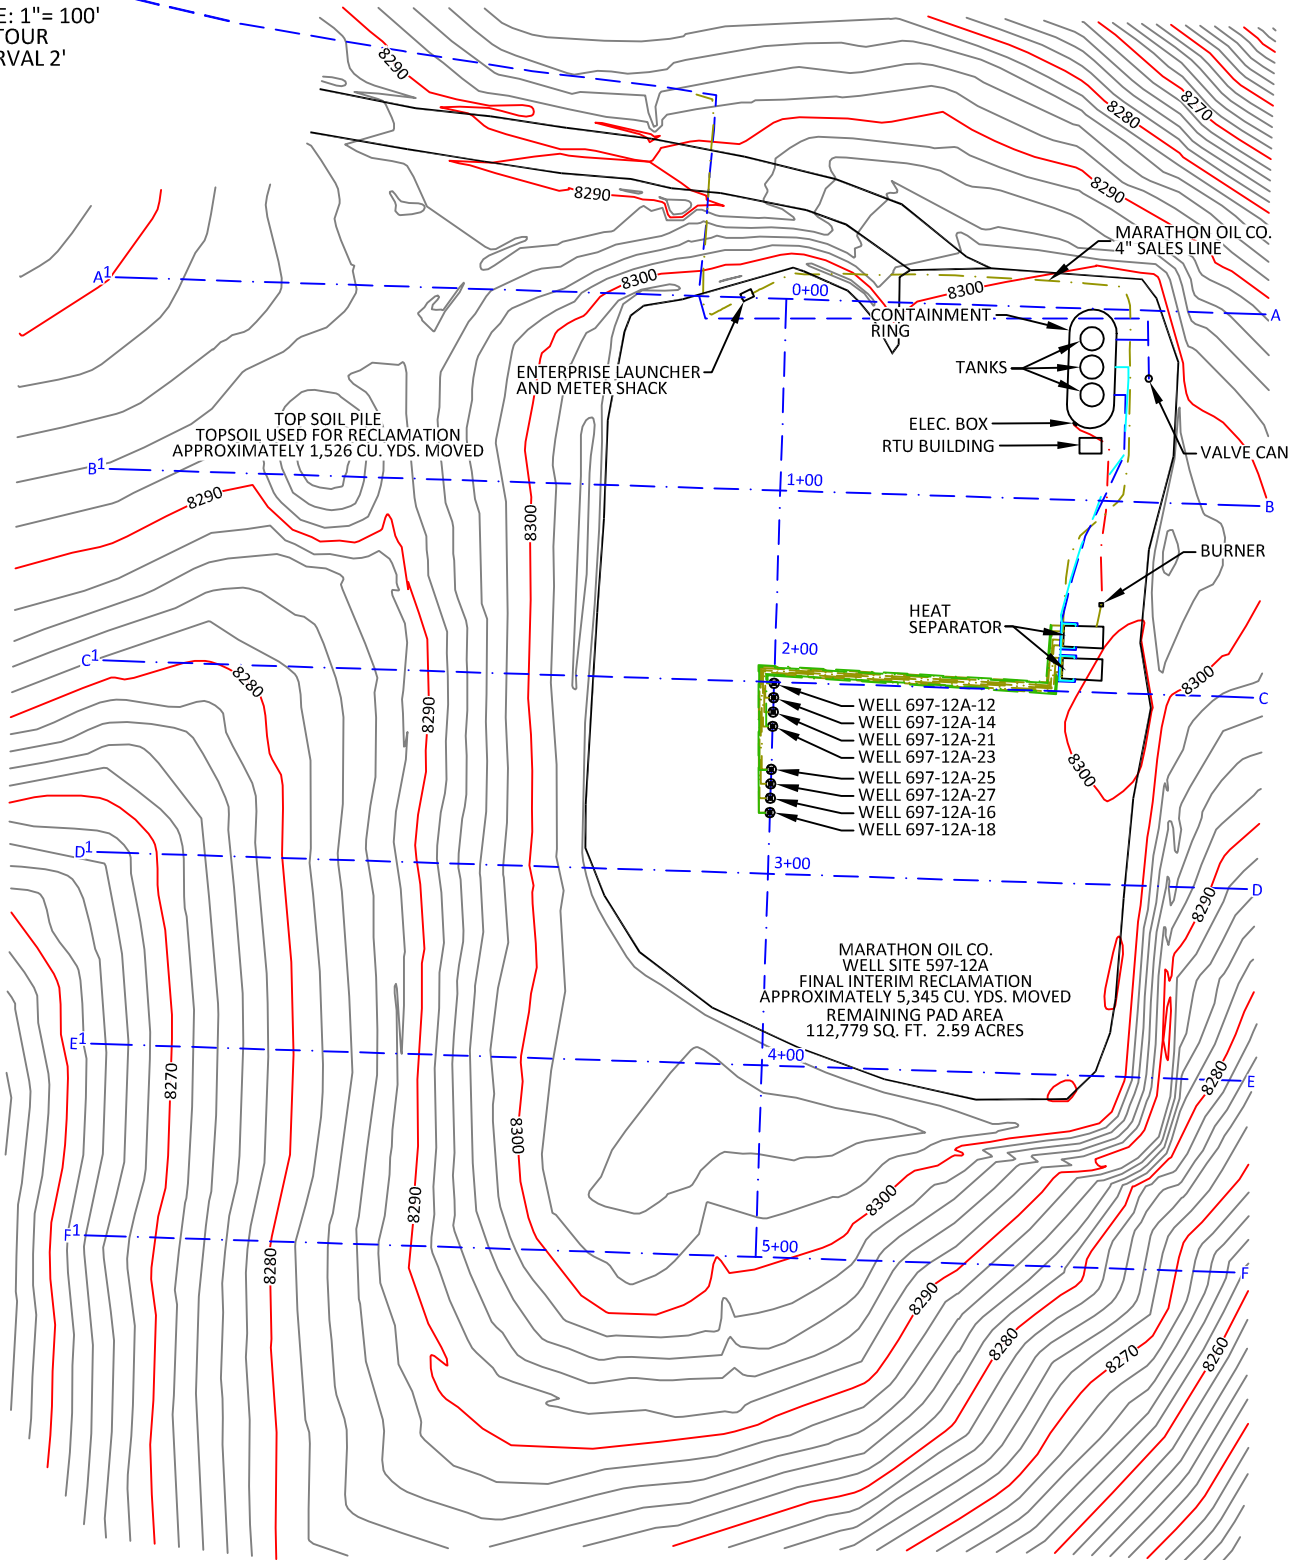

CONFIDENTIALITY NOTES:

The information contained in this plat is legally privileged and confidential information intended only for the use of the recipients. If you are not the intended recipients, you are hereby notified that any use, dissemination, distribution or copying of this information is strictly prohibited.



**WILLIAM H. SMITH
& ASSOCIATES P.C.**

SURVEYING CONSULTANTS

550 EAST SECOND NORTH PHONE: 307-875-3638
GREEN RIVER, WY 307-875-3639
www.whsmithpc.com

DRAWN BY: JSJ

CHECKED BY: WHD

JOB NO: 26099

PROJECT NO: N/A

REVISIONS:

DATA

FINAL INTERIM RECLAMATION
APPROXIMATELY 5,345 CU. YDS. MOVED

TOPSOIL USED FOR RECLAMATION
APPROXIMATELY 1,526 CU. YDS. MOVED

REMAINING PAD AREA
112,779 SQ. FT., 2.59 ACRES

LOCATION:

697-12A
WITHIN THE NE/4
SECTION 12,
T 6 S, R 97 W,
6TH PM.
GARFIELD COUNTY,
COLORADO

MARATHON OIL COMPANY
PO BOX 3128, HOUSTON TX, 77253
5555 SAN FELIPE, HOUSTON TX, 77056

INTERIM RECLAMATION ASBUILT


SCALE: 1"=100'

DATE: 10/06/2011

EXHIBIT "A"

SHEET 2 OF 3

PAD 697-12A

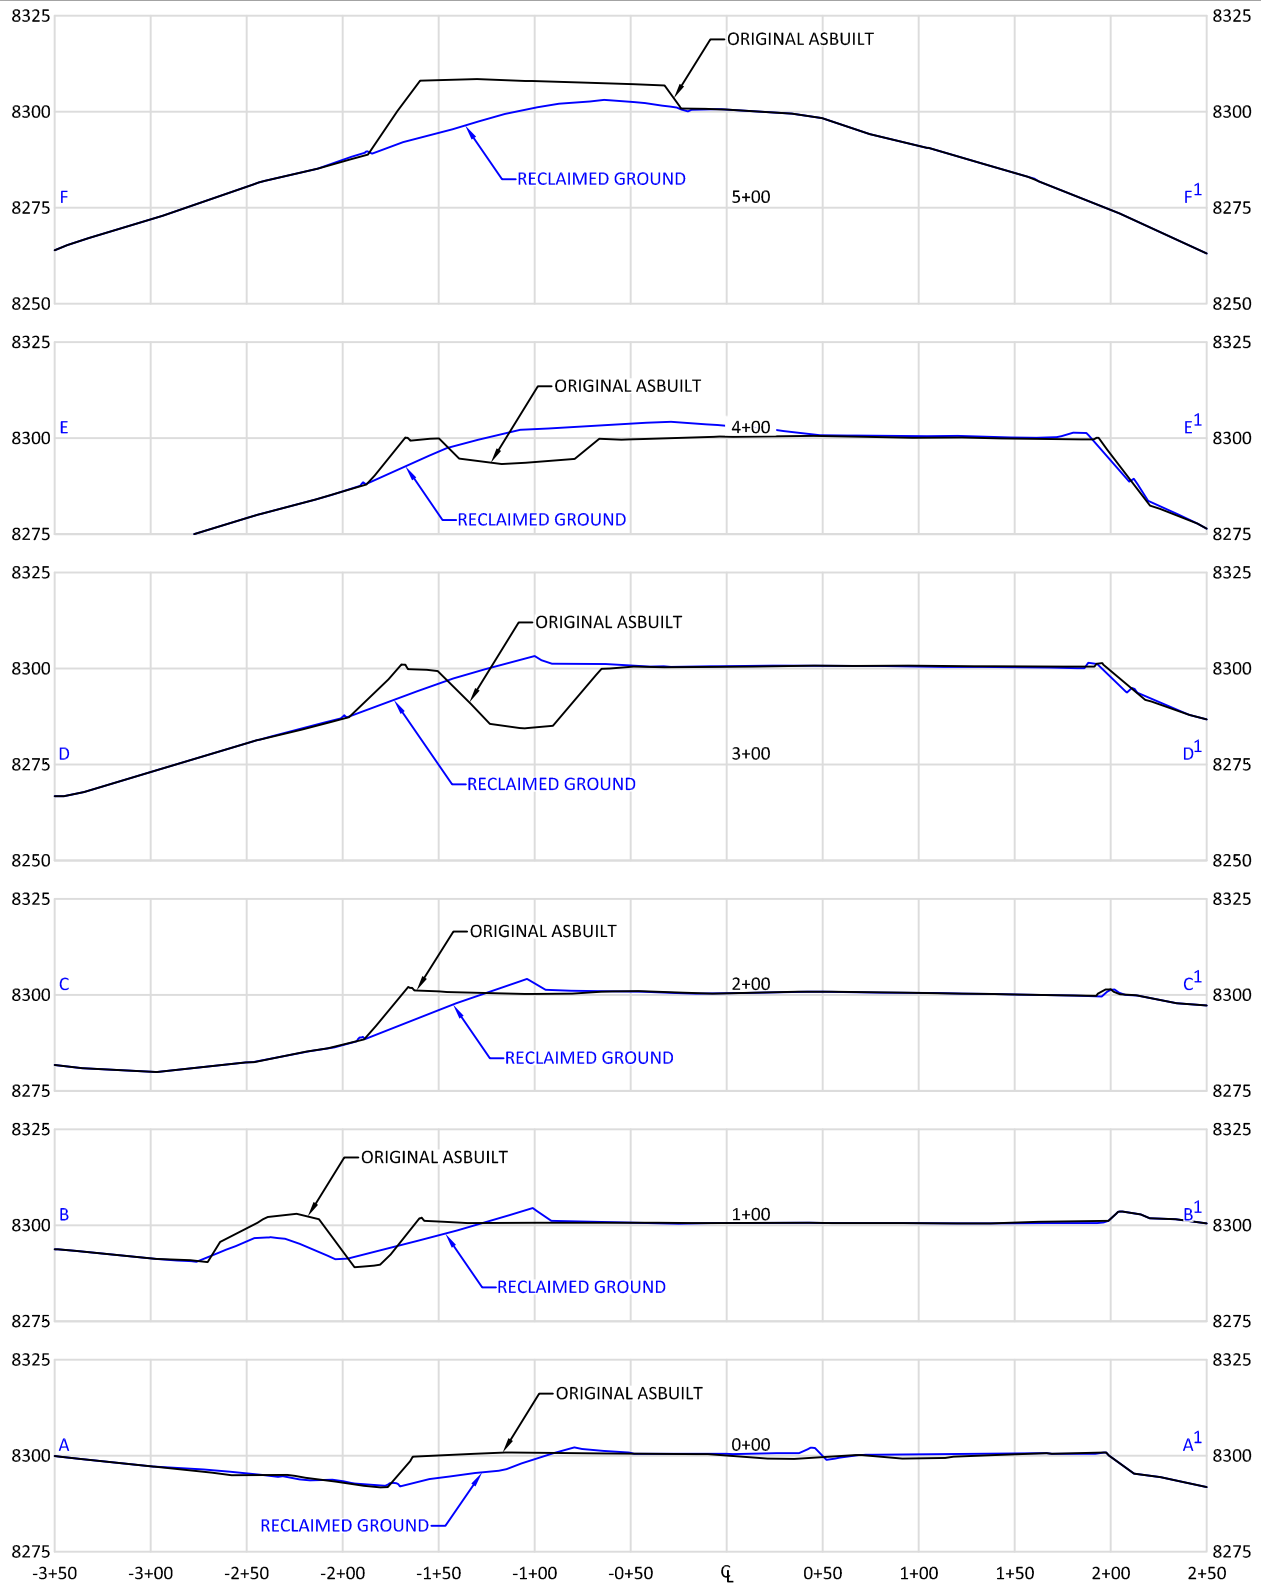

CONFIDENTIALITY NOTES:

THE INFORMATION CONTAINED IN THIS PLOT IS LEGALLY PRIVILEGED AND CONFIDENTIAL INFORMATION INTENDED ONLY FOR THE USE OF THE RECIPIENTS. IF YOU ARE NOT THE INTENDED RECIPIENTS, YOU ARE HEREBY NOTIFIED THAT ANY USE, DISSEMINATION, DISTRIBUTION OR COPYING OF THIS INFORMATION IS STRICTLY PROHIBITED.



**WILLIAM H. SMITH
& ASSOCIATES P.C.**
SURVEYING CONSULTANTS

550 EAST SECOND NORTH PHONE: 307-875-3638
GREEN RIVER, WY 307-875-3639
www.whsmithpc.com

DRAWN BY: JSJ

CHECKED BY: WHD

JOB NO: 26099

PROJECT NO: N/A

REVISIONS:

LEGEND

— ORIGINAL ASBUILT
— RECLAIMED GROUND

LOCATION:

697-12A
WITHIN THE NE/4
SECTION 12,
T 6 S, R 97 W,
6TH PM.
GARFIELD COUNTY,
COLORADO

MARATHON OIL COMPANY
PO BOX 3128, HOUSTON TX, 77253
5555 SAN FELIPE, HOUSTON TX, 77056

INTERIM RECLAMATION ASBUILT CROSS SECTIONS

SCALE: 1"=100'H/50'V
DATE: 10/06/2011






















EXHIBIT "A"
SHEET 3 OF 3


Receiving Waters:
Garden Gulch
2300 Feet Southeast

25' Access Road

Top Soil Area


Legend

-  Culvert
-  Sediment Trap
-  Cattle Pond
-  Water Bar
-  Rip Rap
-  Bales
-  V-Ditch W/Check Dam
-  Diversion Ditch
-  Site Berm
-  Toe Berm
-  Fiber Roll
-  Silt Fence
-  Area To Be Reclaimed
-  Fence
-  Blanket
-  Cut
-  Fill
-  Seeded & Hydromulched
-  Soil Roughening
-  Snow Storage
-  Rip Rap (Large Area)

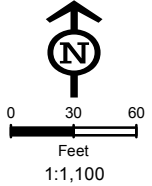

Not Present
Asphalt Or Concrete Batch Plants

Project Location

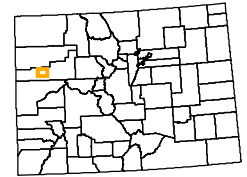

Garfield County

Map Index Overview



**Pad Site
697-12A**

Total Disturbed Area = 2.59 Acres


MARATHON OIL

REVISED	BY:	COMMENT:
3/28/2012	BJB	TEMPLATE CREATION
3/28/2012	BJB	MAP CREATION




InterTech E&E, LLC
bbergstrom@cbmainc.com
M:\Projects\Marathon\Piceance\Projects\SWMP\2012\697_12A\SWMP_697_12A_20120328.mxd

Receiving Waters:
Garden Gulch
3900 Feet Southeast

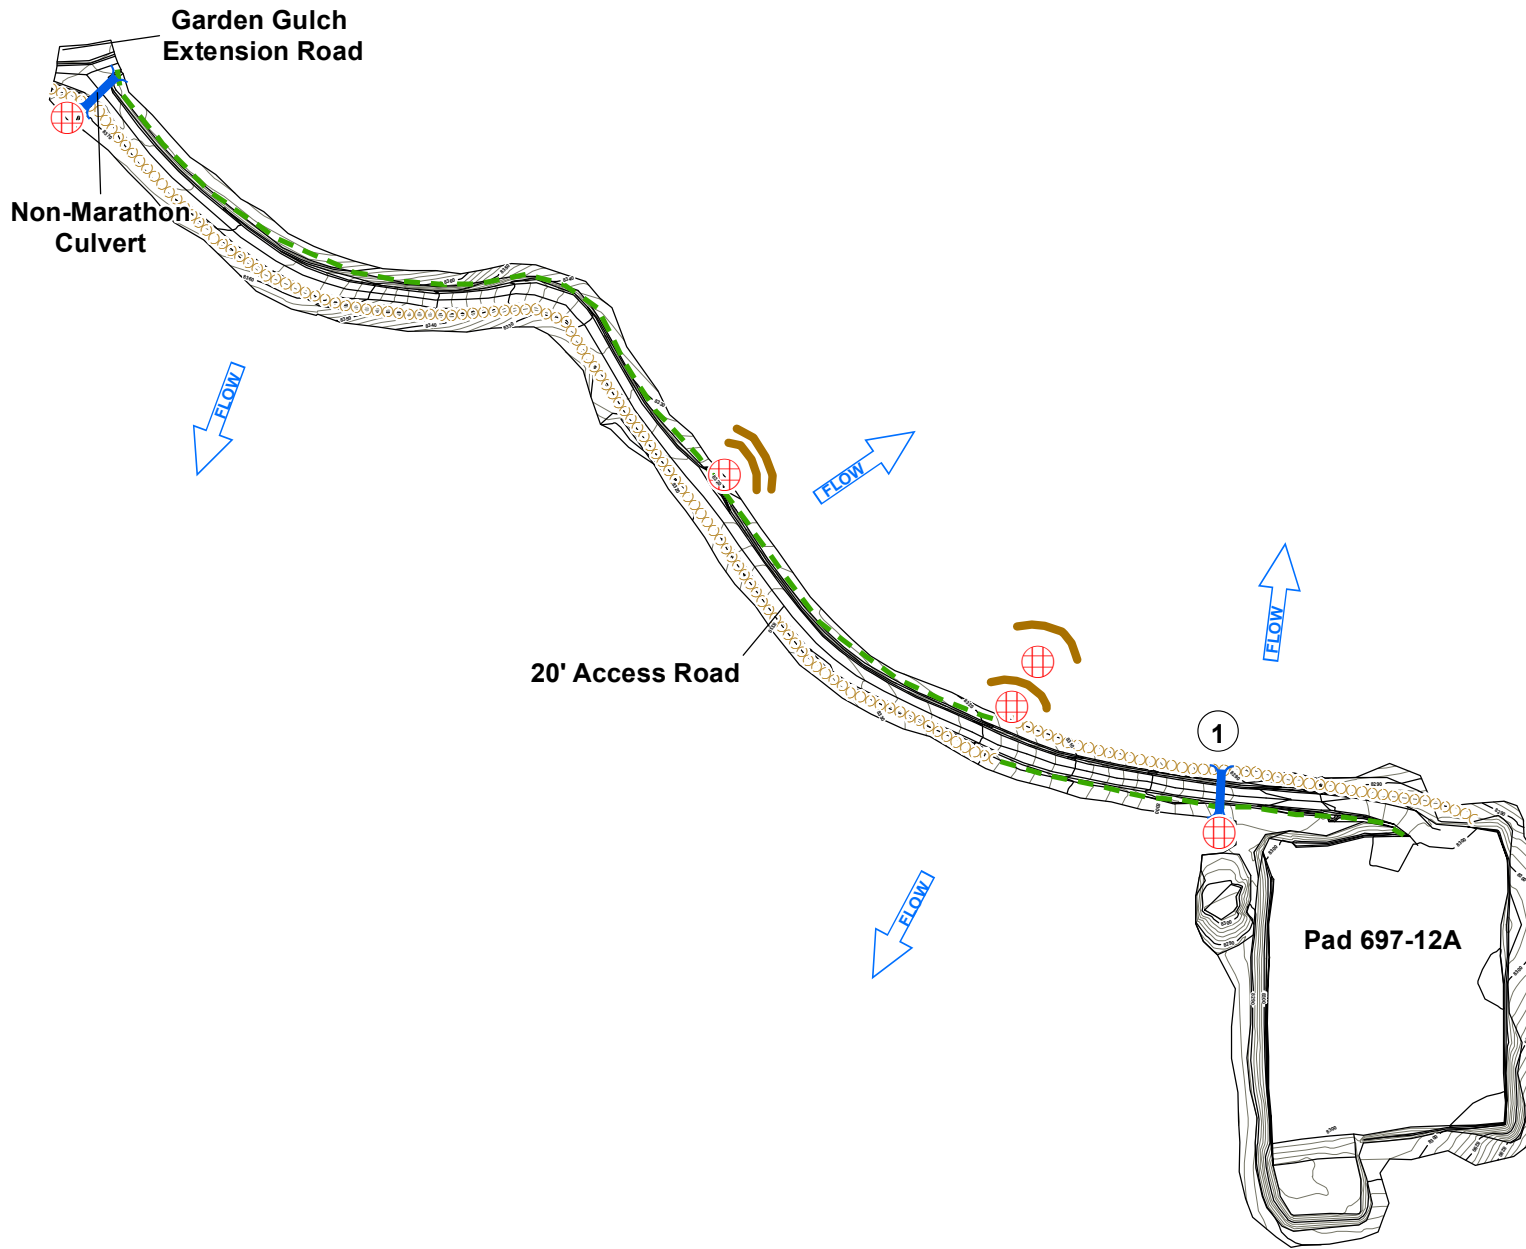


Legend

-  Culvert
-  Sediment Trap
-  Cattle Pond
-  Water Bar
-  Rip Rap
-  Bales
-  V-Ditch W/Check Dam
-  Diversion Ditch
-  Site Berm
-  Toe Berm
-  Fiber Roll
-  Silt Fence
-  Area To Be Reclaimed
-  Fence
-  Blanket
-  Cut
-  Fill
-  Seeded & Hydromulched
-  Soil Roughening
-  Snow Storage

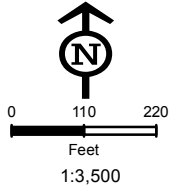

Not Present
Asphalt Or Concrete Batch Plants

Project Location

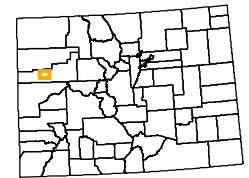

Garfield County

Map Index Overview



Access Road To Pad 697-12A

Approximate Road Length = 2,520 LF

MARATHON OIL

REVISED	BY:	COMMENT:
5/8/2012	BJB	BMP REVISION
8/27/2012	BJB	BMP REVISION
11/28/2012	BJB	BMP REVISION



InterTech

InterTech E&E, LLC
bbergstrom@cbmainc.com
M:\Projects\Marathon\Peace\Projects\SWMP\
2012\697_12A\SWMP_697_12A_Road_20121128.mxd

*Detailed pad BMP's, contours, dimensions, etc.
are maintained on the individual pad diagram.