



AS-BUILT SURVEY

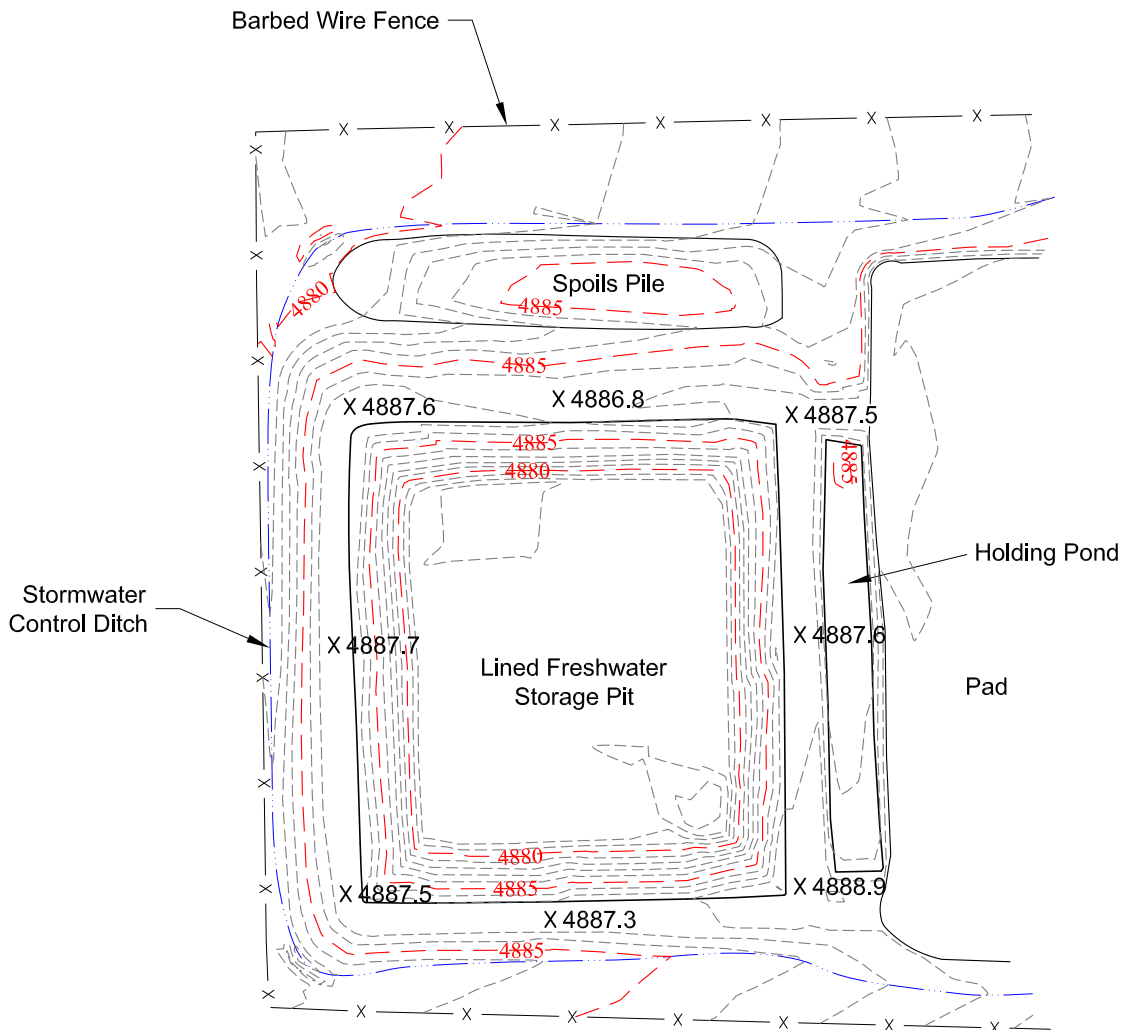

North

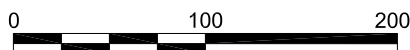

Graphic Scale in Feet
1" = 100'

Date of Field Work: 6/29/2016

CARRIZO (NIOBRARA) LLC
SIEVERS 1-3-7-62 FRESHWATER PIT

SW1/4 SE1/4 Section 3 T7N R62W
6th PM Weld County Colorado



A DIVISION OF
**Topographic
Land Surveyors**