


Z:\Projects\1319-01_BONANZA AS BUILTS_WELLS.dwg AS BUILTS PADS.dwg SAVED DATE: 2016-01-08 14:44




NOTES:

- PDOP value equals 1.6. 10-24-15
- GPS operator: Mike Johnson.
- Vegetation: Existing pad, range grass surrounding pad perimeter
- Total Disturbance: 2.10 Acre

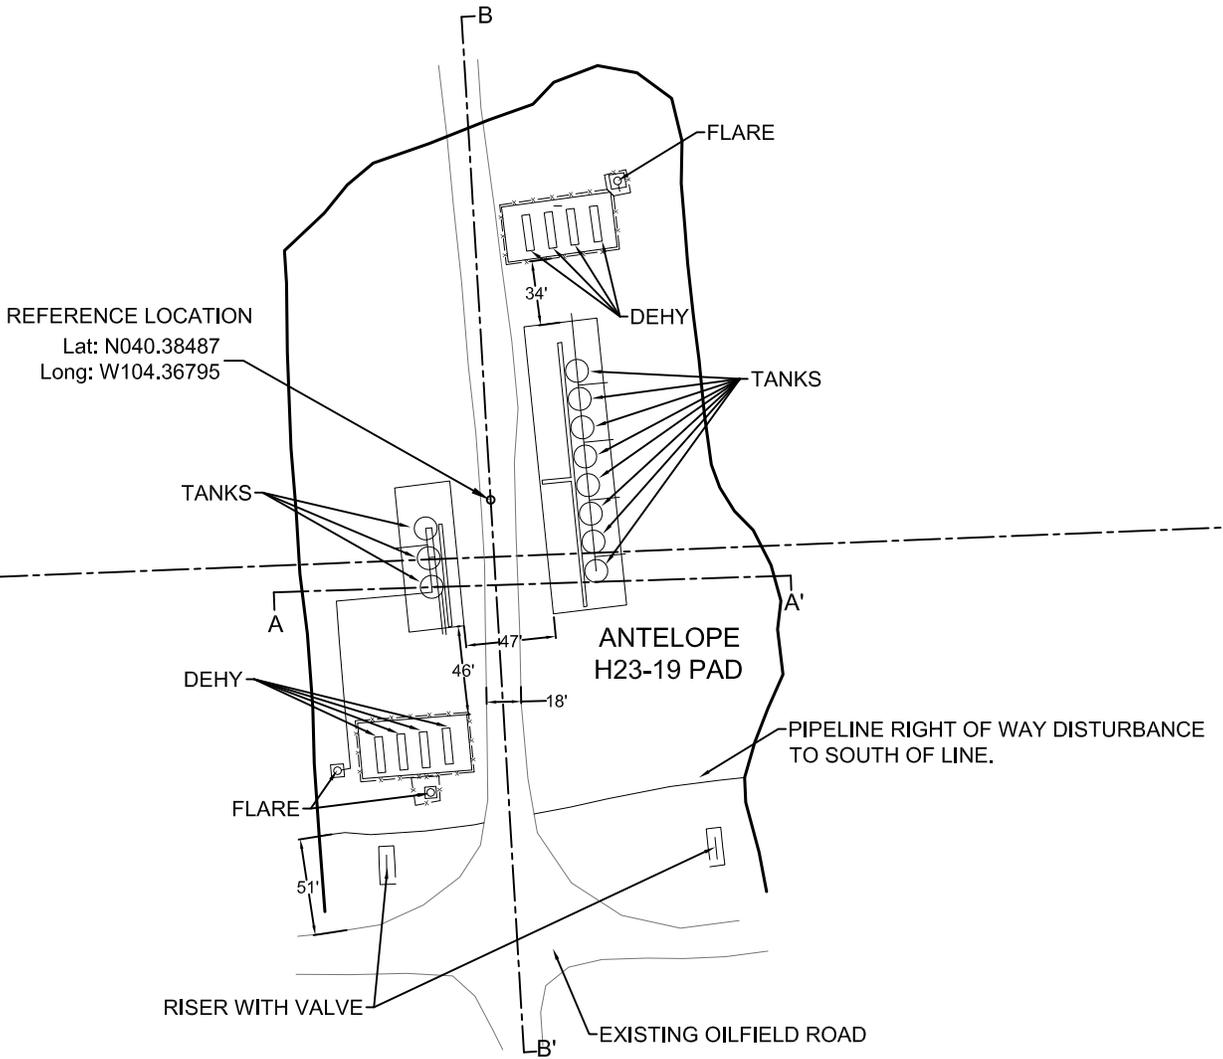

WILLIAM H. SMITH & ASSOCIATES, Inc.
 155 N. 1st Street
 Lander, WY 82520
 Phone: 307-335-5646

Drawn By: MAM	Checked By: DAF
Job No.: 2015043	Date: 11/09/15
Revision:	

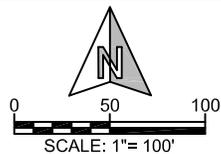

IF BAR LENGTH DOES NOT EQUAL 1"(ONE INCH), THIS PAGE WAS NOT PLOTTED TO THE INTENDED SCALE.

AS-BUILT LAYOUT

ANTELOPE
 H23-19 PAD
 SE $\frac{1}{4}$ NW $\frac{1}{4}$ & NE $\frac{1}{4}$ SW $\frac{1}{4}$
 SECTION 19,
 T.5N., R.62W., 6th PM
 WELD COUNTY, COLORADO



410 17th Street
 Denver, CO 80202
 (720) 440-6100

SHEET	1
OF	1