


Certification Statement:



I certify that the Hunter Mesa Water Treatment Facility pond referred to as "the Middle Pond" and/or "Pond 2" was constructed to the lines and contours shown on this drawing. The survey data used to create this drawing was collected in 2007 by Wastach Surveying during a time period when the pond was drained to expose the pond liner for survey. Since 2007 the only major project involving this pond that I am aware of was the installation of a floating cover. However, the floating cover project did not impact the shape or volume of the pond. Thus, to the best of my knowledge the data and information presented on this drawing is still representative of the shape and volume of the pond.

Marc J. Kenney
Colorado P.E. #41215

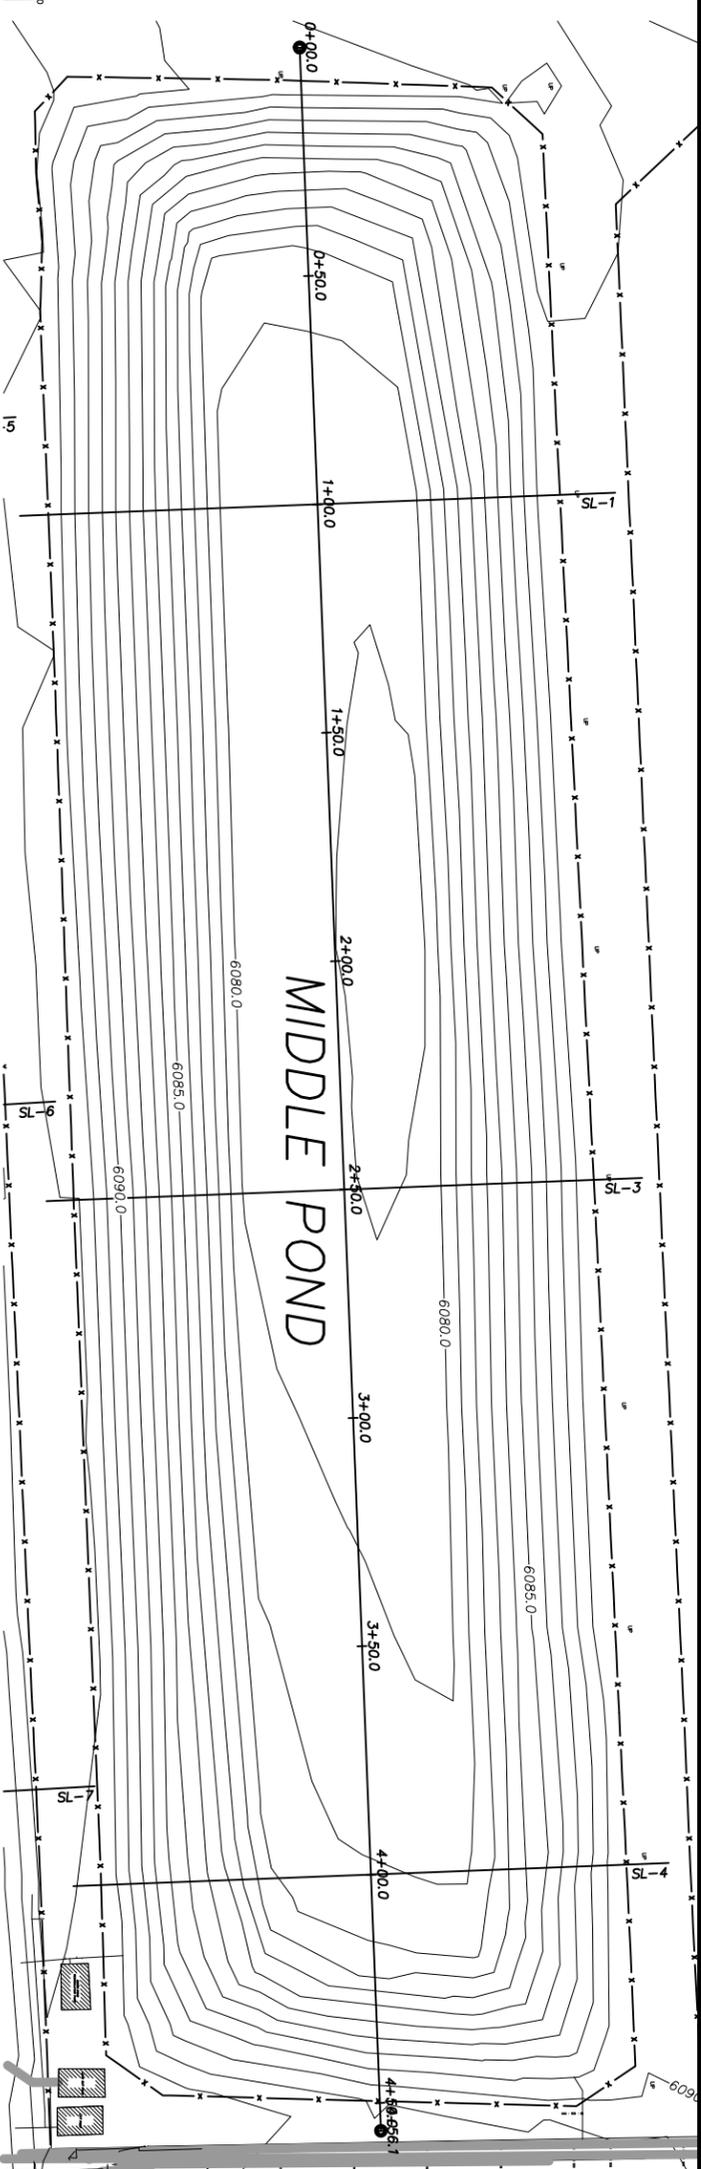

Profile View of Alignment – Middle Pond

MIDDLE POND STAGE STORAGE TABLE				
ELEV	AREA (sq. ft.)	DEPTH (ft)	AVG END TOTAL VOL. (cu. ft.)	CONIC TOTAL VOL. (cu. ft.)
6,079.00	1,781.30	0.00	0.00	0.00
6,079.50	6,430.12	0.50	453.01	341.00
6,080.00	9,245.41	1.00	2,107.47	1,627.09
6,080.50	11,556.31	1.50	2,252.65	1,760.84
6,081.00	15,022.37	2.00	6,115.05	4,757.99
6,081.50	17,132.13	2.50	14,153.67	12,790.84
6,082.00	18,893.47	3.00	23,160.07	21,793.65
6,082.50	20,497.74	3.50	33,007.87	31,638.73
6,083.00	22,016.99	4.00	43,636.55	42,265.14
6,083.50	23,593.97	4.50	55,039.29	53,665.61
6,084.00	25,222.48	5.00	67,243.41	65,867.46
6,084.50	26,776.14	5.50	80,243.06	78,865.18
6,085.00	28,219.95	6.00	93,992.08	92,612.62
6,085.50	29,659.10	6.50	108,461.85	107,080.90
6,086.00	31,111.08	7.00	123,654.39	122,271.99
6,086.50	32,588.83	7.50	139,579.37	138,195.54
6,087.00	34,089.35	8.00	156,248.92	154,863.68
6,087.50	35,627.18	8.50	173,678.05	172,291.40
6,088.00	37,206.27	9.00	191,886.41	190,498.34
6,088.50	38,800.40	9.50	210,888.08	209,498.61
6,089.00	40,408.72	10.00	230,690.36	229,299.53
6,089.50	42,259.65	10.50	251,357.45	249,964.90

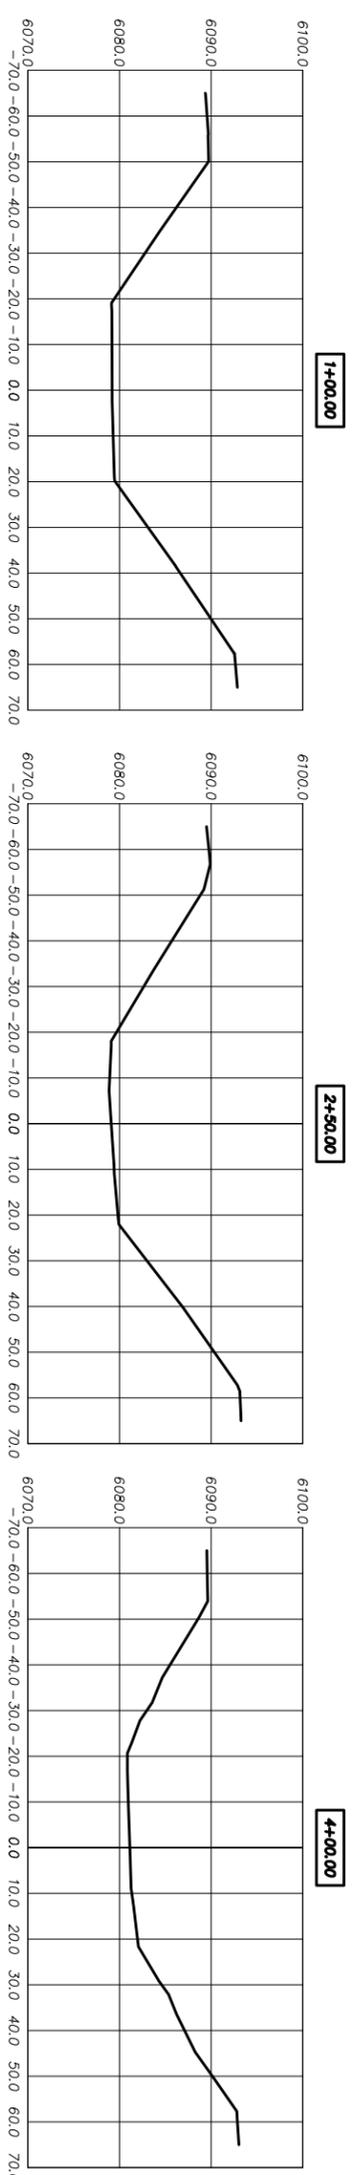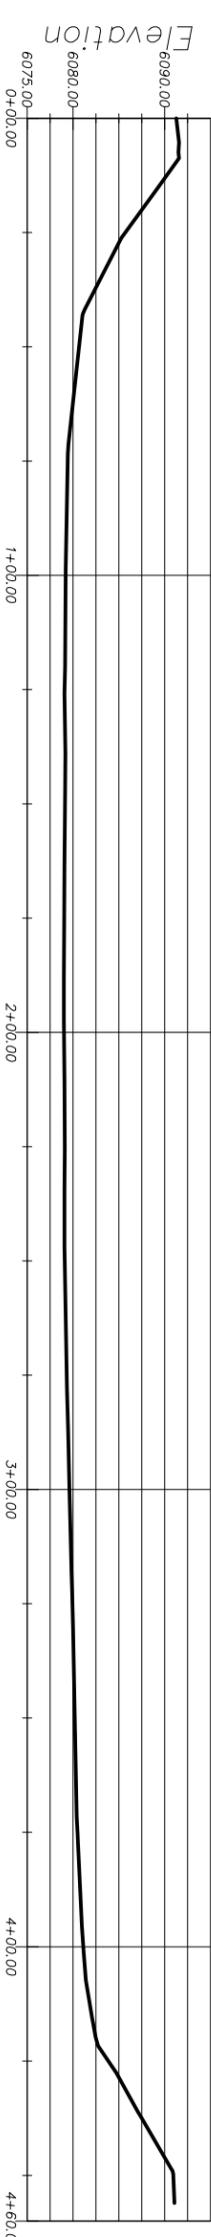

NOTES:
 1. THE LOCATIONS OF UNDERGROUND UTILITIES AS SHOWN HEREON ARE BASED ON VISIBLE EVIDENCE FROM ABOVE GROUND STRUCTURES AND EXCAVATIONS. THESE HAVE BEEN USED TO DETERMINE THE EXACT LOCATIONS AND DEPTHS OF THE UNDERGROUND UTILITIES. NO EXCAVATIONS WERE MADE DURING THIS SURVEY TO DETERMINE THE EXACT LOCATIONS AND DEPTHS OF THE UNDERGROUND UTILITIES. ACTUAL LOCATIONS MAY VARY SLIGHTLY FROM THOSE SHOWN HEREON AND ADDITIONAL UNDERGROUND UTILITIES MAY BE PRESENT. THIS PROJECT AND LOCATIONS OF ALL UNDERGROUND UTILITIES AND STRUCTURES SHOULD BE VERIFIED PRIOR TO ANY CONSTRUCTION ON THIS PROPERTY.
 2. EXISTING SURVEY INFORMATION (INCLUDING EXISTING UTILITIES) PROVIDED BY WASTACH SURVEYING.
 3. THE ORIGINAL DRAWING SIZE IS 22" x 34".

UNCC
 811
 Call before you dig.
 CALL A BUSINESS DAY IN ADVANCE TO REQUEST YOUR DIG, GRADE, OR EXCAVATE PERMIT. MARKING OF UNDERGROUND MEMBER UTILITIES.

NO.	DATE	DESCRIPTION	BY

encana
 natural gas
SMITH RIVER CITY
 C O M M U N I T Y

744 Hudson Drive, Suite 110
 Grand Junction, CO 81506
 Phone: 970.241.4222
 Fax: 970.241.8441

Encana Oil & Gas (USA) Inc.
 Hunter Mesa Water Treatment Facility
 As-Built Drawing
 Middle Pond (aka Pond 2)

PROJECT #1008-102
 DRAWN BY: MJK
 CHECKED BY: MJK
 SCALE: 1"=20'
 DATE ISSUED: 10/12/2016
 SHEET NO. 1 OF 1 SHEETS