


DIAMOND VALLEY EAST PAD
AS-BUILT DRAWING

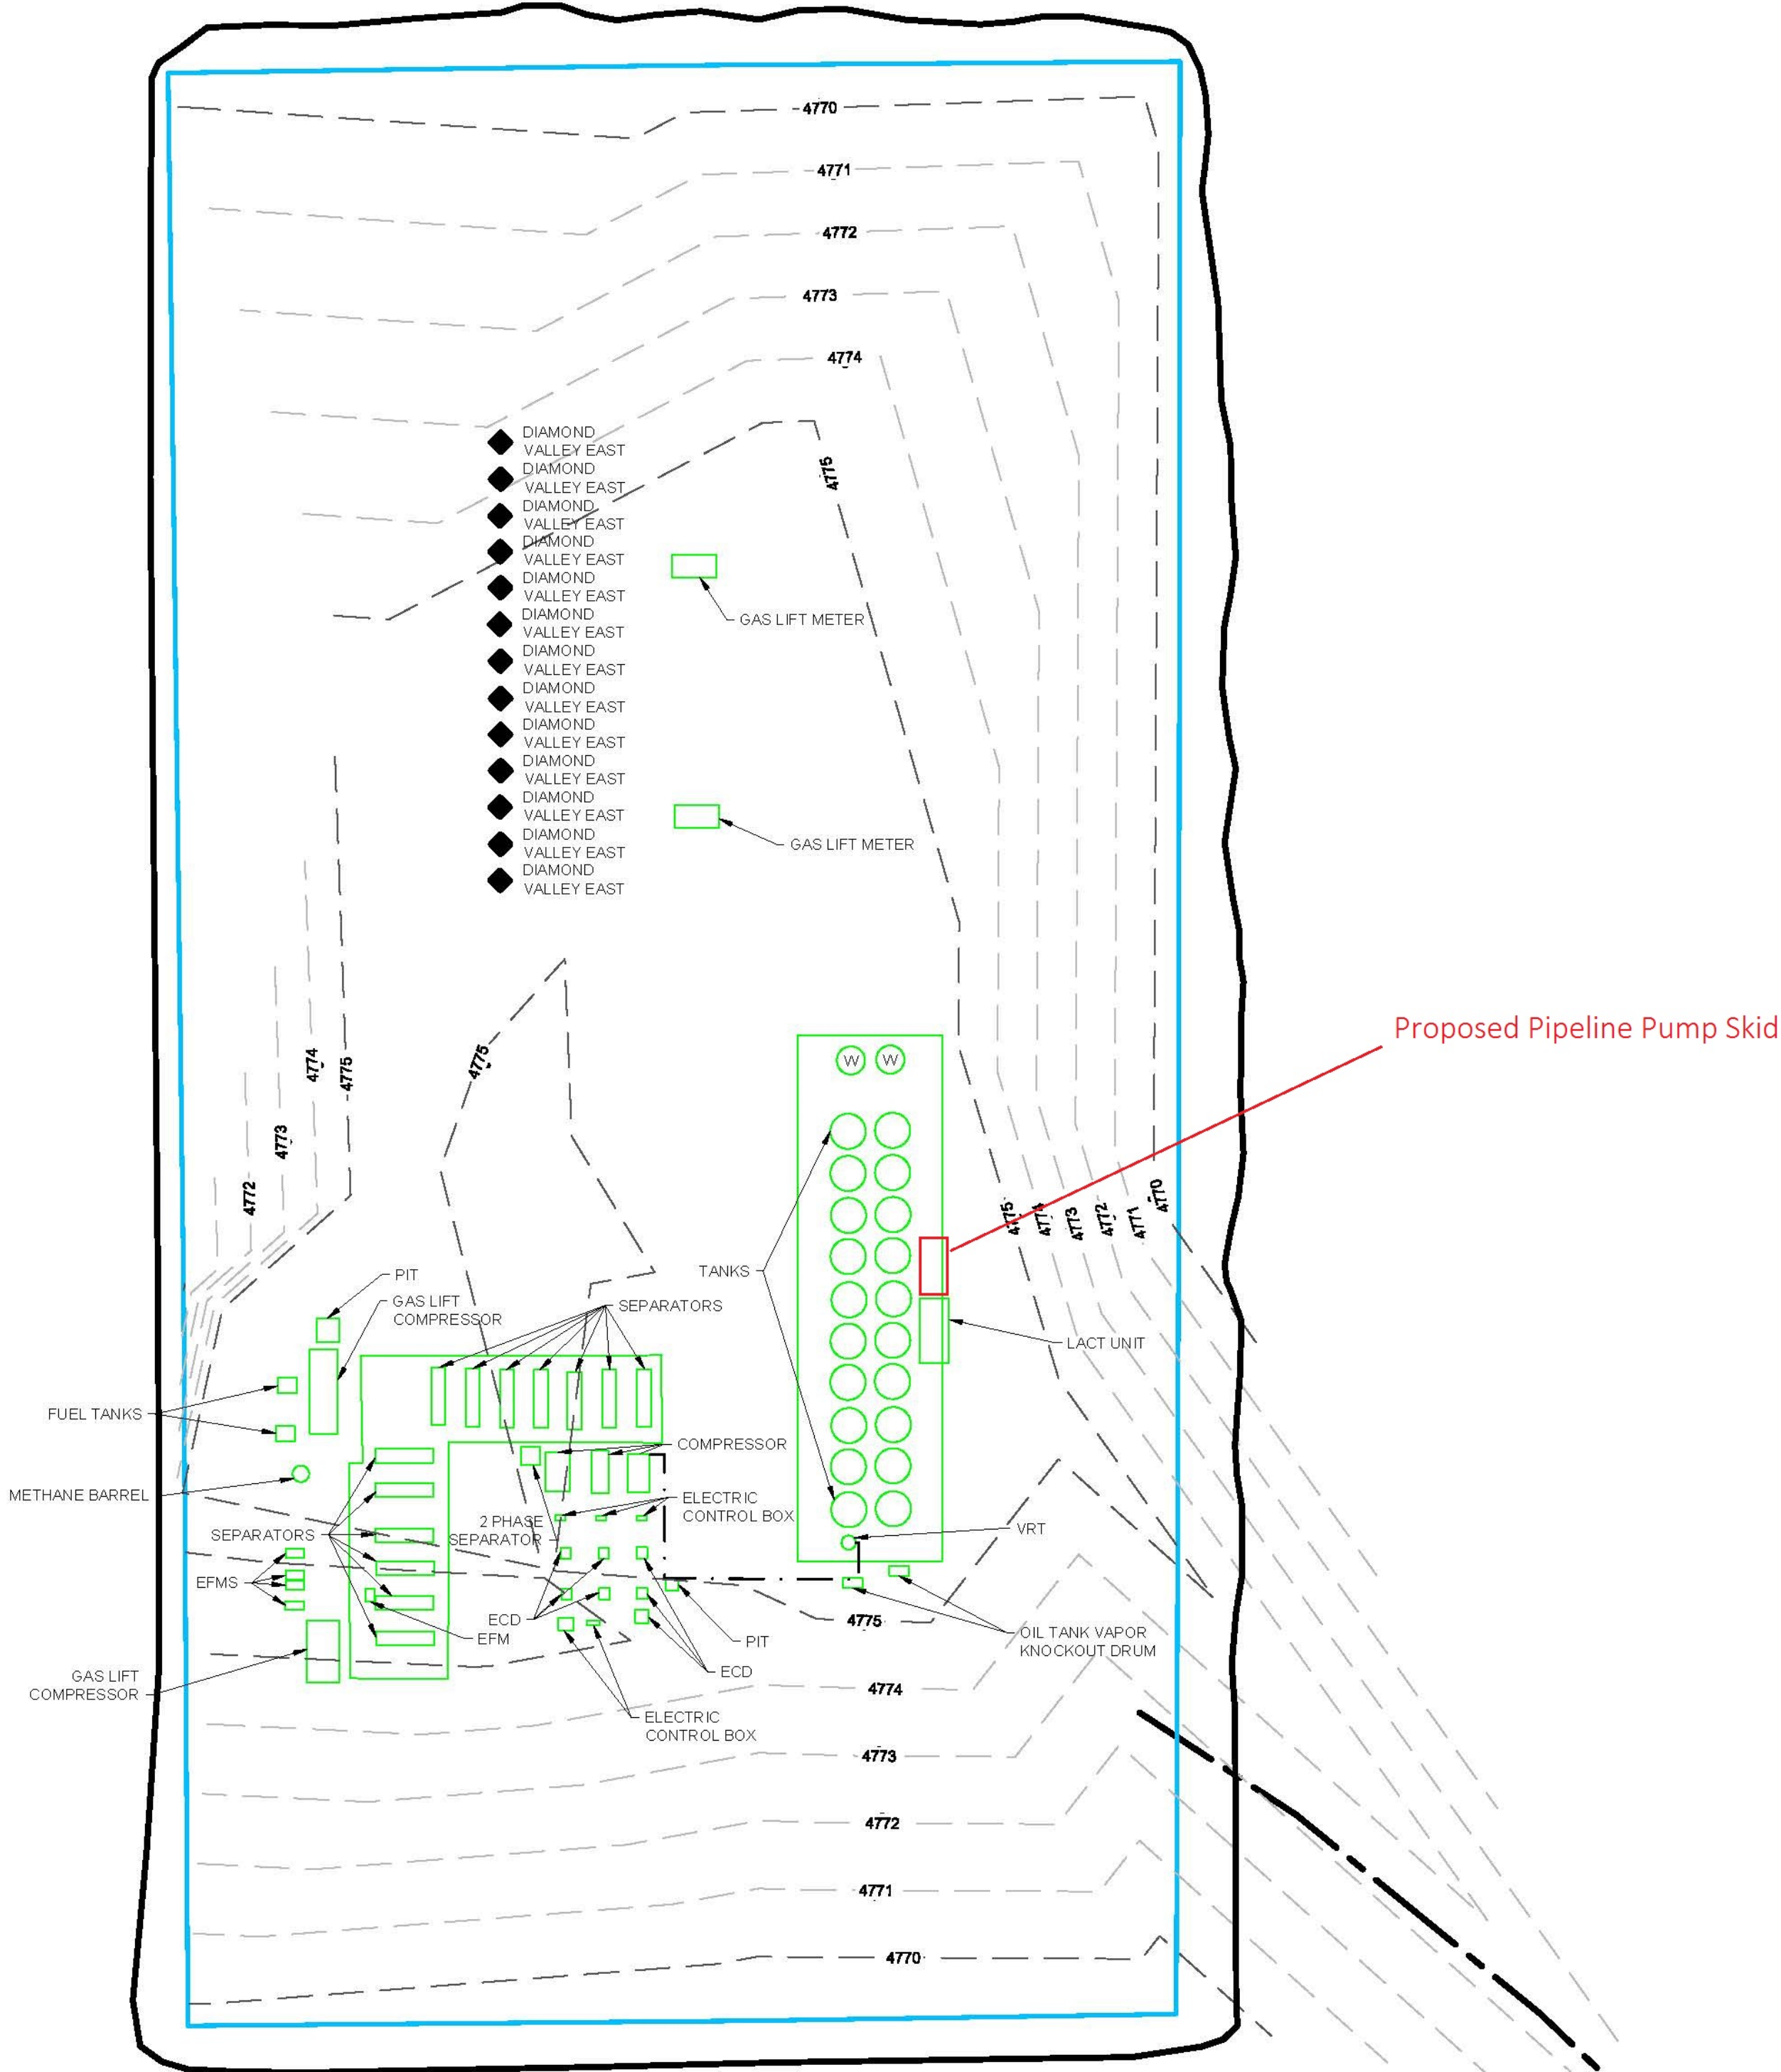

LEGEND

◆	= EXISTING WELL	---	= UNDERGROUND OIL LINE
—	= EXISTING PAD	---	= ROAD
—	= EXISTING FACILITIES	---	= PERMITTED DISTURBANCE AREA
---	= FLOWLINE	---	= EXISTING DISTURBANCE AREA

PREPARED BY: ASCENT ENGINEERS & SURVEYORS 2010 Milling Circle Boulder, CO 80501 (303) 440-9100 www.ascent-engineers.com	FIELD DATE: 07-18-17	SITE NAME: DIAMOND VALLEY EAST PAD	PREPARED FOR: EXTRACTION 2010 Milling Circle Boulder, CO 80501 (303) 440-9100 www.extraction-engineers.com
	DRAWING DATE: 07-19-17	SURFACE LOCATION: NW 1/4 SW 1/4 SEC. 23, T6N, R67W, 6TH P.M.	
	BY: SEH	CHECKED BY: PAL	