
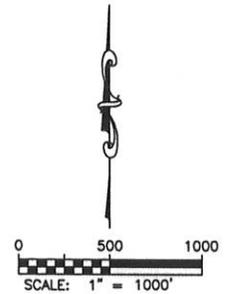


WELL AS-BUILT SURVEY  
MALO #1

SECTION: 21  
TOWNSHIP: 8N  
RANGE: 59W

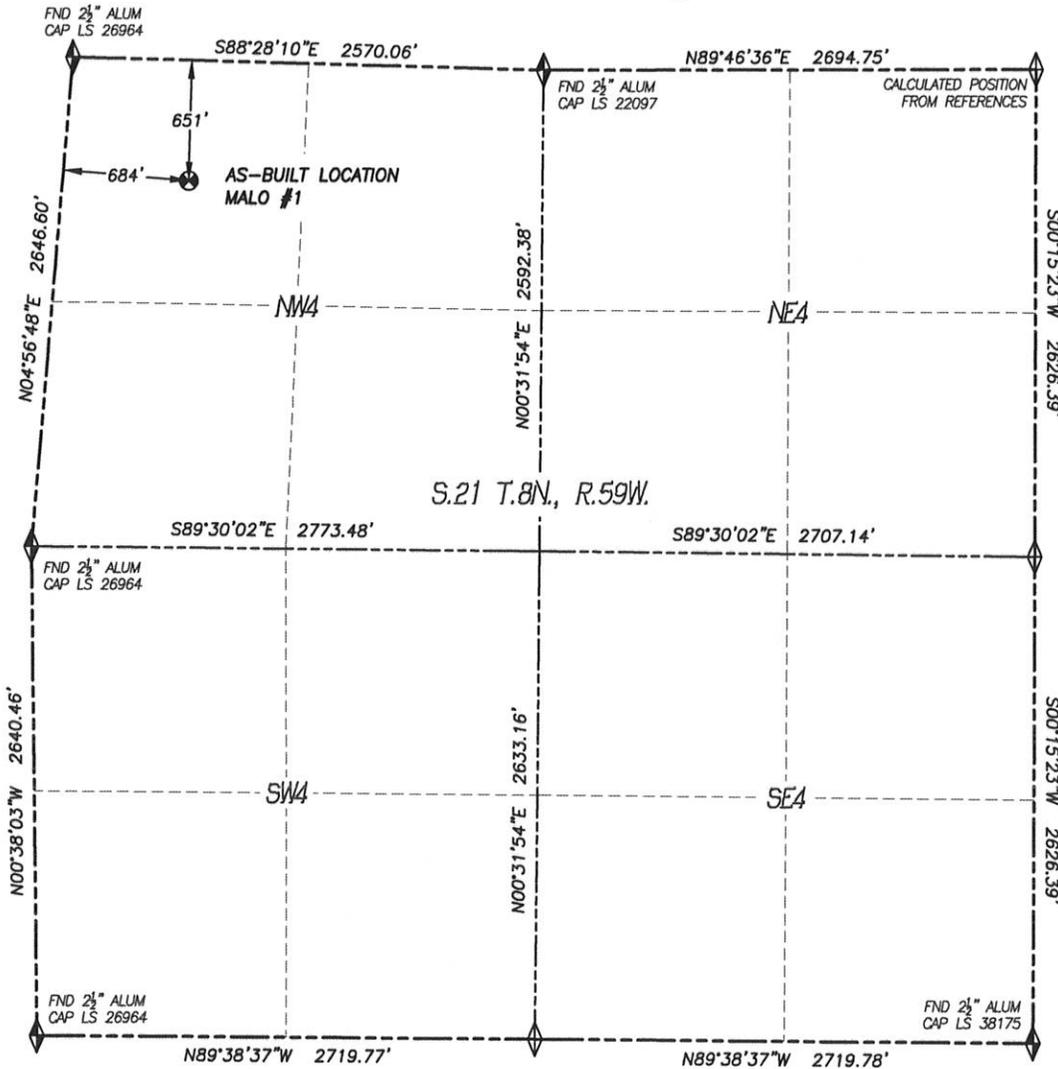

- LEGEND**
- ◆ FOUND MONUMENT AS DESCRIBED
  - ☀ PROPOSED WELL
  - ⊙ EXISTING WELL
  - BOTTOM HOLE
  - ⊘ ABANDONED WELL
  - ◆ CALCULATED POSITION


IN ACCORDANCE WITH A REQUEST FROM TONY BALL OF NOBLE ENERGY INC., DALEY LAND SURVEYING, INC. HAS DETERMINED THE SURFACE LOCATION OF THE MALO #1 WELL TO BE 651' FNL, 684' FWL, AS MEASURED AT NINETY (90) DEGREES FROM THE SECTION LINES OF SECTION 21, TOWNSHIP 8 NORTH, RANGE 59 WEST, OF THE 6TH PRINCIPAL MERIDIAN, WELD COUNTY, COLORADO.

I HEREBY STATE THAT THIS WELL AS-BUILT SURVEY WAS PREPARED BY ME OR UNDER MY DIRECT SUPERVISION, THAT THE WORK WAS COMPLETED ON 4/18/2018 FOR AND ON BEHALF OF NOBLE ENERGY, INC., AND THAT THIS MAP DOES NOT REPRESENT A BOUNDARY SURVEY, IT IS NOT A LAND SURVEY PLAT OR AN IMPROVEMENT SURVEY PLAT AND IT IS NOT TO BE RELIED UPON FOR THE ESTABLISHMENT OF FENCE, BUILDING OR OTHER FUTURE IMPROVEMENT LINES.

**NOTES:**

- 1) BEARINGS FOR THIS MAP ARE ASSUMED AND BASED UPON GPS OBSERVATIONS MADE BETWEEN MONUMENTS LOCATED AT THE NORTHWEST CORNER AND THE NORTH QUARTER CORNER OF SECTION 21, T.8N., R.59W.
- 2) HORIZONTAL DATUM IS NAD83.
- 3) VERTICAL DATUM IS NAVD88 AND ORIGINATES FROM THE LOCAL C.O.R.S. NETWORK, UTILIZING THE GEOID12A MODEL.
- 4) SURFACE USE: PASTURE.
- 5) INST. OPERATOR: KYLE DALEY.
- 6) NO EXCAVATION WAS DONE TO VERIFY LOCATION AS DETERMINED BY VISUAL INSPECTION AND METAL LOCATOR.

NAD 83 LATITUDE AND LONGITUDE	
<b>SURFACE LOCATION:</b>	
LATITUDE:	N40.65302'
LONGITUDE:	W103.98895'
ELEV:	4847'
PDOP:	1.2
QTR/QTR:	NW4/NW4

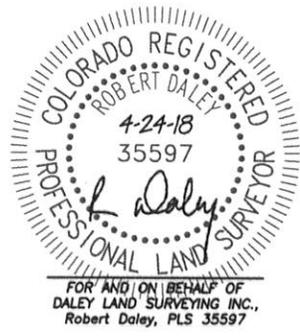

\\Survey\0810247\Drawings\PA Wells\Malo #1.dwg