

R
68
W

R
67
W

T4N

T3N

CR 38

I 25 FRONTAGE ROAD

PROPOSED LOCATION:
WILSON IC PAD

MEAD

CR 34

NOTE: PARCEL DATA SHOWN HAS BEEN OBTAINED FROM VARIOUS SOURCES AND SHOULD BE USED FOR MAPPING, GRAPHIC AND PLANNING PURPOSES ONLY. NO WARRANTY IS MADE BY UINTAH ENGINEERING AND LAND SURVEYING (UELS) FOR ACCURACY OF THE PARCEL DATA.

LEGEND:

— TRUCK ROUTE



GREAT WESTERN OPERATING COMPANY


WILSON IC PAD
NW 1/4 NW 1/4, SECTION 1, T3N, R68W, 6th P.M.
WELD COUNTY, COLORADO

SURVEYED BY	J.F.	04-05-18	SCALE
DRAWN BY	J.L.G.	04-20-18	1 : 36,000

TRUCK ROUTE MAP



UELS, LLC
Corporate Office * 85 South 200 East
Vernal, UT 84078 * (435) 789-1017

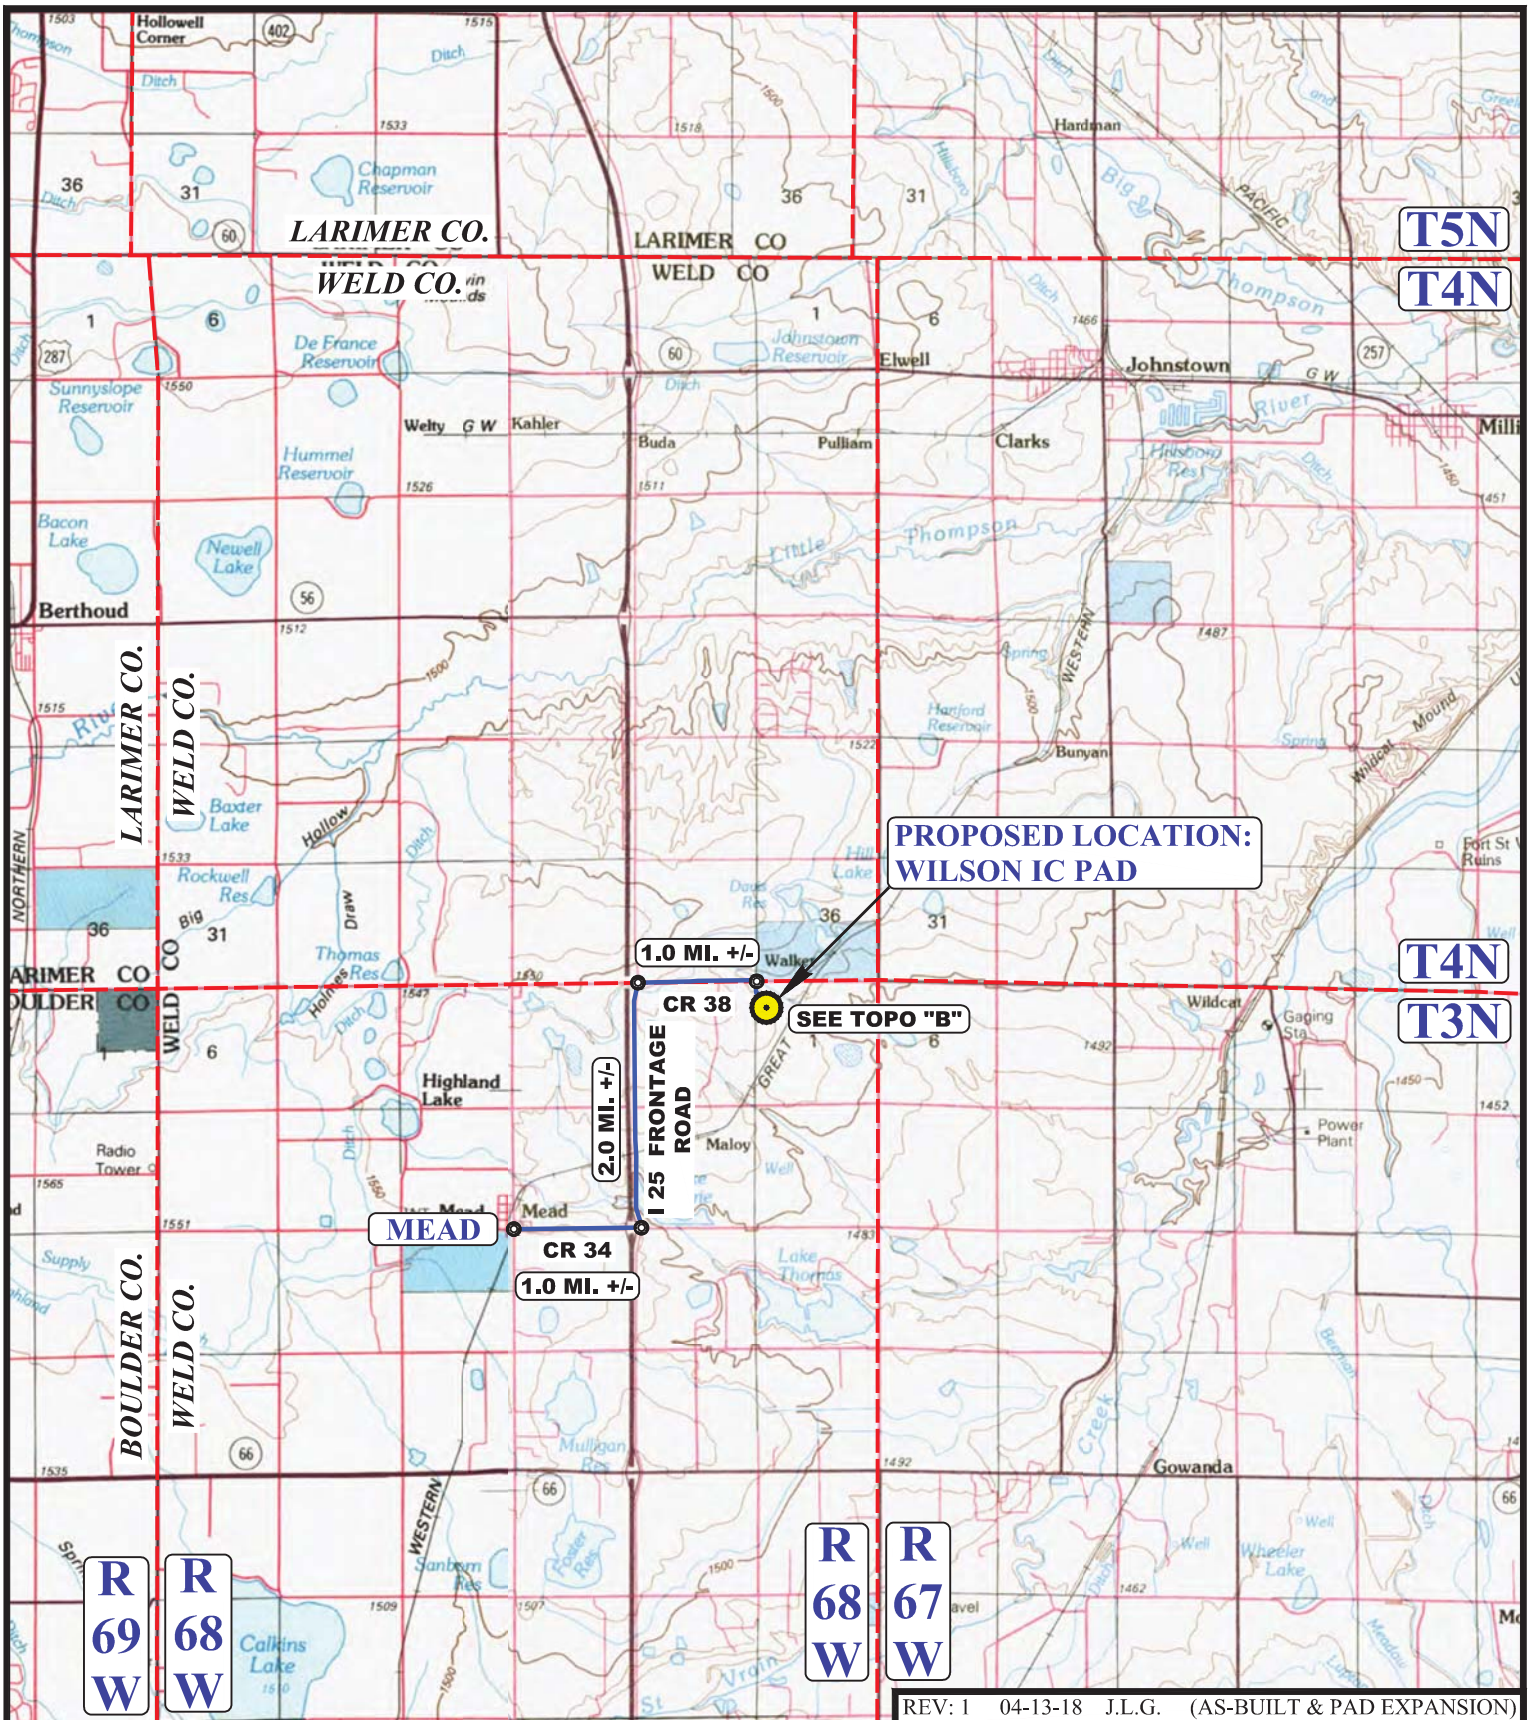

REV: 1 04-13-18 J.L.G. (AS-BUILT & PAD EXPANSION)

LEGEND:

 PROPOSED LOCATION




GREAT WESTERN OPERATING COMPANY

WILSON IC PAD
 NW 1/4 NW 1/4, SECTION 1, T3N, R68W, 6th P.M.
 WELD COUNTY, COLORADO



UELS, LLC
 Corporate Office * 85 South 200 East
 Vernal, UT 84078 * (435) 789-1017

SURVEYED BY	J.F.	04-05-18	SCALE
DRAWN BY	M.F.D.	04-19-16	1 : 100,000
ACCESS ROAD MAP			TOPO A

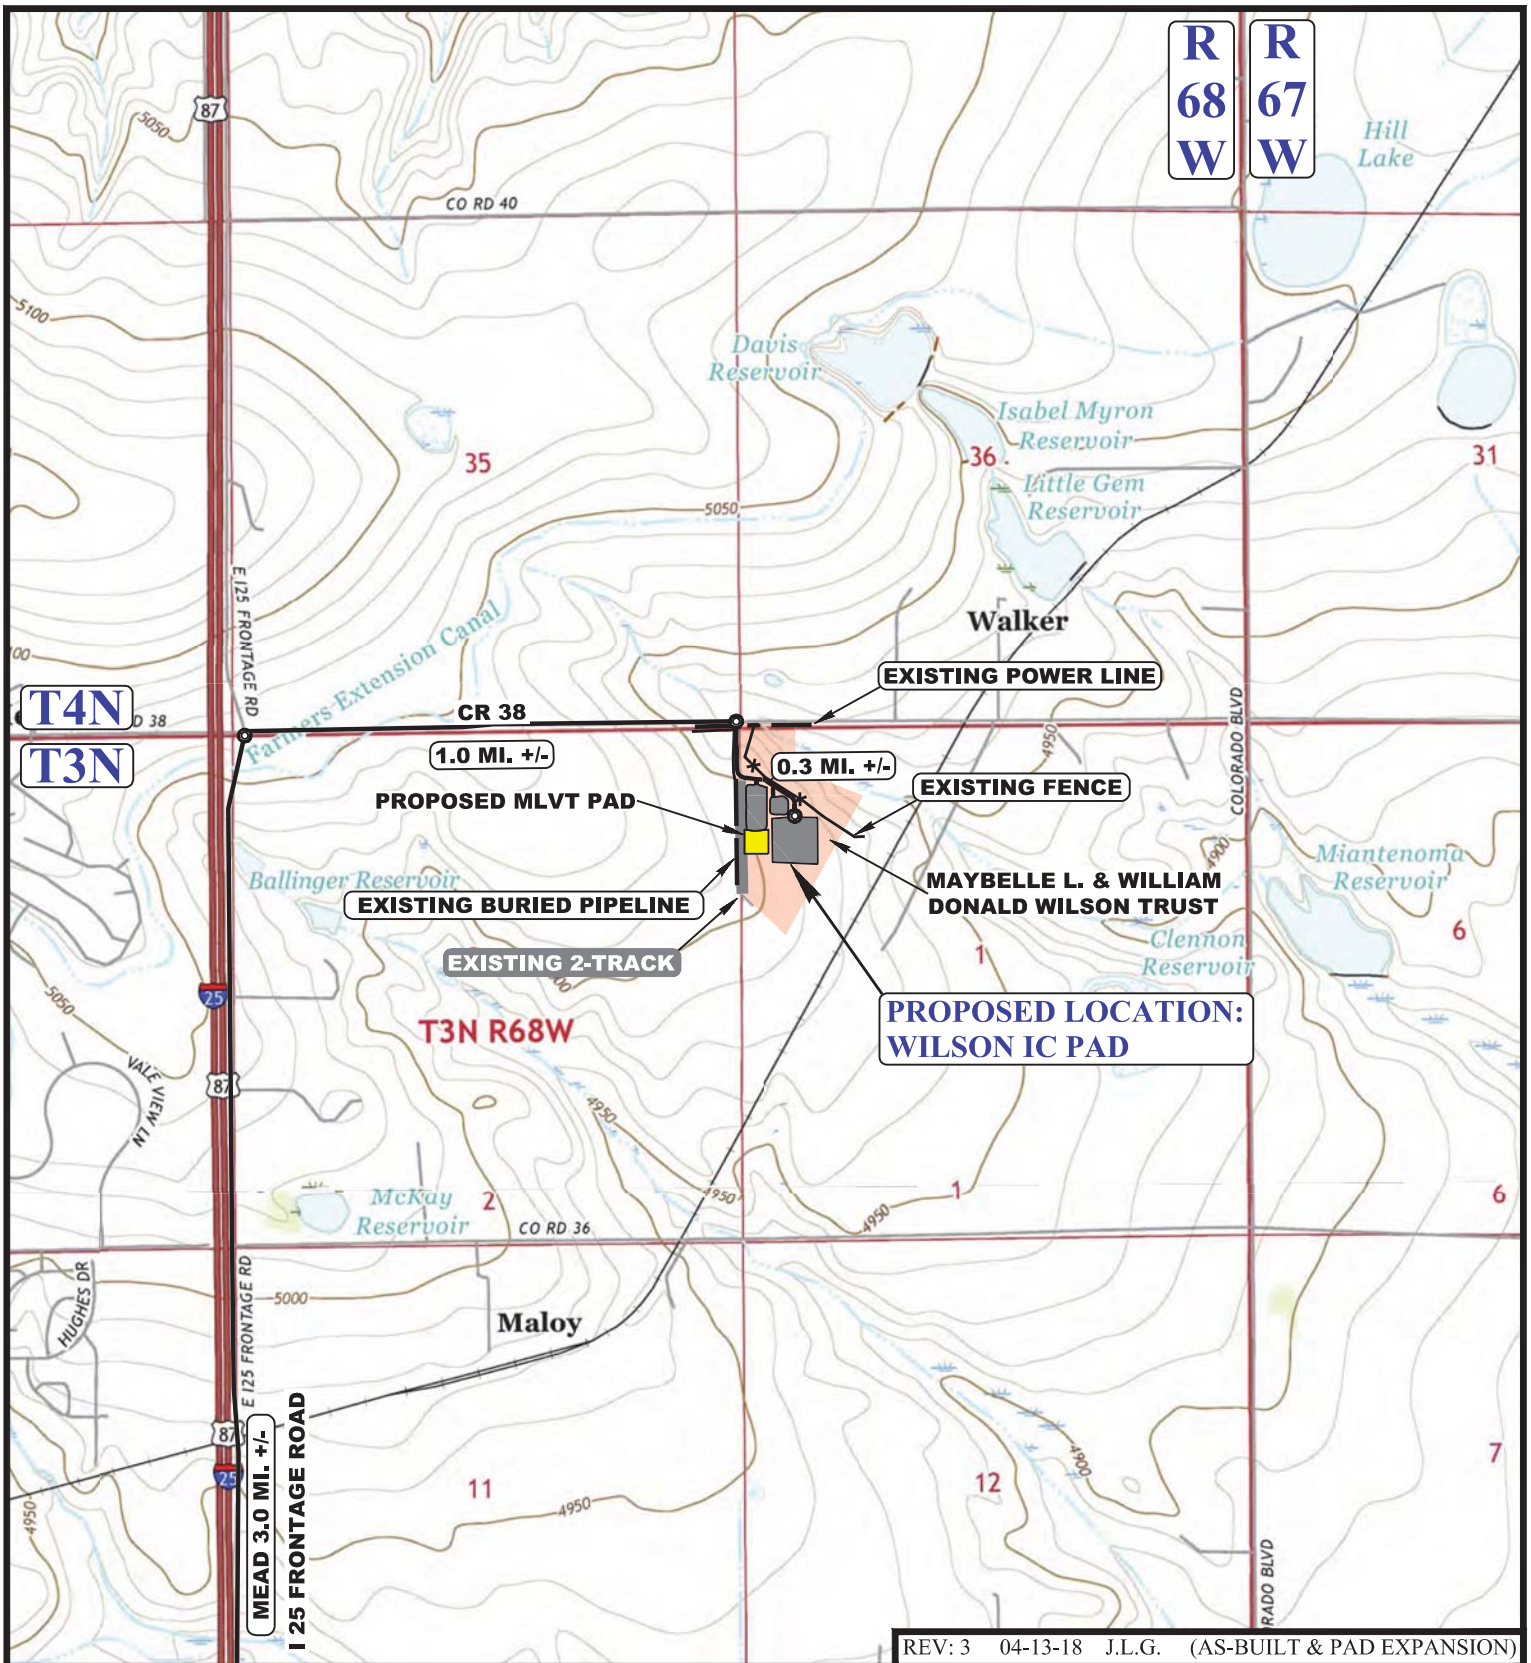

NOTE: PARCEL DATA SHOWN HAS BEEN OBTAINED FROM VARIOUS SOURCES AND SHOULD BE USED FOR MAPPING, GRAPHIC AND PLANNING PURPOSES ONLY. NO WARRANTY IS MADE BY UINTAH ENGINEERING AND LAND SURVEYING (UELS) FOR ACCURACY OF THE PARCEL DATA.

LEGEND:

- EXISTING ROAD
- PROPOSED ROAD
- EXISTING 2-TRACK
- EXISTING FENCE
- EXISTING POWER LINE
- EXISTING BURIED PIPELINE



GREAT WESTERN OPERATING COMPANY

WILSON IC PAD
 NW 1/4 NW 1/4, SECTION 1, T3N, R68W, 6th P.M.
 WELD COUNTY, COLORADO



UELS, LLC
 Corporate Office * 85 South 200 East
 Vernal, UT 84078 * (435) 789-1017

SURVEYED BY	J.F.	04-05-18	SCALE
DRAWN BY	M.F.D.	04-19-16	1 : 24,000
ACCESS ROAD MAP			TOPO B