

WELL LOCATION AS-BUILT MCKENNEY #5

R 64W



01838645


NE COR. SEC. 6
FOUND 3 1/4" ALUM.
CAP LS 10855



RECEIVED

FEB 01 2008

COGCC

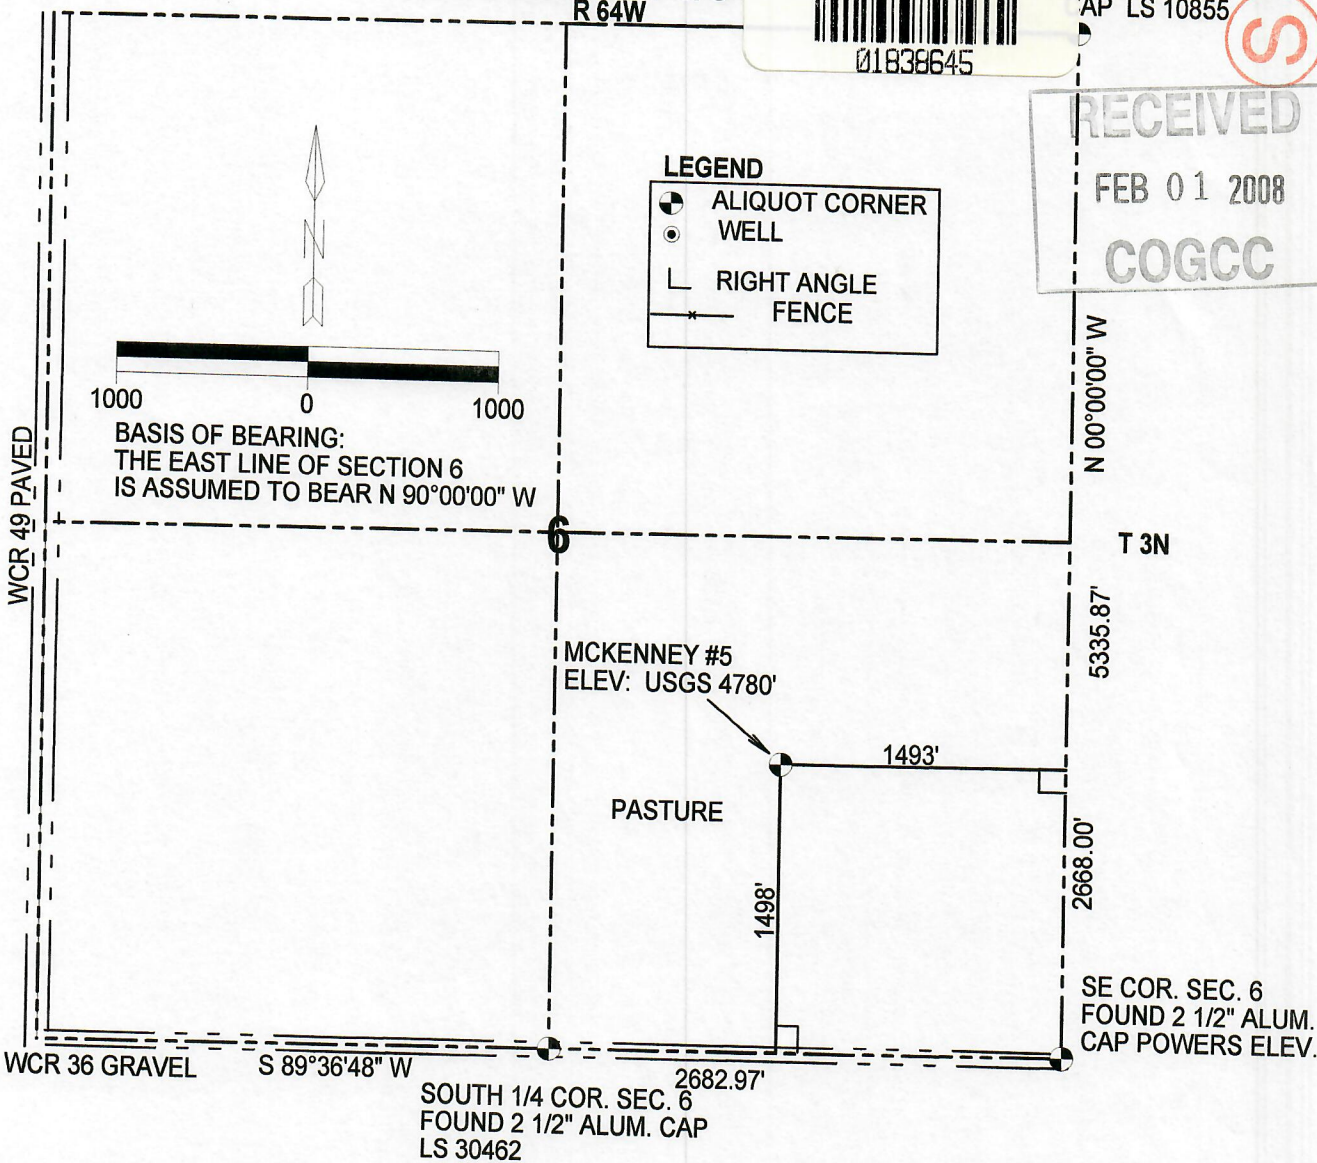

IN ACCORDANCE WITH A REQUEST FROM MERIT ENERGY COMPANY THE UNDERSIGNED HAS DETERMINED THE LOCATION OF THE MCKENNEY #5 WELL TO BE 1493' FEL AND 1498' FSL, SECTION 6, TOWNSHIP 3 NORTH, RANGE 64 WEST OF THE 6TH PRINCIPAL MERIDIAN, WELD COUNTY, COLORADO. FIELD SURVEY DATE: DECEMBER 17, 2007

GPS DATA

NORTH 40.25119° NAD 1983
WEST 104.58950°
ELEV: 4780'
PDOP: 4.0

SURVEYOR STATEMENT

I, ROBERT D. THOMAS DO HEREBY STATE THAT THIS OIL AND, OR GAS WELL LOCATION AS-BUILT SURVEY WAS PREPARED FOR MERIT ENERGY COMPANY. IT IS NOT A SURVEY PLAT OR IMPROVEMENT SURVEY PLAT AND IS NOT TO BE RELIED UPON FOR THE ESTABLISHMENT OF FENCES, BUILDINGS OR OTHER FUTURE IMPROVEMENT LINES.

12/17/07
DATE

Robert D. Thomas

ROBERT D. THOMAS
COLORADO REGISTERED LAND SURVEYOR
NUMBER 11399



THOMAS SURVEY SERVICES, LLC
2619 WEST 11TH STREET ROAD, SUITE 24
GREELEY, COLORADO 80634
TELEPHONE: (970) 304-0984

PROJECT: 0711.010
DRAWING: MERIT MCKENNEY #5 AS BUILT