


**Castle Springs Federal B Pad
As-Built Survey
Section's 8 & 17, Township 7 South,
Range 91 West of the 6th P.M.
County of Garfield, State of Colorado**


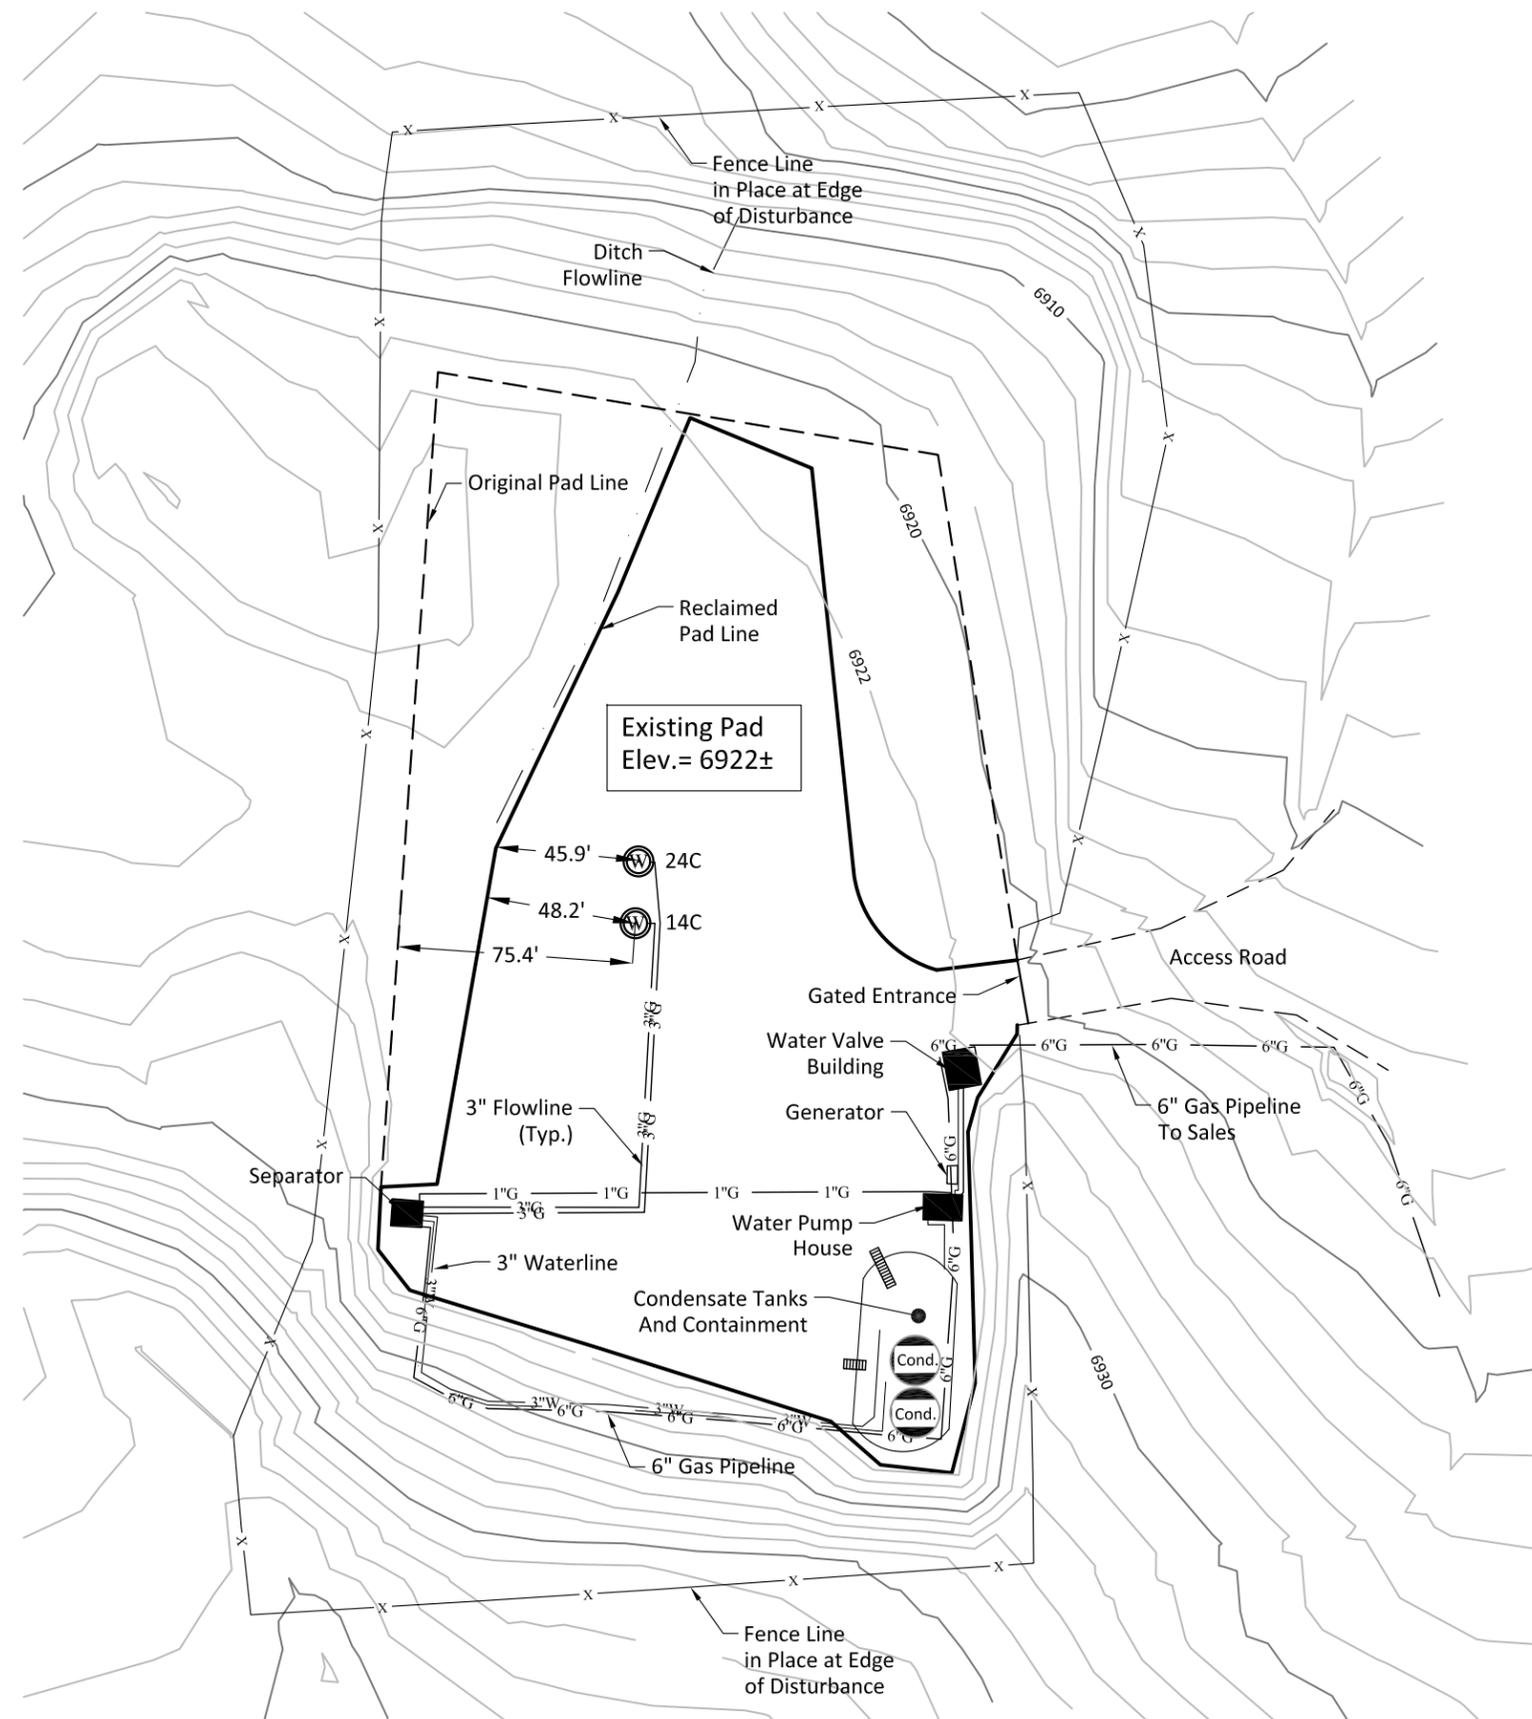


Notes:

- 1) The Date Of This Survey Was June 18, 2018.
- 2) Units Of Measure For All Dimensions Shown Hereon Is U.S. Survey Feet.
- 3) Elevations Are Based On NAVD 1988.
- 4) Facilities shown are Existing Unless Otherwise Noted.

Surveyor's Certificate

I, Scott Aibner a Registered Land Surveyor, Licensed Under The Laws Of The State Of Colorado Do Hereby Certify That The Survey Shown Hereon Was Prepared By River Valley Survey, Inc., For Ursa Operating Company, LLC. By Me Or Under My Direct Supervision And That This As-Built Survey Is A True Representation Thereof.

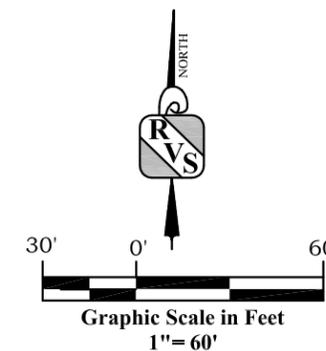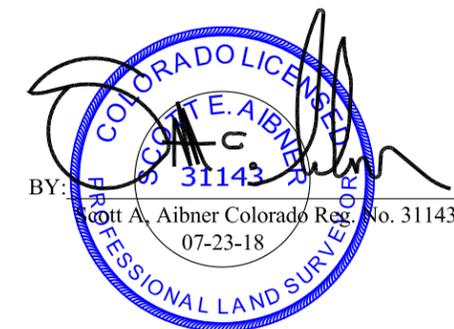

<p>River Valley Survey, Inc. 110 East 3rd. Street, Suite 213 Rifle, Colorado 81650 Ph: 970-379-7846</p>	<p>Ursa OPERATING COMPANY</p>
<p>Project: - RVS 06001-41B</p>	<p>Field Date: 06-18-18 Scale: 1"= 60'</p>
<p>Date: 07-23-18</p>	<p>Sheet: 1 of 1</p>
<p>Rev:</p>	<p>By: TJK</p>