


WELL AS-BUILT SURVEY

TRUE RANCH FEE 502-2326H

SECTION 23, TOWNSHIP 12 NORTH, RANGE 65 WEST OF THE 6TH P.M.

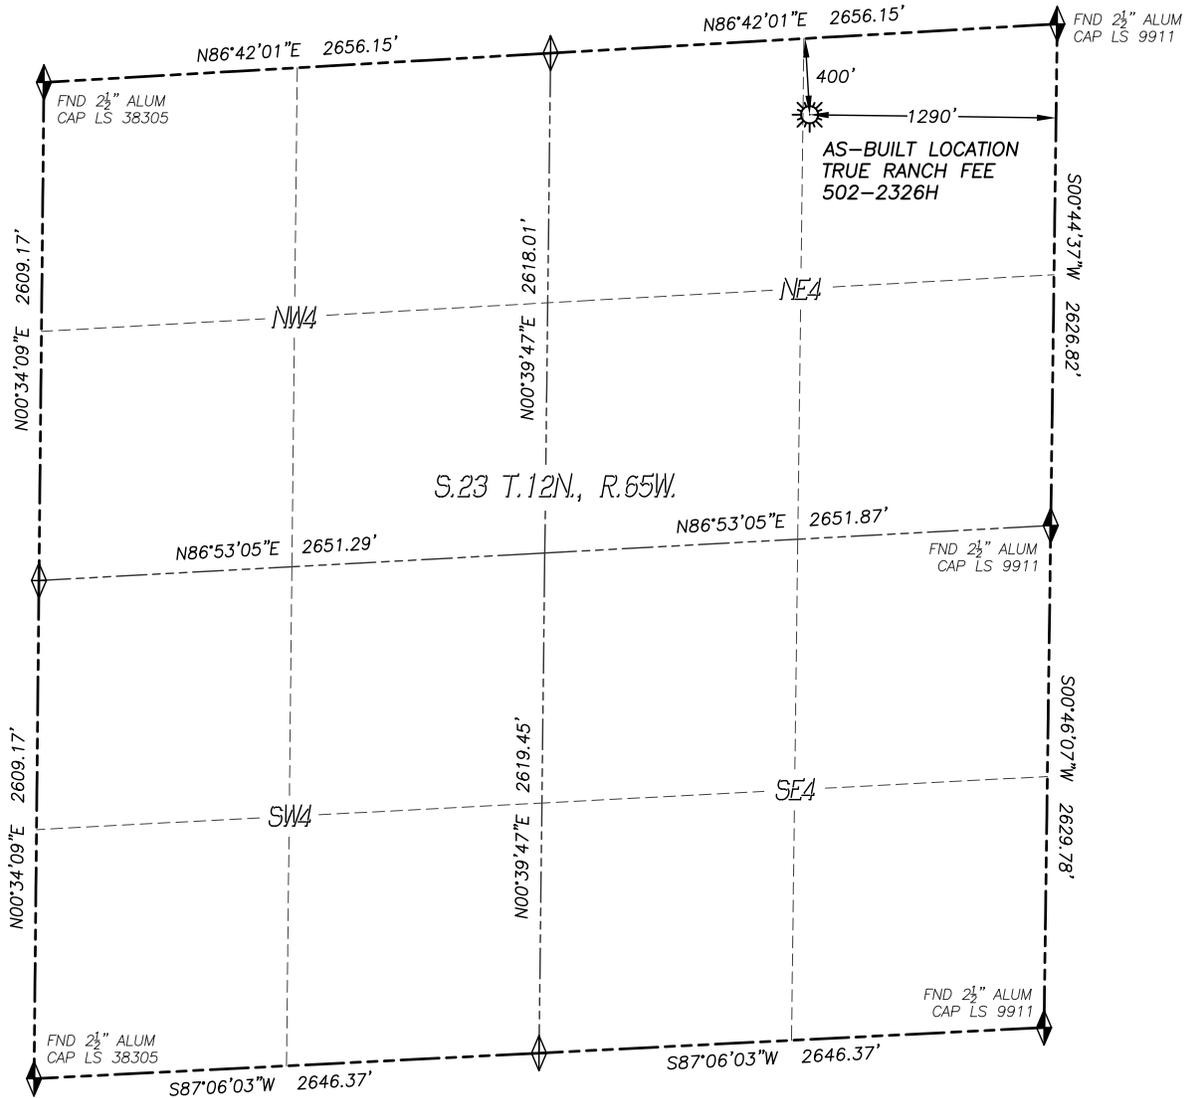


IN ACCORDANCE WITH A REQUEST FROM CLEAR CREEK RESOURCE PARTNERS, DALEY LAND SURVEYING, INC. HAS DETERMINED THE SURFACE LOCATION OF THE TRUE RANCH FEE 502-2326H WELL TO BE 400' FNL, 1290' FEL, AS MEASURED AT NINETY (90) DEGREES FROM THE SECTION LINES OF SECTION 23, TOWNSHIP 12 NORTH, RANGE 65 WEST, OF THE 6TH PRINCIPAL MERIDIAN, WELD COUNTY, COLORADO.

I HEREBY STATE THAT THIS WELL AS-BUILT SURVEY WAS PREPARED BY ME OR UNDER MY DIRECT SUPERVISION, THAT THE WORK WAS COMPLETED ON 11/29/2018 FOR AND ON BEHALF OF CLEAR CREEK RESOURCE PARTNERS, AND THAT THIS MAP DOES NOT REPRESENT A BOUNDARY SURVEY, IT IS NOT A LAND SURVEY PLAT OR AN IMPROVEMENT SURVEY PLAT AND IT IS NOT TO BE RELIED UPON FOR THE ESTABLISHMENT OF FENCE, BUILDING OR OTHER FUTURE IMPROVEMENT LINES.

NOTES:


- 1) BEARINGS FOR THIS MAP ARE ASSUMED AND BASED UPON GPS OBSERVATIONS MADE BETWEEN MONUMENTS LOCATED AT THE NORTHEAST CORNER AND THE EAST QUARTER CORNER OF SECTION 23, TOWNSHIP 12 NORTH, RANGE 65 WEST.
- 2) HORIZONTAL DATUM IS NAD83.
- 3) VERTICAL DATUM IS NAVD88 AND ORIGINATES FROM THE LOCAL C.O.R.S. NETWORK, UTILIZING THE GEOID12A MODEL.
- 4) INST. OPERATOR: SCOTT ESTABROOKS

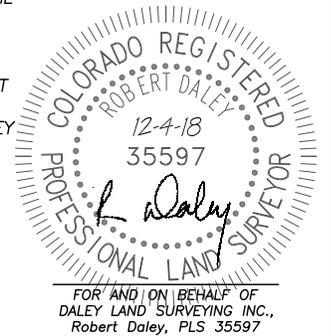

NAD 83 LATITUDE AND LONGITUDE

SURFACE LOCATION:
 LATITUDE: N40.99871°
 LONGITUDE: W104.62344°
 ELEV.: 5853'
 PDOP.: 1.2
 QTR/QTR: NE4/NE4

- LEGEND**
- FOUND MONUMENT AS DESCRIBED
 - PROPOSED WELL
 - EXISTING WELL
 - BOTTOM HOLE
 - ABANDONED WELL
 - CALCULATED POSITION

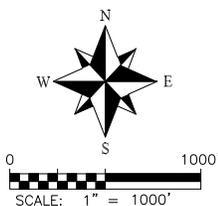

CLEAR CREEK
Resource Partners

DALEY LAND SURVEYING, INC.
 PARKER, COLORADO
 303.953.9841

\\Survey\1707003\Drawings\True Ranch Fee 502-2326 As-Built.dwg