


WELL AS-BUILT SURVEY

PENROD 4-15 1

SECTION 4, TOWNSHIP 1 SOUTH, RANGE 65 WEST OF THE 6TH P.M.

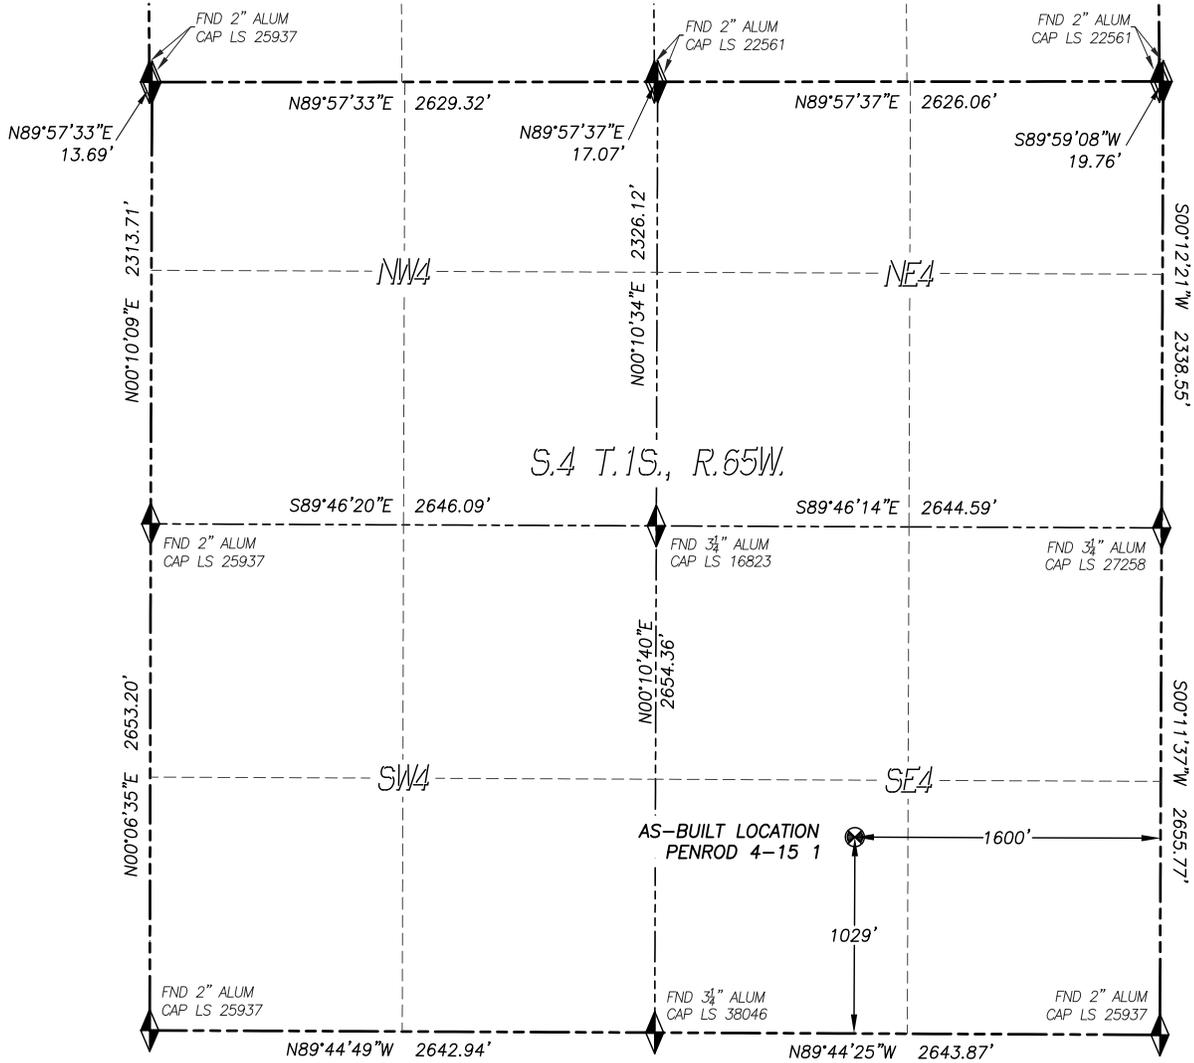


IN ACCORDANCE WITH A REQUEST FROM CONFLUENCE RESOURCES., DALEY LAND SURVEYING, INC. HAS DETERMINED THE SURFACE LOCATION OF THE PENROD 4-15 1 WELL TO BE 1029' FSL, 1600' FEL, AS MEASURED AT NINETY (90) DEGREES FROM THE SECTION LINES OF SECTION 4, TOWNSHIP 1 SOUTH, RANGE 65 WEST, OF THE 6TH PRINCIPAL MERIDIAN, ADAMS COUNTY, COLORADO.

I HEREBY STATE THAT THIS WELL AS-BUILT SURVEY WAS PREPARED BY ME OR UNDER MY DIRECT SUPERVISION, THAT THE WORK WAS COMPLETED ON 9/18/2018 FOR AND ON BEHALF OF CONFLUENCE RESOURCES., AND THAT THIS MAP DOES NOT REPRESENT A BOUNDARY SURVEY, IT IS NOT A LAND SURVEY PLAT OR AN IMPROVEMENT SURVEY PLAT AND IT IS NOT TO BE RELIED UPON FOR THE ESTABLISHMENT OF FENCE, BUILDING OR OTHER FUTURE IMPROVEMENT LINES.


NOTES:

- 1) BEARINGS FOR THIS MAP ARE ASSUMED AND BASED UPON GPS OBSERVATIONS MADE BETWEEN MONUMENTS LOCATED AT THE WEST QUARTER CORNER AND NORTHWEST CORNER OF SECTION 4, T.1S., R.65W.
- 2) HORIZONTAL DATUM IS NAD83.
- 3) VERTICAL DATUM IS NAVD88 AND ORIGINATES FROM THE LOCAL C.O.R.S. NETWORK, UTILIZING THE GEOID12A MODEL.
- 4) SURFACE USE: RANGELAND.
- 5) INST. OPERATOR: SCOTT ESTABROOKS.
- 6) THE WELL WAS NOT EXCAVATED, METAL LOCATOR WAS USED TO DETERMINE LOCATION.

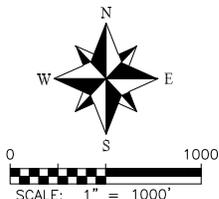

NAD 83 LATITUDE AND LONGITUDE

SURFACE LOCATION:
 LATITUDE: N39.98968°
 LONGITUDE: W104.66522°
 ELEV: 5130'
 PDOP: 1.6
 QTR/QTR: SW4/SE4

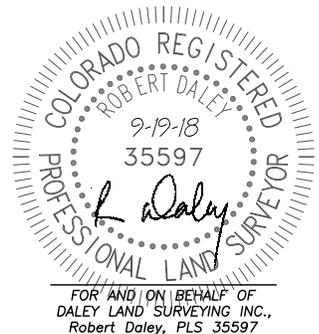

LOCAATION PICTURES

PENROD 4-15 1

SECTION 4, TOWNSHIP 1 SOUTH, RANGE 65 WEST OF THE 6TH P.M.

DATE: 9/18/18



LOOKING NORTH



LOOKING WEST



LOOKING EAST



LOOKING SOUTH