

As-Built Survey



Petroleum Resource Management Corp.

WPU-36-1V Location

Located in Government Lot 19, Section 36
T. 11 N., R. 89 W., 6th P.M.
Moffat County, Colorado

Notes:

- This survey was performed per the clients request for an Asbuilt Survey of the area shown hereon.
- Date of field survey: pad, equipment and well as-builts were completed on September 20, 2016, Cuttings Stockpiles removed from drawing on May 15, 2018
- Units of Linear Measurement: U.S. Survey Feet.
- Vertical Datum: NAVD 88, based on an OPUS solution using Geoid 12A

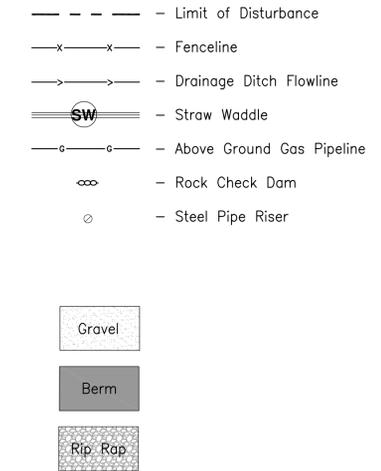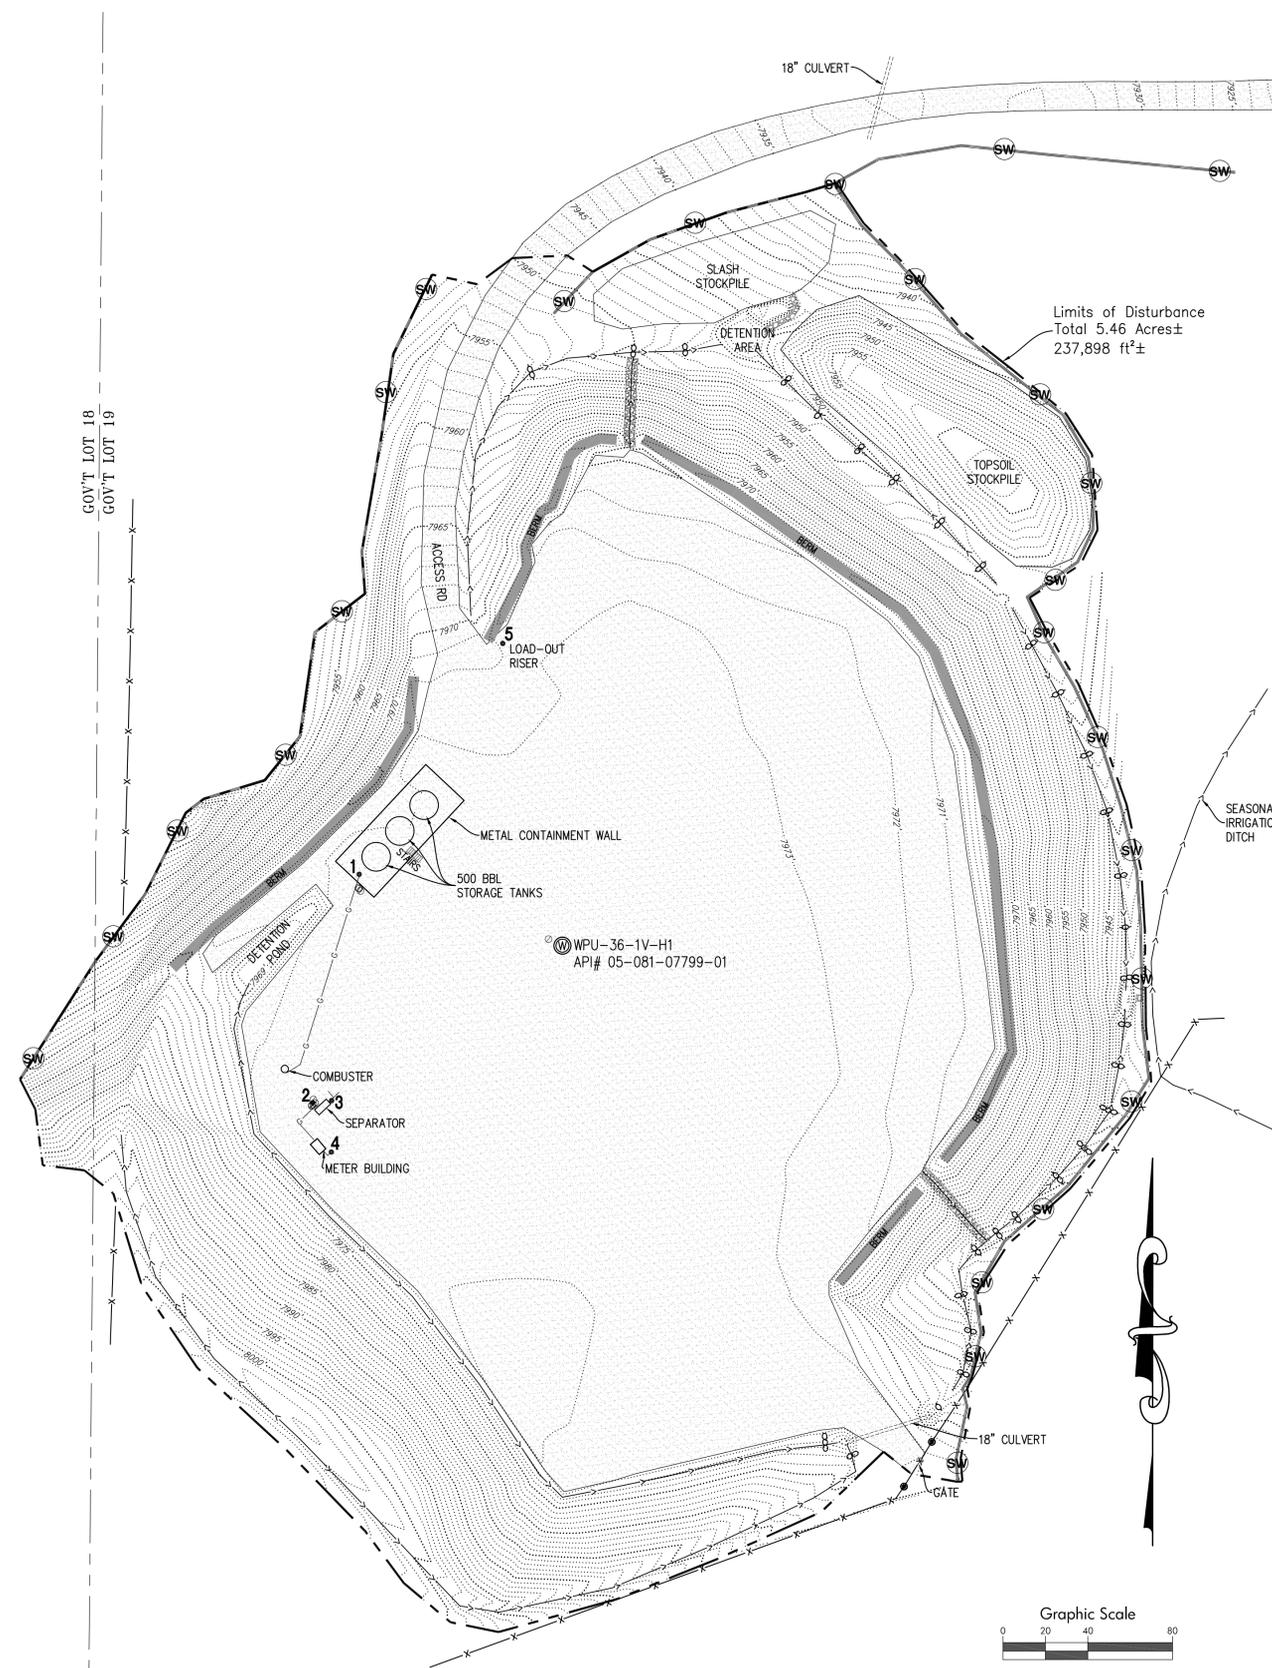

Well As-Built Location

Well No.	NAD 83 Latitude	NAD 83 Longitude	PDOP	Asbuilt Date	GPS Operator Name
WPU-36-1V-H1	40.860330	-107.325016	< 3.0	9/20/16	Mike Pinske

Pipe As-Built Locations

Pipe No.	NAD 83 Latitude	NAD 83 Longitude	PDOP	Asbuilt Date	GPS Operator Name
1	40.860417	-107.325364	< 3.0	9/20/16	Mike Pinske
2	40.860121	-107.325436	< 3.0	9/20/16	Mike Pinske
3	40.860125	-107.325404	< 3.0	9/20/16	Mike Pinske
4	40.860058	-107.325402	< 3.0	9/20/16	Mike Pinske
5	40.860718	-107.325128	< 3.0	9/20/16	Mike Pinske

I:\2013\2013-379_PRM_Corrmey\001-PRM-H-Dwg\Surf\Draw\Duncan_Asbuilt.dwg

Notice:
According to Colorado Law, you must commence any legal action based upon any defect in this survey within three years after you first discover such defect. In no event may any legal action based upon any defect in this survey be commenced more than ten years from the date of the certification shown hereon.

SGM
118 West Sixth Street, Suite 200
Glenwood Springs, CO 81601
970.945.1004 www.sgm-inc.com

Petroleum Resource Management Corp.
WPU-36-1V Location

#	Revision	Date	By
1	Added Asbuilt Pipe Locations	6/22/17	tab
2	Removed Cuttings Stockpiles	5/15/18	tab
3			
4			
5			

Asbuilt Survey

Job No.	2013-379.001	1
Drawn by:	TB	
Date:	9/23/16	
Approved:	REB	
File:	Duncan_Asbuilt	