



Lat40°, Inc. 6250 W. 10th Street, Unit 2, Greeley, CO 970-515-5294

ASBUILT SCALED FACILITY DRAWING


WILMOTH 4N64W5J PAD

SECTION: 5
TOWNSHIP: 4N
RANGE: 64W
6TH. P.M.
WELD COUNTY, CO

POINT	POINT DESCRIPTION	Latitude (NAD83)	Longitude (NAD83)	PDOP
A	PAD CORNER	40.34659	-104.58095	2.2
B	PAD CORNER	40.34653	-104.57868	1.6
C	PAD CORNER	40.34497	-104.57867	1.7
D	PAD CORNER	40.34455	-104.57893	1.6
E	PAD CORNER	40.34456	-104.58042	1.6
F	PAD CORNER	40.34470	-104.58114	1.6
G	PAD CORNER	40.34559	-104.58113	2.1
H	CONTAINMENT CORNER	40.34490	-104.58039	1.9
I	CONTAINMENT CORNER	40.34519	-104.58038	2.0
J	CONTAINMENT CORNER	40.34547	-104.58090	1.6
K	CONTAINMENT CORNER	40.34600	-104.58037	3.1
1	WILMOTH 5J-232	40.34576	-104.57952	1.6
2	WILMOTH 5A-312	40.34572	-104.57952	1.6
3	WILMOTH 5A-202	40.34568	-104.57952	1.6
4	WILMOTH 5A-302	40.34564	-104.57953	1.5
5	WILMOTH 5A-232	40.34560	-104.57953	1.5
6	WILMOTH 5K-312	40.34555	-104.57953	1.5
7	WILMOTH 5J-234	40.34551	-104.57953	1.6
8	WILMOTH 5A-314	40.34547	-104.57953	1.6
9	WILMOTH 5A-214	40.34543	-104.57954	1.6
10	WILMOTH 5A-304	40.34539	-104.57954	1.6
11	WILMOTH 5A-204	40.34535	-104.57954	1.6
12	WILMOTH 5A-334	40.34531	-104.57954	1.6


LEGEND

⊕	EXISTING WELL HEAD	—	WELL FLOWLINE
T	EXISTING OIL TANK	—	OIL DUMP LINE
W	EXISTING WATER TANK	—D	BYPASS/ DRAIN LINE
S	EXISTING SEPARATOR	—W	WATER DUMP LINE
B	EXISTING ECD	—●—	FUEL SUPPLY LINE
M	EXISTING METER	—	BACKPRESSURE LINE
BC	BLOW CASE	—	LACT LINE
LACT	LACT UNIT	—G	BELOW GROUND SALES LINE
BB	BUFFER BOTTLE / SCRUBBER	—	CONTAINMENT FENCE
FS	FUEL STORAGE TANK	EIAC	Electric Instrument Air Compressor
-SV-	SURGE VESSEL		

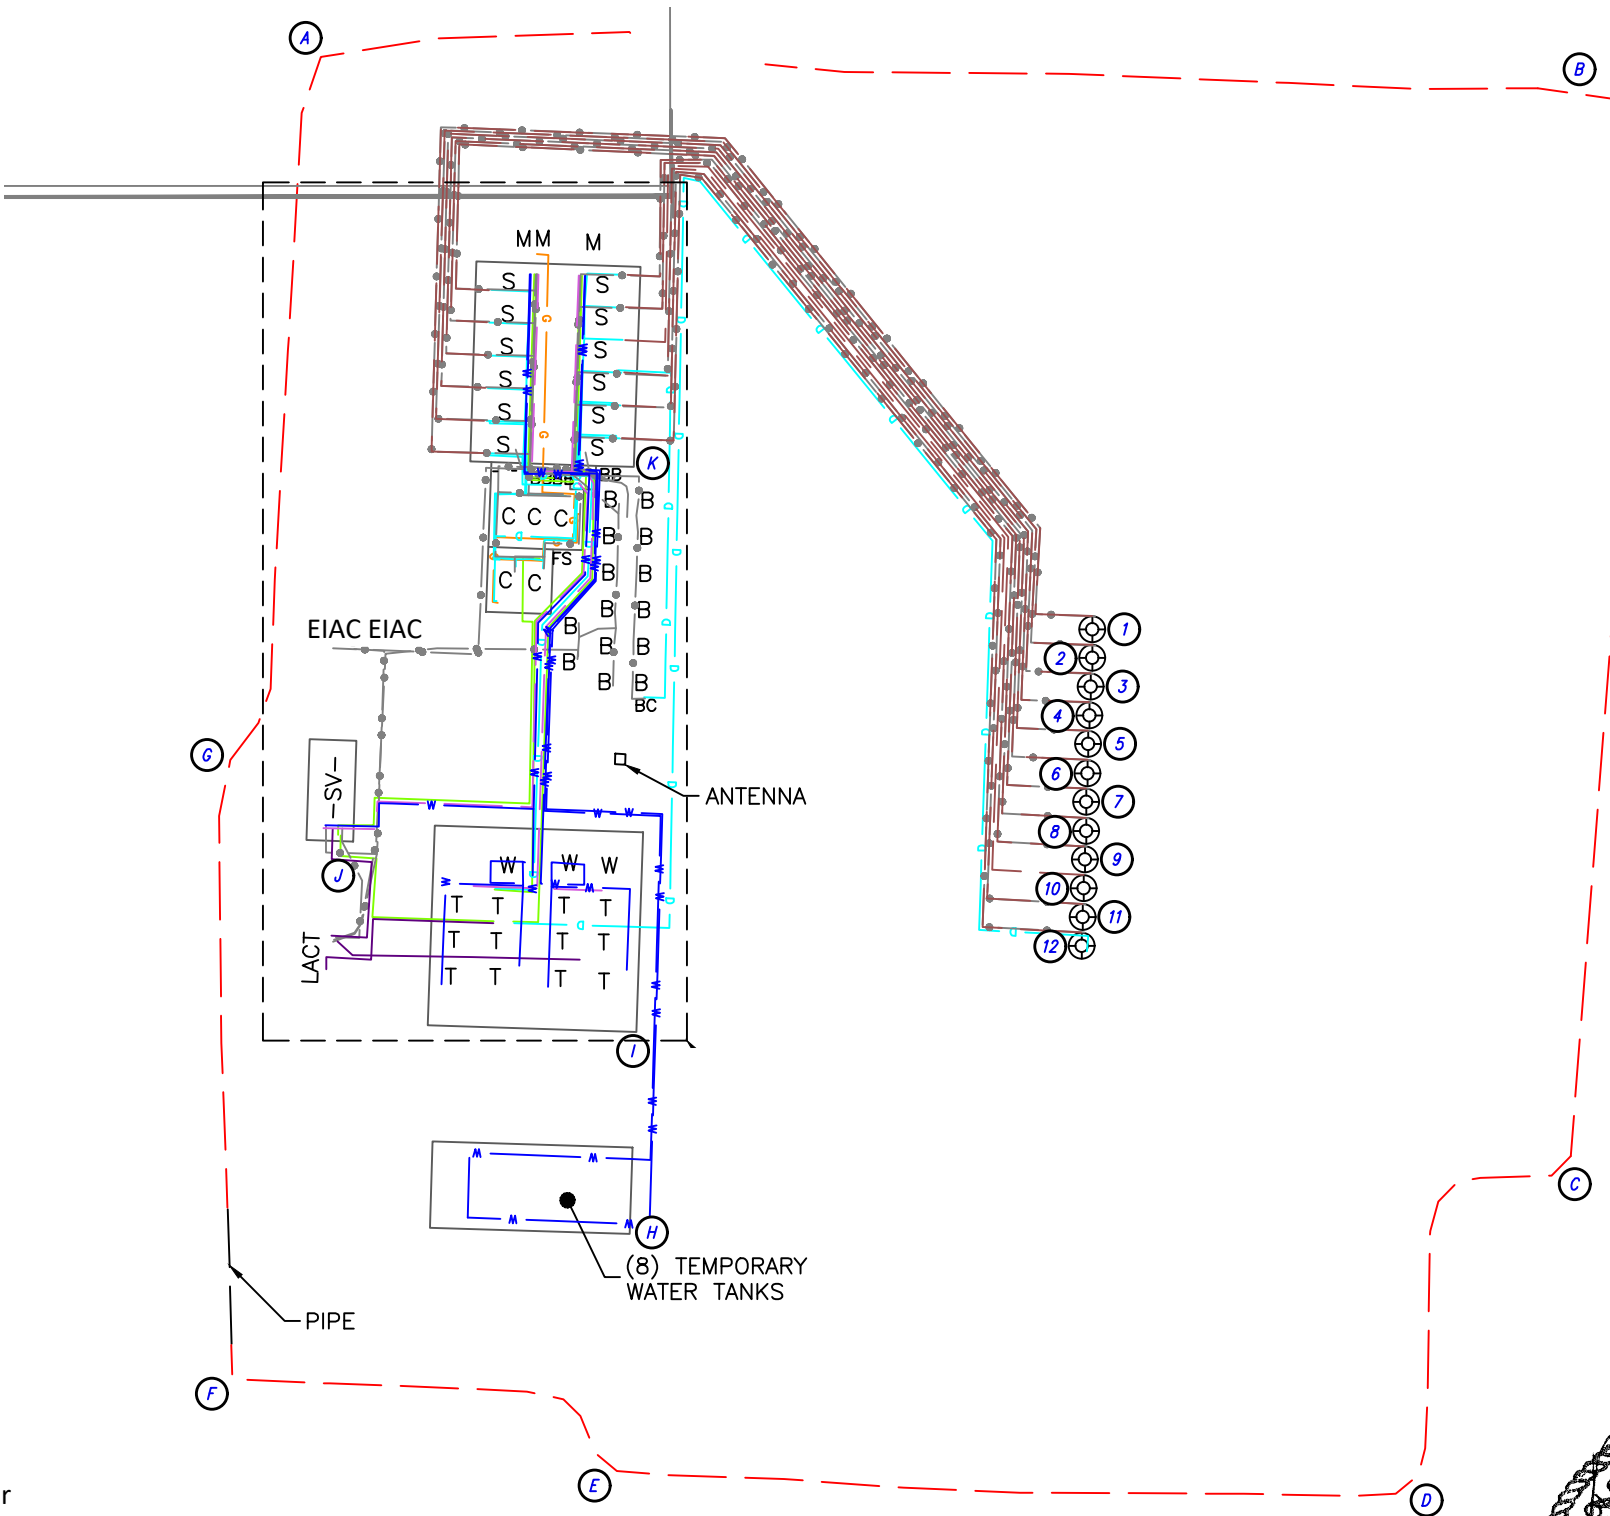

TOTAL DISTURBED AREA OF LOCATION: ±11.4 ACRES

- NOTE:
- 1) Bearings shown are Grid Bearings of the Colorado State Plane Coordinate System, North Zone, North American Datum 1983. The lineal dimensions as contained herein are based upon the "U.S. Survey Foot."
 - 2) Ground elevations are based on an observed GPS elevation (NAVD 1988 DATUM).
 - 3) Latitudes and Longitudes shown have been obtained from a field survey. (NAD 83 DATUM)
 - 4) This map does not represent a boundary survey
 - 5) DATE OF FIELD SURVEY: 2019/11/22
 - 6) INSTRUMENT OPERATOR: SCOTT SHERARD

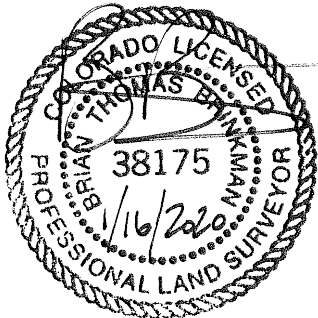

Brian T. Brinkman—On behalf of Lat40°, Inc.
Colorado Licensed Professional
Land Surveyor No. 38175
DATE: 1/16/2020
PROJECT#: 2019073