


K:\CIVITAS RESOURCES\2021\2021_131_WAKE_FORK_45_T6N_65W_SEC_32\DWG\WAKE_FORK_45.DWG, 12/8/2021 8:16:52 AM, jake

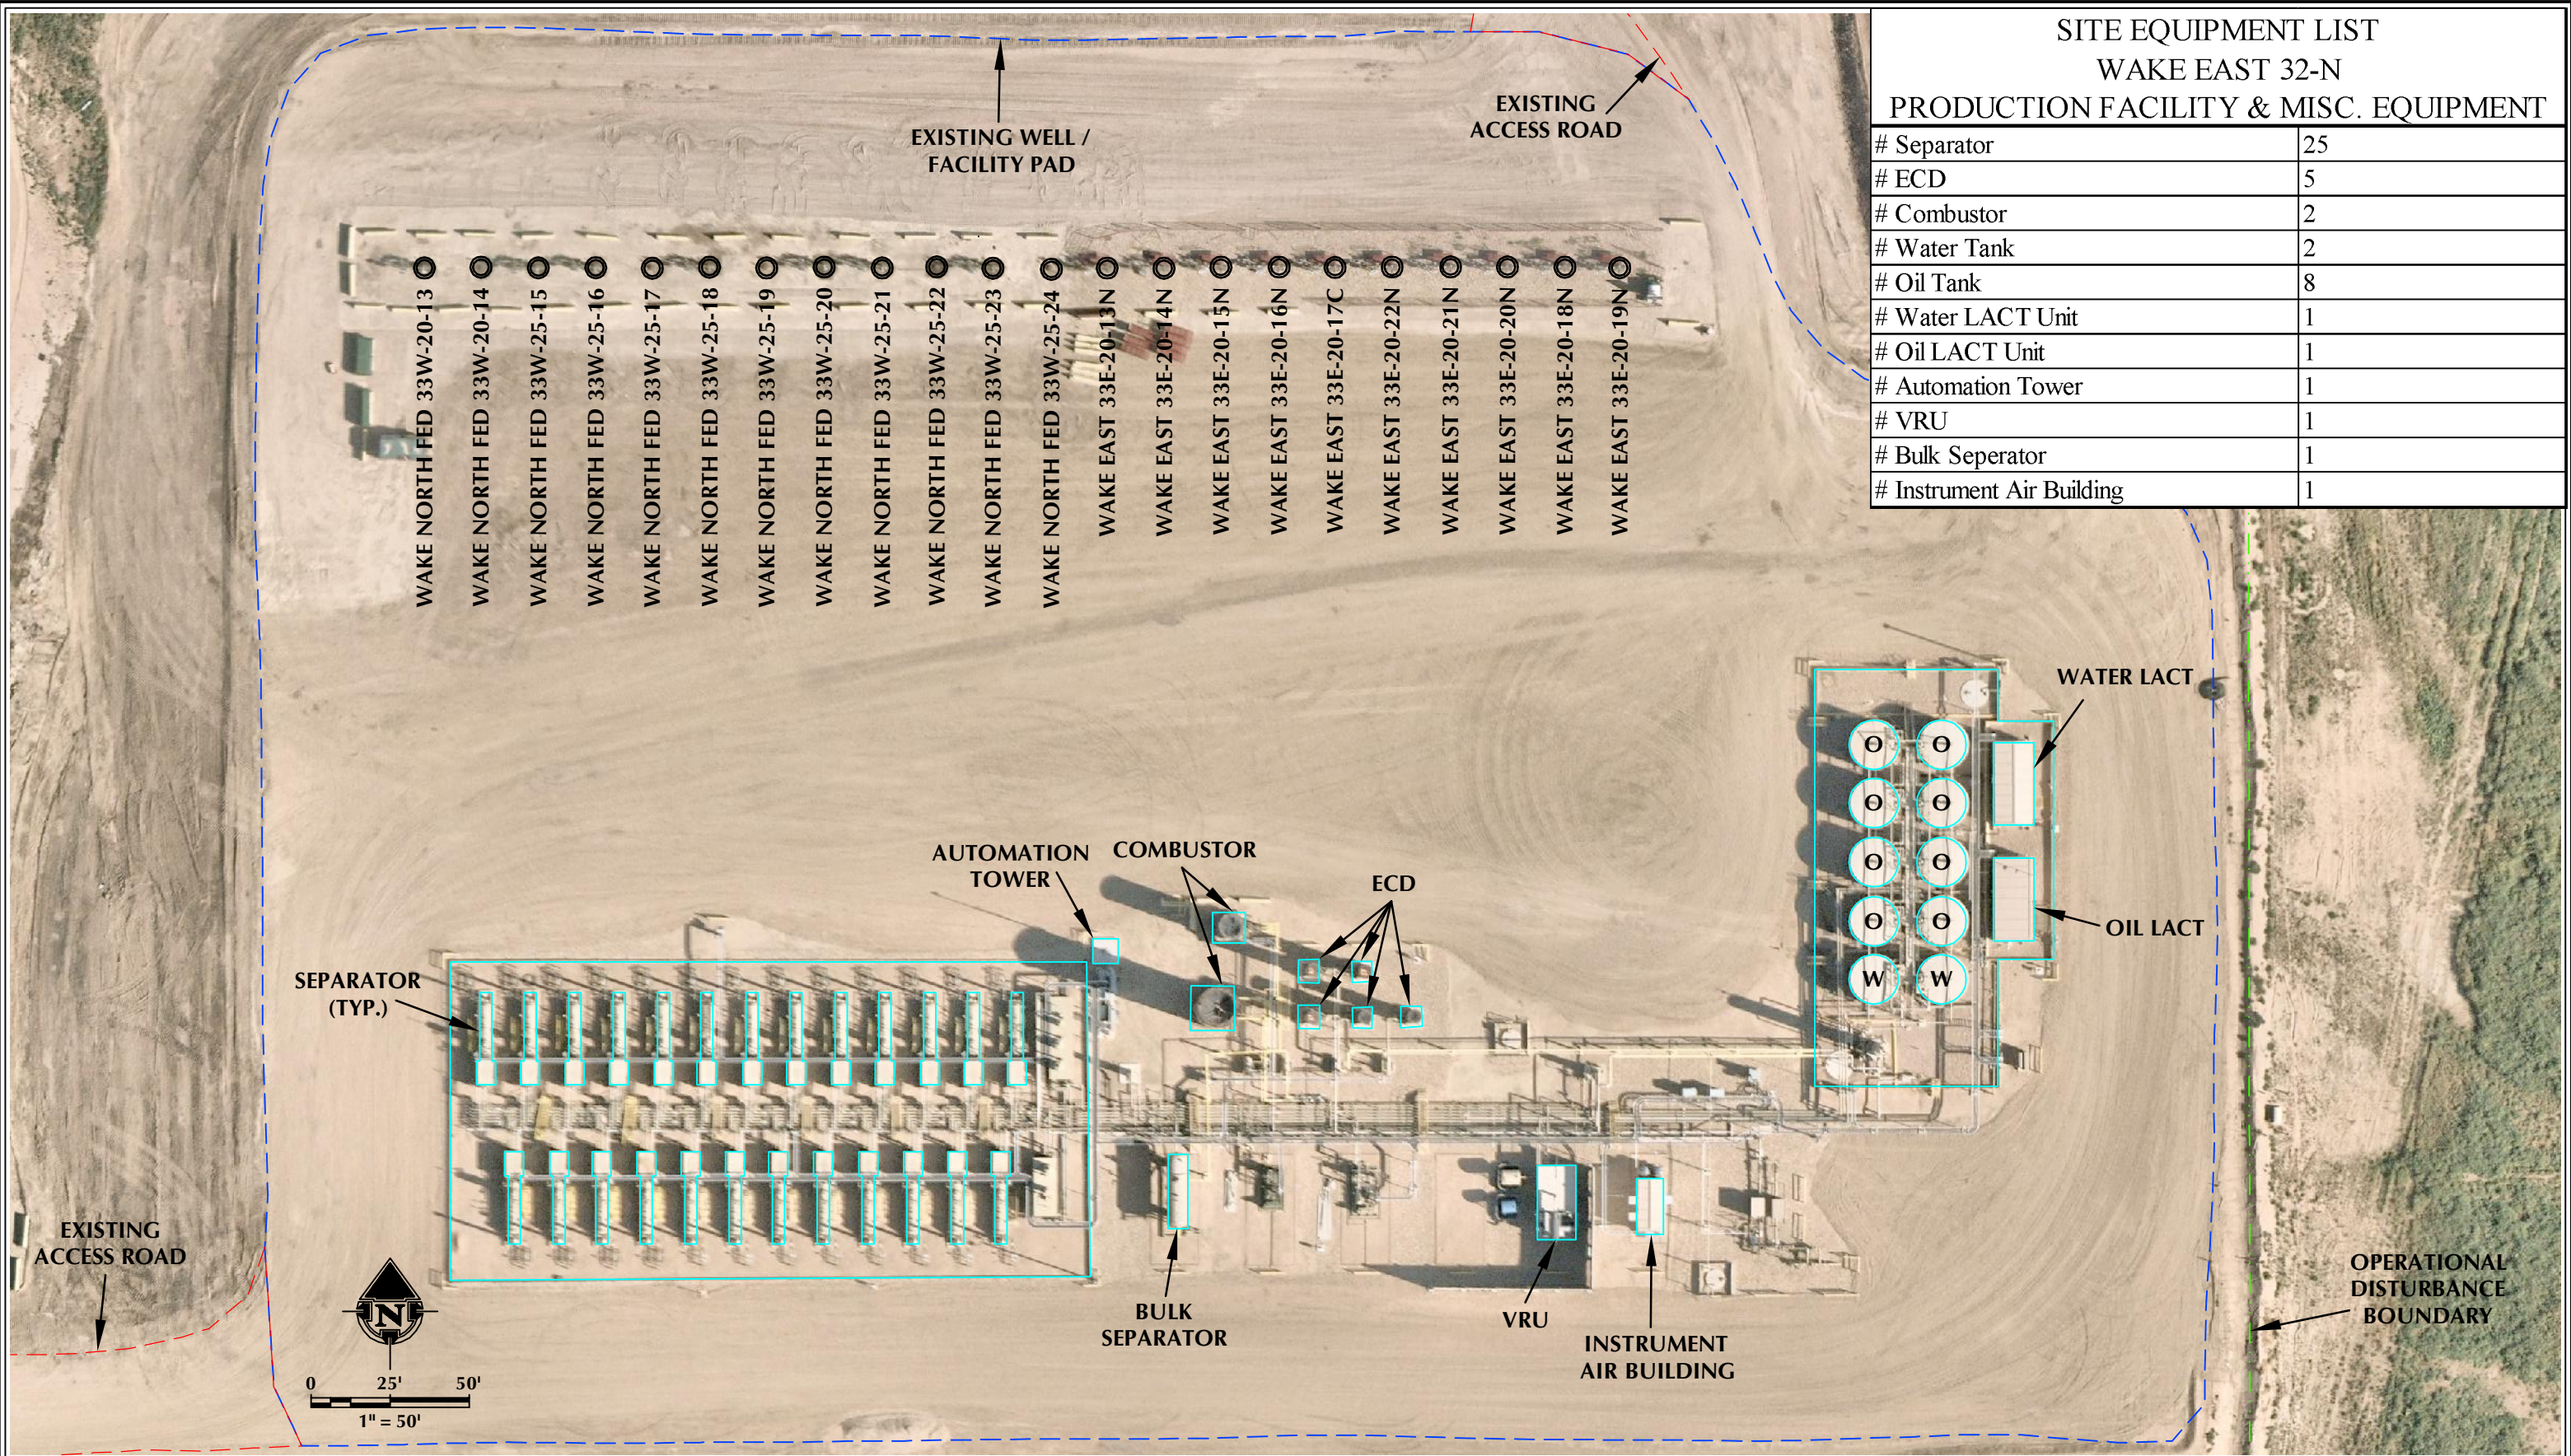

| SITE EQUIPMENT LIST | |
|---------------------------------------|----|
| WAKE EAST 32-N | |
| PRODUCTION FACILITY & MISC. EQUIPMENT | |
| # Separator | 25 |
| # ECD | 5 |
| # Combustor | 2 |
| # Water Tank | 2 |
| # Oil Tank | 8 |
| # Water LACT Unit | 1 |
| # Oil LACT Unit | 1 |
| # Automation Tower | 1 |
| # VRU | 1 |
| # Bulk Seperator | 1 |
| # Instrument Air Building | 1 |

| | | | | | |
|--|---|--|--|--|---|
| | <p>DATA SOURCES: - AERIAL COURTESY OF NEARMAP.</p> | <div><p>LOVELAND OFFICE 6706 North Franklin Avenue Loveland, Colorado 80538 Phone 970-776-4331</p><p>SHERIDAN OFFICE 1095 Saberton Avenue Sheridan, Wyoming 82801 Phone 307-674-0609</p><p>CONSULTING, LLC</p></div> | <p>Prepared For:</p> <div><p>410 17TH STREET, SUITE 1400 DENVER, CO 80202</p></div> | <p>SCALE: 1" = 50'</p> <p>DATE SURVEYED: 11/22/21</p> <p>DATE: 12/8/21</p> <p>DRAFTER: GLK</p> <p>REVISED:</p> | <p>AS-BUILT SCALED FACILITY DRAWING</p> <p>WAKE EAST 32-N</p> <p>LOCATED IN SECTION 32, T6N, R65W, 6TH P.M.</p> <p>WELD COUNTY, COLORADO</p> |
|--|---|--|--|--|---|