


# WELL AS-BUILT SURVEY CANAL 22-2-2L

SECTION 22, TOWNSHIP 1 NORTH, RANGE 65 WEST OF THE 6TH P.M., WELD COUNTY

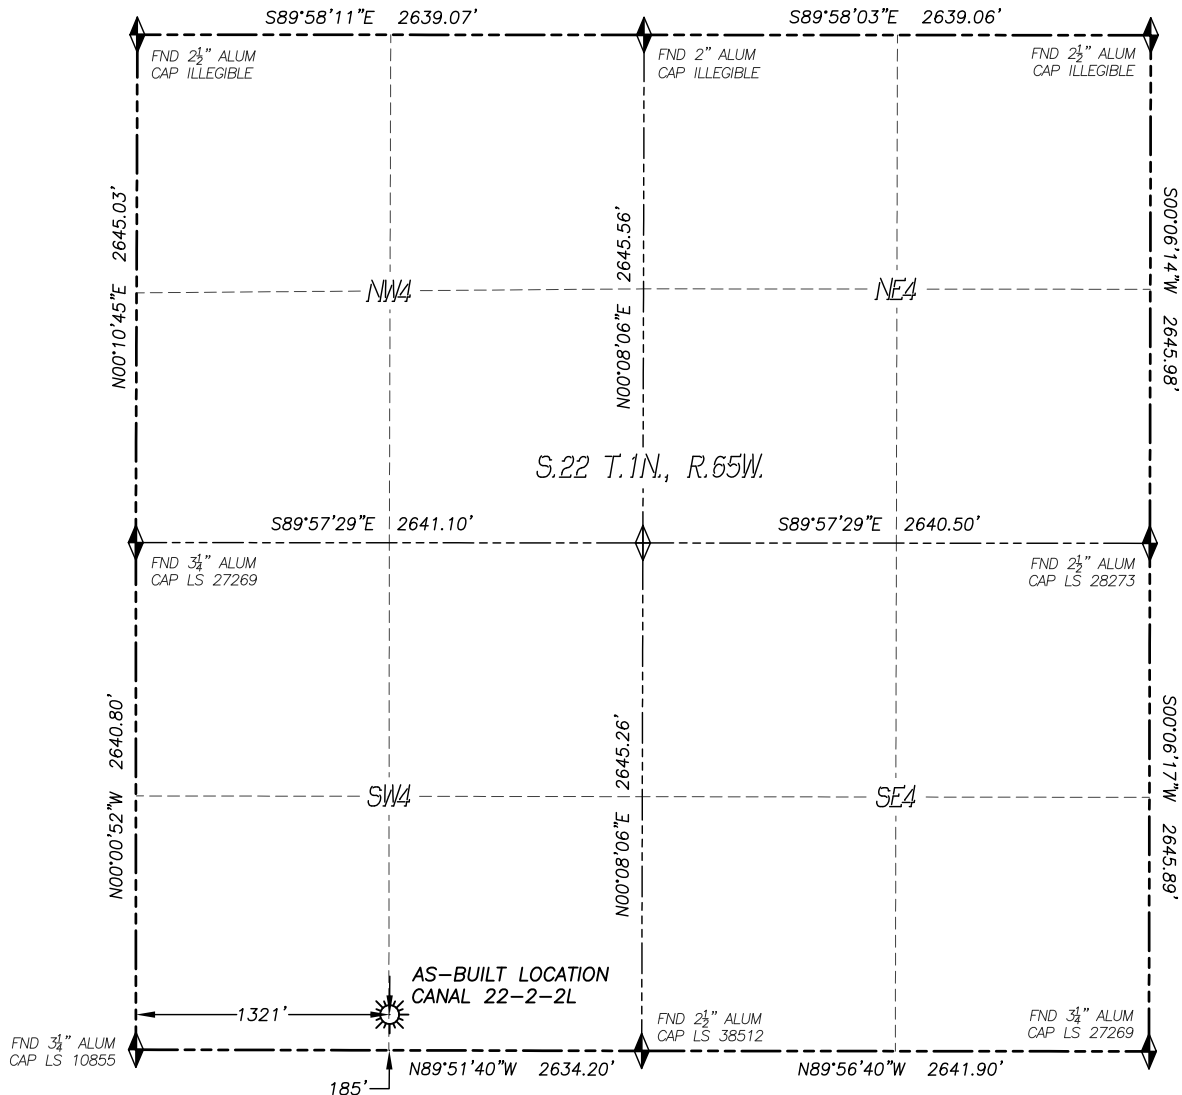


IN ACCORDANCE WITH A REQUEST FROM CONFLUENCE RESOURCES, DALEY LAND SURVEYING, INC. HAS DETERMINED THE SURFACE LOCATION OF THE CANAL 22-2-2L WELL TO BE 185' FSL, 1321' FWL, AS MEASURED AT NINETY (90) DEGREES FROM THE SECTION LINES OF SECTION 22, TOWNSHIP 1 NORTH, RANGE 65 WEST, OF THE 6TH PRINCIPAL MERIDIAN, WELD COUNTY, COLORADO.

I HEREBY STATE THAT THIS WELL AS-BUILT SURVEY WAS PREPARED BY ME OR UNDER MY DIRECT SUPERVISION, THAT THE WORK WAS COMPLETED ON 9/17/2021 FOR AND ON BEHALF OF CONFLUENCE RESOURCES, AND THAT THIS MAP DOES NOT REPRESENT A BOUNDARY SURVEY, IT IS NOT A LAND SURVEY PLAT OR AN IMPROVEMENT SURVEY PLAT AND IT IS NOT TO BE RELIED UPON FOR THE ESTABLISHMENT OF FENCE, BUILDING OR OTHER FUTURE IMPROVEMENT LINES.

## NOTES:

- 1) BEARINGS FOR THIS MAP ARE ASSUMED AND REFERENCED TO THE SOUTH LINE OF THE SOUTHWEST QUARTER OF SECTION 22, T.1N., R.65W.
- 2) HORIZONTAL DATUM IS NAD83.
- 3) VERTICAL DATUM IS NAVD88 AND ORIGINATES FROM THE LOCAL C.O.R.S. NETWORK, UTILIZING THE GEOID18A MODEL.
- 4) INST. OPERATOR: KYLE DALEY

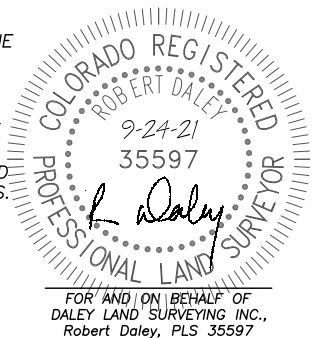

## NAD 83 LATITUDE AND LONGITUDE

### SURFACE LOCATION:

LATITUDE: N40.03017°  
LONGITUDE: W104.65487°  
ELEV.: 5094'  
PDOP.: 1.9  
QTR/QTR: SE4/SW4

- LEGEND**
- ◆ FOUND MONUMENT
  - ◊ CALCULATED POSITION
  - ☀ PROPOSED WELL
  - BOTTOM HOLE
  - ⊗ ABANDONED WELL
  - ⊗ EXISTING WELL

