

Legend

- Heaters
- ⊙ Combustors
- Engine Points
- - - Electric Lines
- ▭ Skids
- ▭ Tanks
- ▭ Separators
- ▭ Building
- ▭ Reclaimed Area
- ▭ Interim Reclamation

CIVITAS RESOURCES  
 AS-BUILT FACILITY DIAGRAM  
 FACILITY: RSU Anschutz Fed 4-62-11\_12 SE10  
 COGCC FACILITY # 454976  
 LOCATION: 104° 18'11"W 40° 19'26"N  
 WELD COUNTY, COLORADO  
 PAGE 1 OF 2

0 45 90 180 Feet



Initial Pad Disturbance

Reclaimed Disturbance

Wellheads

RSU Anschutz Fed  
4-62-11\_12 SE10

3VRTs

2VRUs

Proposed IA  
Skid Location

2 Gas Generators

LACT

LACT

Road Access  
Of Location Flow Lines


Interim As-Built Areas  
 Initial Pad Area = 9.14 Acres  
 Reclaimed Disturbance = 5.75 Acres  
 Interim Reclamation = 3.39 Acres

Prepared by  
**ECOPOINT, INC**  
 As of 6/1/2023

0 40 80 160 Feet



- Legend**
- Heaters
  - ⊙ Combustors
  - Engine Points
  - - - Electric Lines
  - Skids
  - Tanks
  - Separators
  - Building
  - ▨ Reclaimed Area
  - ▨ Interim Reclamation

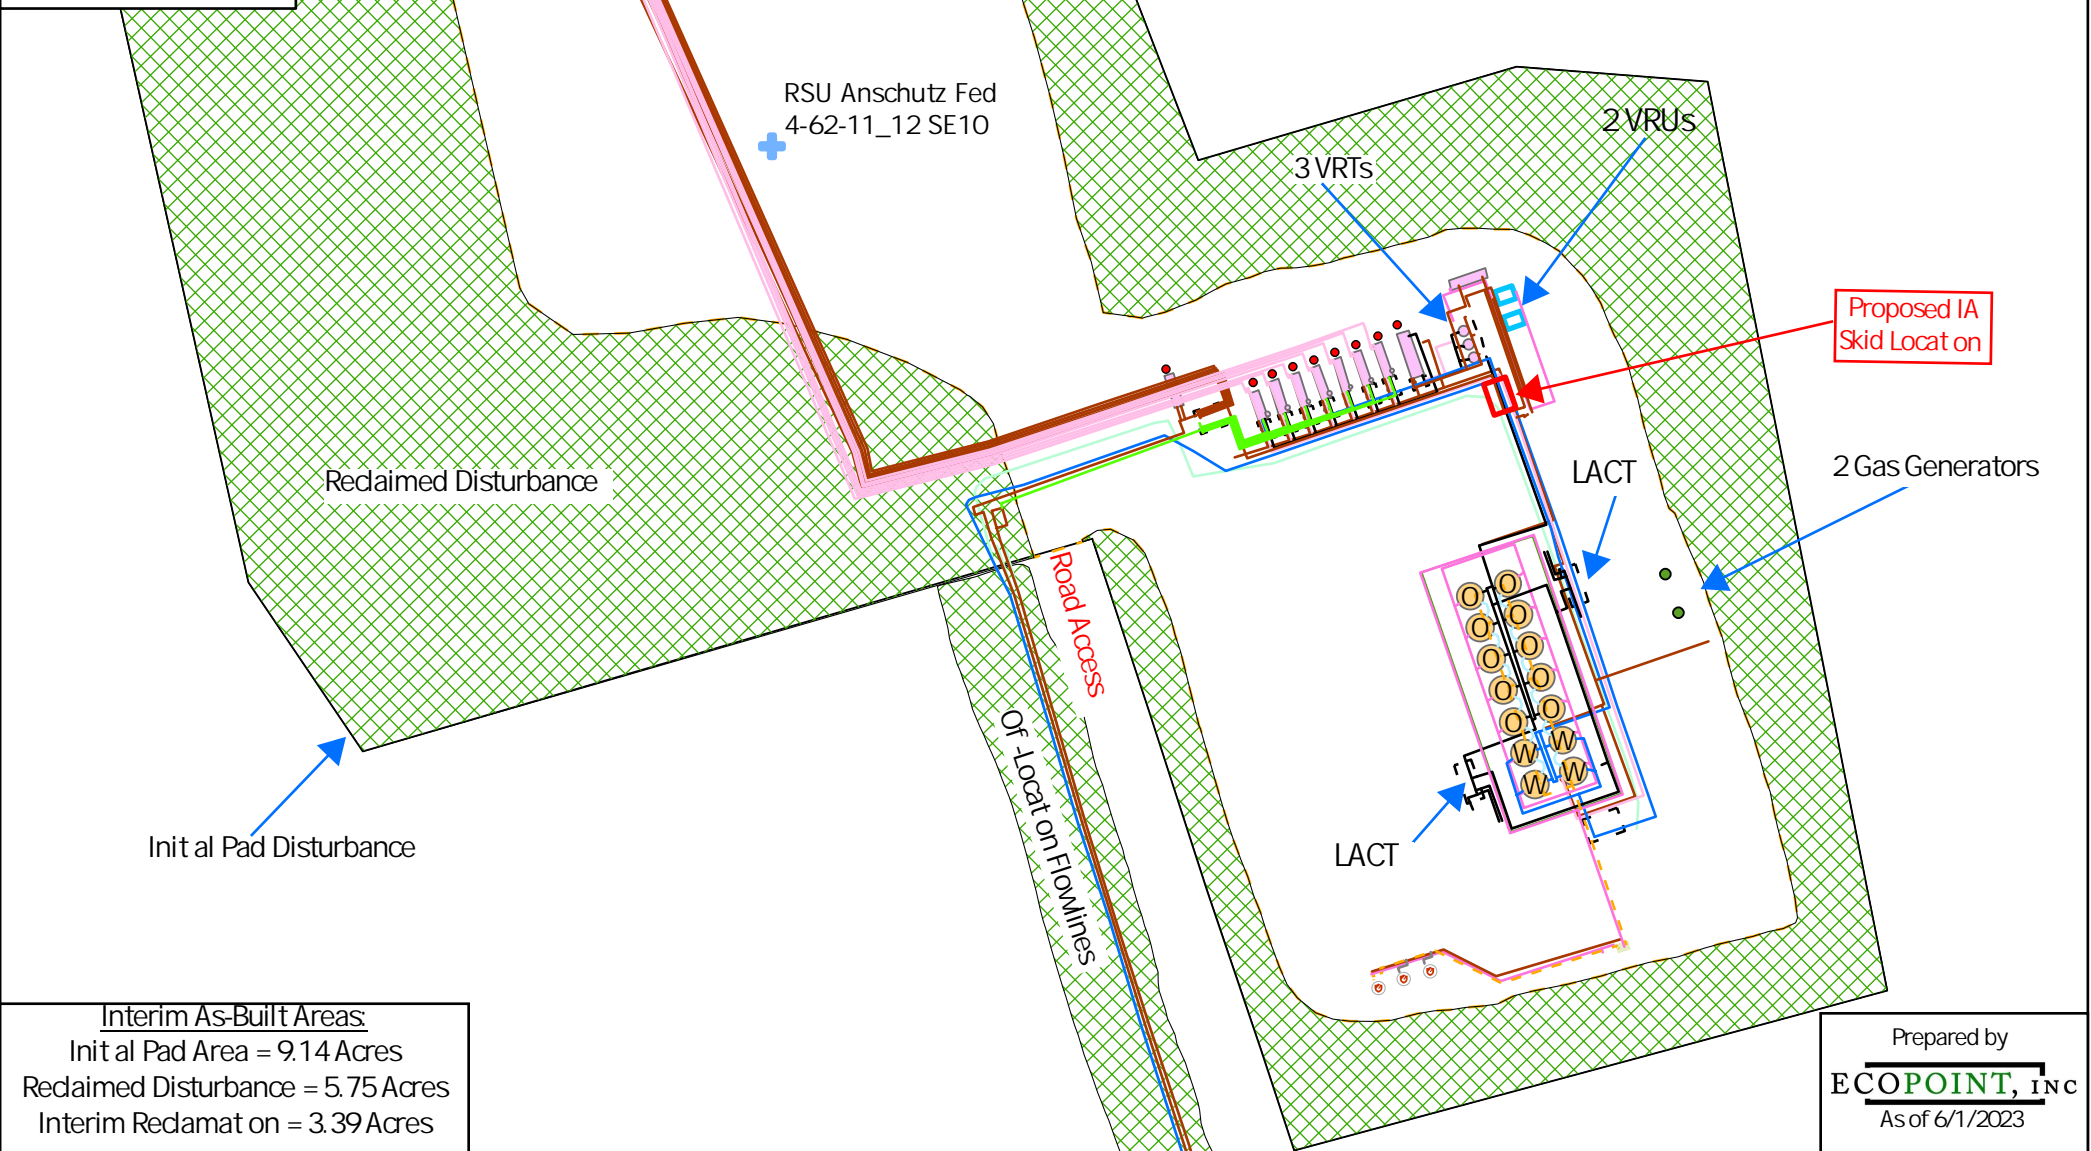

Interim As-Built Areas:  
 Initial Pad Area = 9.14 Acres  
 Reclaimed Disturbance = 5.75 Acres  
 Interim Reclamation = 3.39 Acres