


Legend

- Heaters
- Combustors
- Engine Points
- - - Electric Lines
- ▭ Skids
- ▭ Tanks
- ▭ Separators
- ▭ Building
- ▭ Reclaimed Area
- ▭ Interim Reclamation


CIVITAS RESOURCES
 AS-BUILT FACILITY DIAGRAM
 FACILITY: RSU Anschutz Fed 4-62-2 SE3
 COGCC FACILITY # 454977
 LOCATION: 104° 18'16"W 40° 20'7"N
 WELD COUNTY, COLORADO
 PAGE 1 OF 2

0 40 80 160 Feet

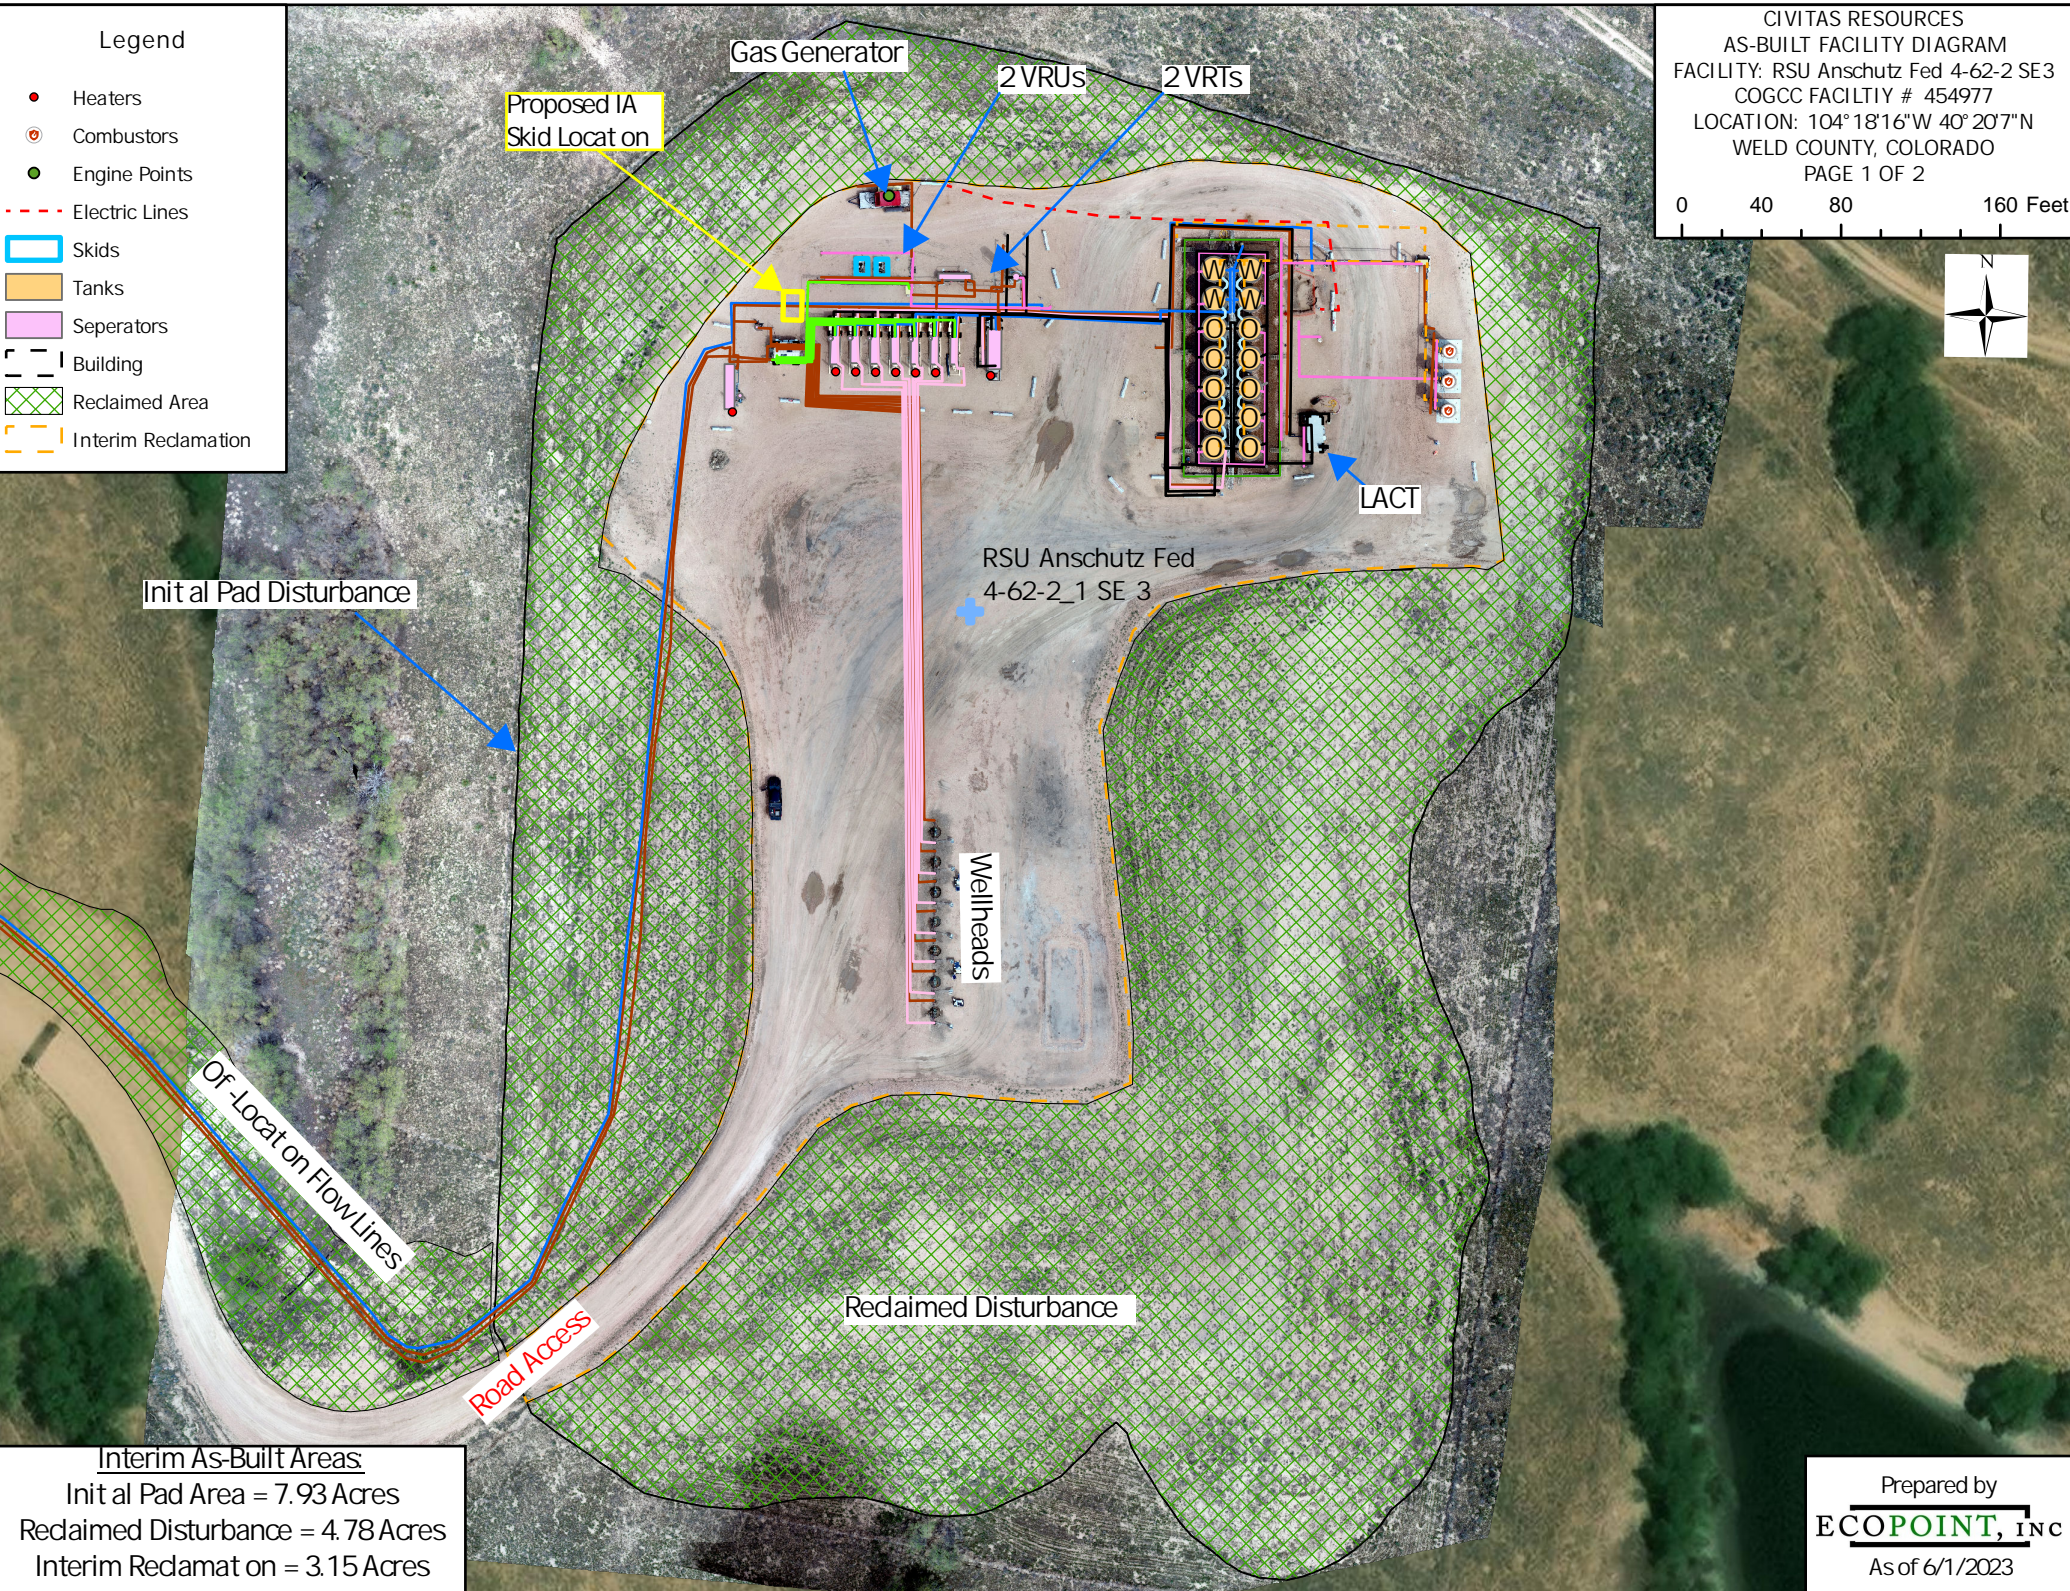

Interim As-Built Areas:
 Initial Pad Area = 7.93 Acres
 Reclaimed Disturbance = 4.78 Acres
 Interim Reclamation = 3.15 Acres

Prepared by
ECOPOINT, INC
 As of 6/1/2023

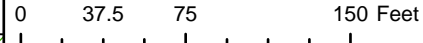

- Legend**
- Heaters
 - ⊙ Combustors
 - Engine Points
 - - - Electric Lines
 - Skids
 - Tanks
 - Separators
 - ▭ Building
 - ▨ Reclaimed Area
 - - - Interim Reclamation

Proposed IA Skid Location

Gas Generator

2 VRUs

2 VRTs

LACT

RSU Anschutz Fed
 4-62-2_1 SE 3

Wellheads

Initial Pad Disturbance

Of Location Flowlines

Road Access

Reclaimed Disturbance

Interim As-Built Areas:
 Initial Pad Area = 7.93 Acres
 Reclaimed Disturbance = 4.78 Acres
 Interim Reclamation = 3.15 Acres