

**NOTE:**  
 1. EXISTING UTILITIES DISPLAYED ON THE GRADING PLAN ARE FOR REFERENCE PURPOSES ONLY. PRIOR TO CONSTRUCTION OR EARTHWORK, CONTRACTOR WILL BE RESPONSIBLE TO CALL FOR LOCATES: (800) 922-1987

**PAD - GADDIS 3-36HZ INTERIM RECLAMATION AS-BUILT SUMMARY**


**INTERIM AS-BUILT AREAS**  
 PROPOSED OIL & GAS LOCATION = 10.73 ACRES  
 AREA RECLAIMED DURING INTERIM RECLAMATION = 8.06 ACRES  
 TOTAL WELL PAD AREA = 0.89 ACRES  
 TOTAL FACILITY PAD AREA = 1.24 ACRES  
 TOTAL TEMPORARY EQUIPMENT PAD AREA = 0.32 ACRES  
 TOTAL ACCESS ROAD AREA WITHIN PROPOSED OIL & GAS LOCATION = 0.22 ACRES

**INTERIM AS-BUILT VOLUMES**  
 APPROXIMATE TOPSOIL STORAGE FOR FINAL RECLAMATION = 1,570 C.Y.

**NOTE:**  
 • THIS EXHIBIT IS BASED UPON AS-BUILT SURVEYS CONDUCTED ON OR BEFORE OCTOBER 13TH, 2023.

**LEGEND**

- AS-BUILT WELL LOCATION
- EXISTING CONTOURS (1' INTERVAL)
- EPL EXISTING PIPELINE
- AS-BUILT FLOWLINE
- \* \* \* EXISTING FENCE
- RECLAMATION AREA
- EXISTING PAD
- EXISTING ROAD AREA
- EXISTING TEMPORARY EQUIPMENT PAD
- FUTURE RECLAMATION AREA
- EXISTING DITCH
- BERM

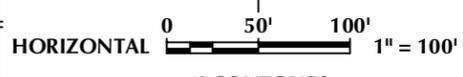

SCALE: 1"=100' DATE: 11/29/23 SHEET NO: 1 OF 1

**WELL PAD - GADDIS 3-36HZ**

PAD - AS-BUILT INTERIM RECLAMATION  
 GADDIS 36-1HZ, GADDIS 36-2HZ,  
 GADDIS 36-3HZ, GADDIS 36-4HZ,  
 GADDIS 36-5HZ & GADDIS 36-6HZ  
 LOCATED IN SECTION 36, T4N, R68W, 6TH P.M.  
 WELD COUNTY, COLORADO

**Kerr-McGee Oil & Gas Onshore LP**  
 1099 18th Street  
 Denver, Colorado 80202



**CONSULTING, LLC**

LOVELAND OFFICE  
 6706 North Franklin Avenue  
 Loveland, Colorado 80538  
 Phone 970-776-4331

SHERIDAN OFFICE  
 1095 Saberton Avenue  
 Sheridan, Wyoming 82801  
 Phone 307-674-0609