


THIS DRAWING AND THE DESIGN IT COVERS ARE CONFIDENTIAL AND REMAIN THE PROPERTY OF ANADARKO PETROLEUM CORPORATION AND SHALL NOT BE DISCLOSED TO OTHERS OR REPRODUCED IN ANY MANNER OR USED FOR ANY PURPOSE WHATSOEVER EXCEPT BY WRITTEN PERMISSION BY THE OWNER.

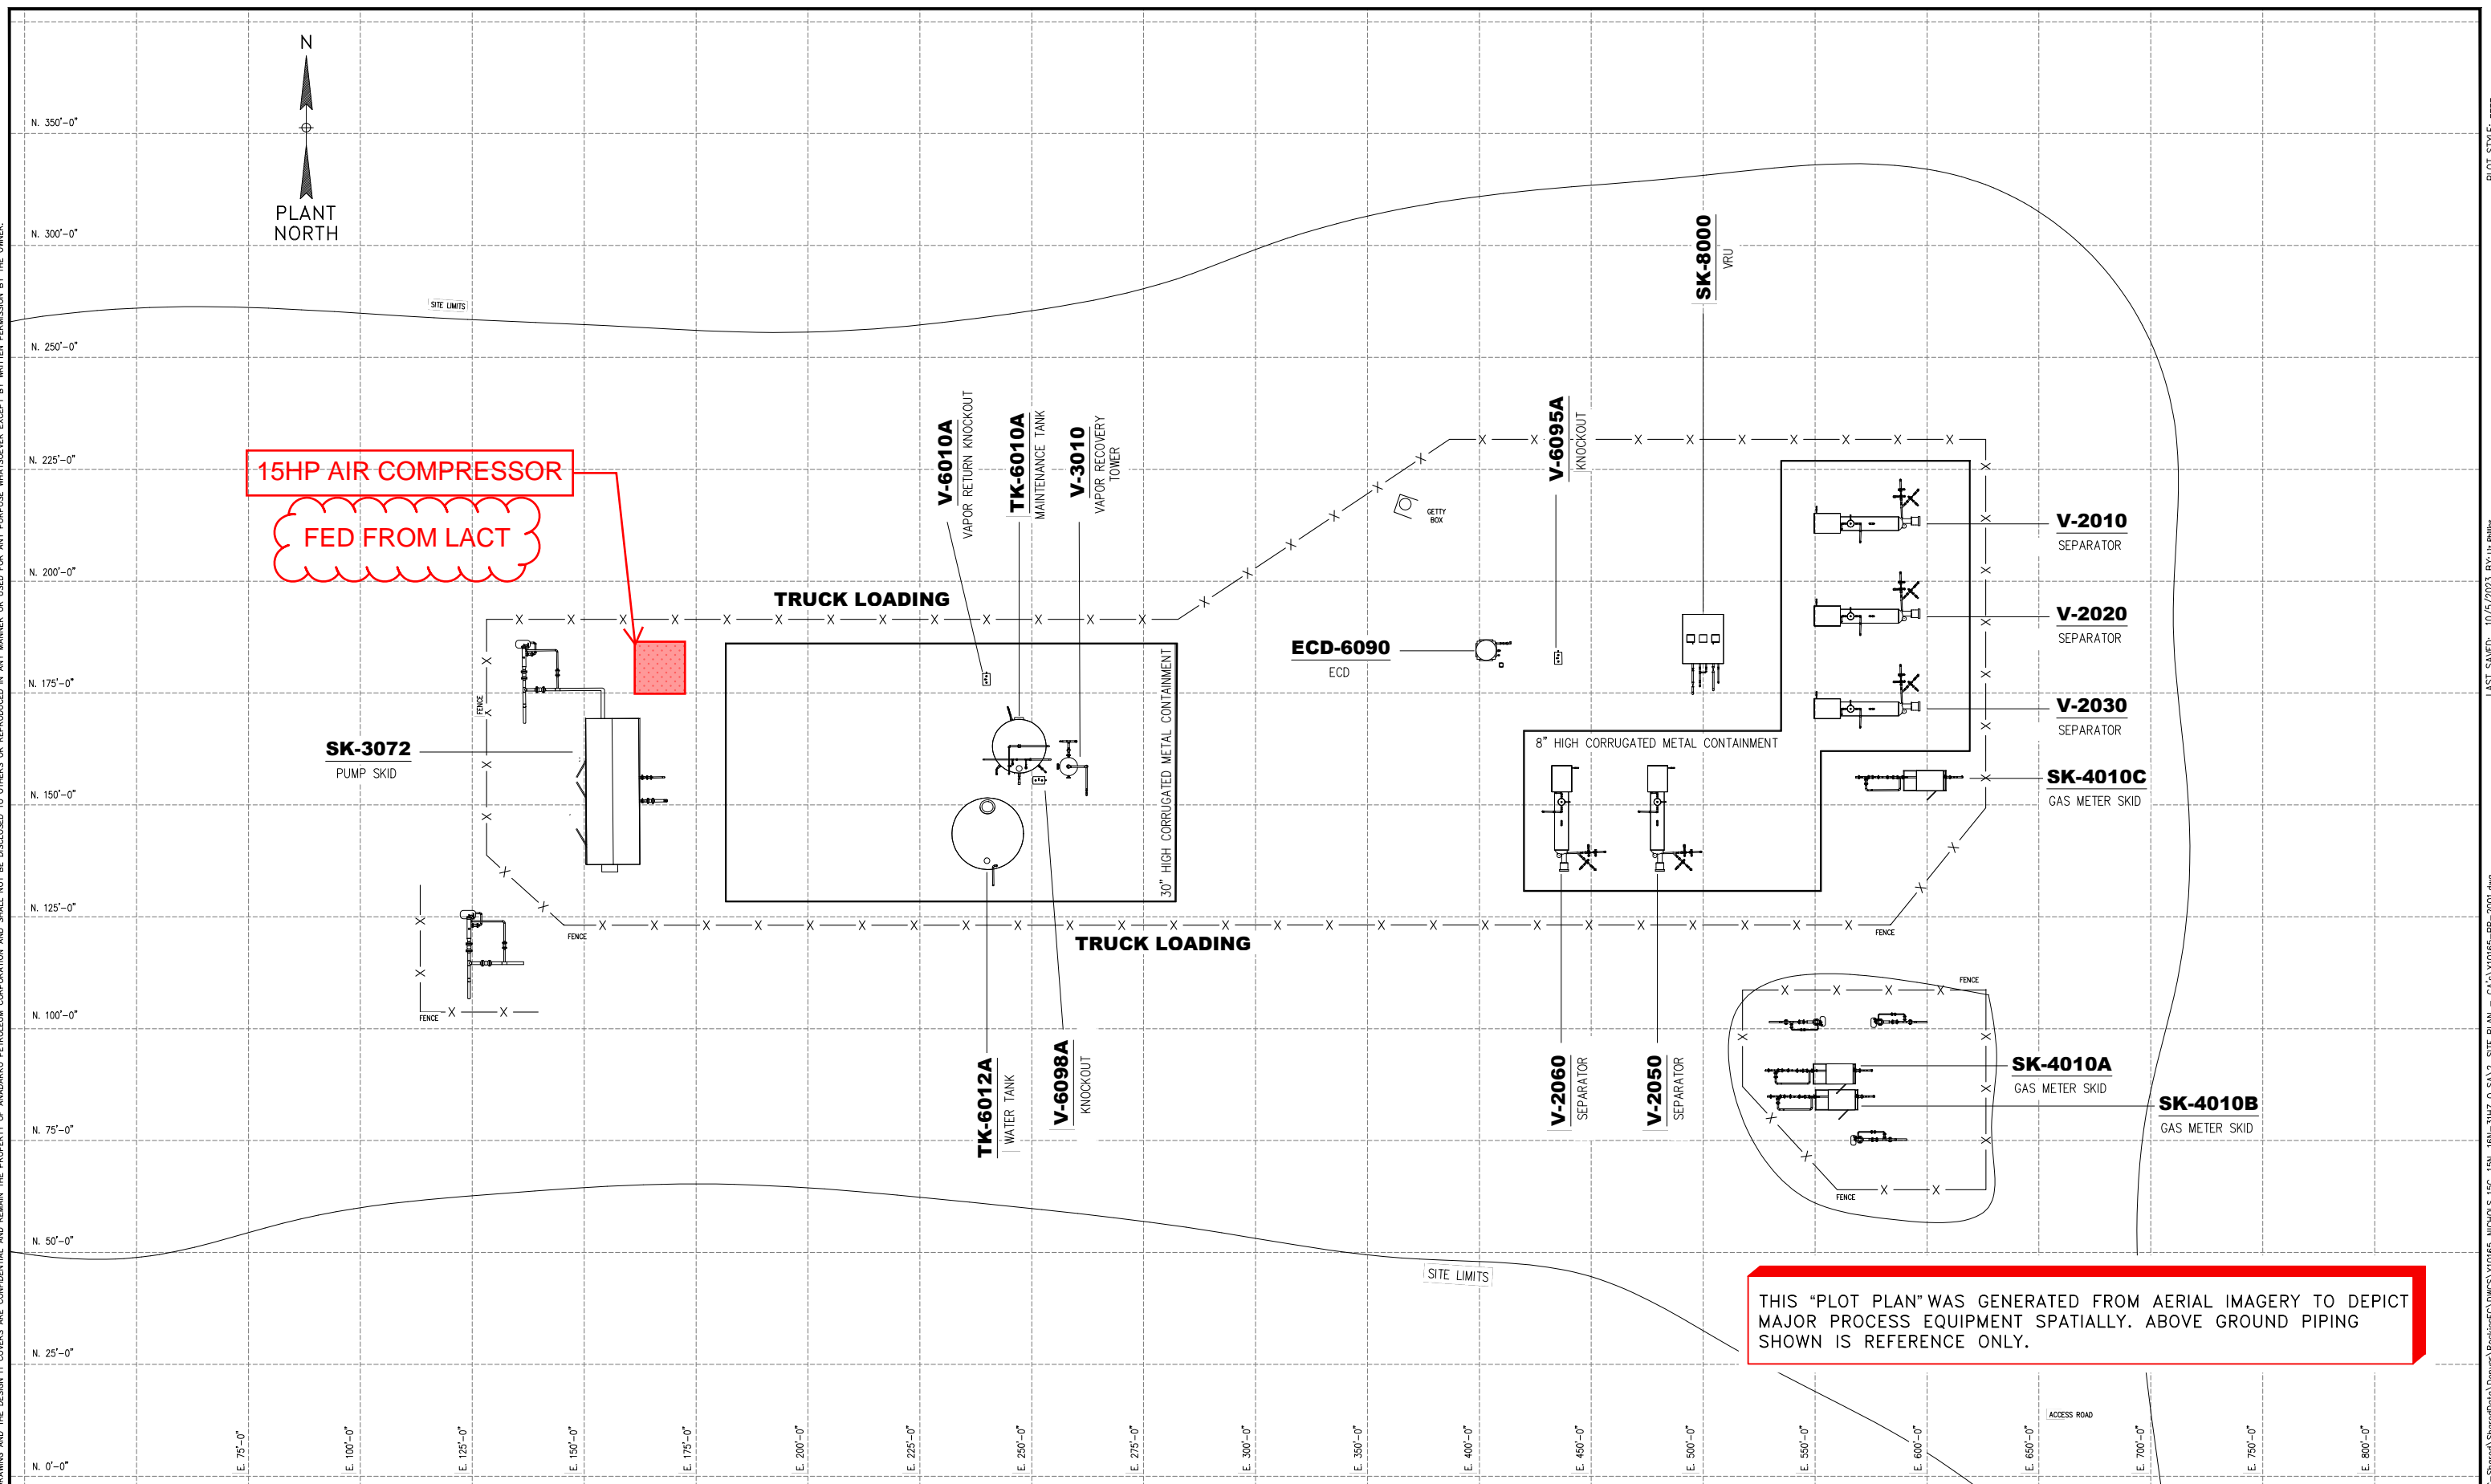

NOTES:

REFERENCE DRAWINGS		REVISIONS			
DWG. NO.	TITLE	NO.	DESCRIPTION	BY	DATE
		1	ISSUED AS-BUILT (MOC 9021)	DM	10/02/23
		2	ISSUED AS-BUILT (MOC 5878)	ML	05/05/23
		3	ISSUED AS-BUILT (MOC 26185)	BTJ	02/22/21
		4	ISSUED AS-BUILT (MOC 15411)	RGP	02/06/19
		5	ISSUED FOR INFORMATION	DRP	07/11/17

KERR-MCGEE OIL & GAS ONSHORE LP

NICHOLS 15C, 15N, 16N-31HZ O SA

GENERAL ARRANGEMENT PLOT PLAN		
DRAWN BY: D. PAYTON	CREATION DATE: 07/11/17	AFE No.:
APPROVED: M. PHILLIPS	APPR. DATE: 07/14/17	DWG. No.:
SCALE: 3/32" = 1'-0"	X10165-PP-2001	SHEET No. 1 OF 1