


Configuration
As Built Well Profile
API Number 05-001-07605
Lundgren #1
 SWNW Sec 2 Township 3S Range 62W
 Lat/Long: 39.820159 / -104.299227

Fritzler Resources Inc.

12 1/4 hole 140 ft

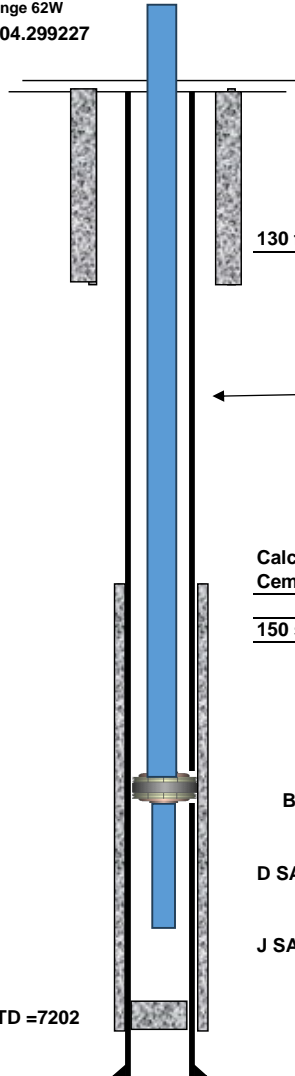

130 ft. 8 5/8 36# surface csg
 85 sx to surface

7 7/8 hole
 4.5 in J-55 10.5-11.6 wt set @ 7277ft.

Calculated
Cement Tops a 6530 ft -760
150 sx 50/50 PO3

2 3/8 J55 tubing
 Anchor - 6964
 4 jnts 2 3/8 j55
 Bottom Mud Anchor 7165

D SAND , (1spf) 7103-7105
 7108-7114
 J SAND (1spf) 7167-7173
 7186-7197

PBD =7202

PBD	<u>7202</u>	kb
Csg set at	<u>7277</u>	kb
TD	<u>7290</u>	kb

	<u>8</u>
KB Elevation	<u>5258 ft</u>
Ground Elevation	<u>5250 ft</u>
Surface Casing	<u>130 ft 8 5/8 36 #</u>
	<u>85 sx</u>
Production Casing	<u>4 1/2 10.5-11.6</u>
PBD	<u>7202</u>
TD	<u>7290</u>