

NOTE:
 1. EXISTING UTILITIES DISPLAYED ON THE GRADING PLAN ARE FOR REFERENCE PURPOSES ONLY.

SWARTZ 2-4HZ INTERIM RECLAMATION AS-BUILT SUMMARY


INTERIM AS-BUILT AREAS
 PROPOSED OIL & GAS LOCATION = 15.79 ACRES
 AREA RECLAIMED DURING INTERIM RECLAMATION = 11.81 ACRES
 TOTAL WELL PAD AREA = 1.60 ACRES
 TOTAL FACILITY PAD AREA = 2.10 ACRES
 TOTAL ACCESS ROAD AREA WITHIN PROPOSED OIL & GAS LOCATION = 0.28 ACRES

INTERIM AS-BUILT VOLUMES
 APPROXIMATE TOPSOIL STORAGE FOR FINAL RECLAMATION = 4,063 C.Y.

NOTE:
 • THIS EXHIBIT IS BASED UPON AS-BUILT SURVEYS CONDUCTED ON OR BEFORE AUGUST 18TH, 2025.

LEGEND

- AS-BUILT WELL LOCATION
- EXISTING CONTOURS (0.5' INTERVAL)
- EPL EXISTING PIPELINE
- AS-BUILT FLOWLINE
- × × × EXISTING FENCE
- RECLAMATION AREA
- EXISTING PAD
- EXISTING ROAD AREA
- DIVERSION DITCH
- BERM

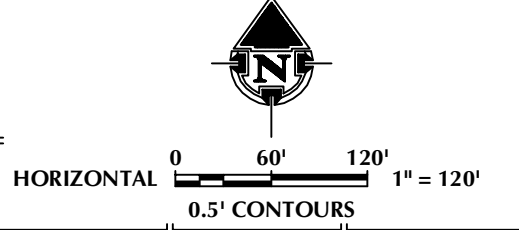

SWARTZ 2-4HZ

AS-BUILT INTERIM RECLAMATION
 SWARTZ 4-6HZ, SWARTZ 4-7HZ,
 SWARTZ 4-8HZ, SWARTZ 4-9HZ, SWARTZ 4-10HZ,
 SWARTZ 4-11HZ, SWARTZ 4-12HZ, SWARTZ 4-13HZ,
 SWARTZ 4-14HZ, SWARTZ 4-15HZ & SWARTZ 4-16HZ
 LOCATED IN SECTION 4, T3N, R67W, 6TH P.M.
 WELD COUNTY, COLORADO

Kerr-McGee Oil & Gas Onshore LP
 1099 18th Street
 Denver, Colorado 80202



LOVELAND OFFICE
 6706 North Franklin Avenue
 Loveland, Colorado 80538
 Phone 970-776-4331

SHERIDAN OFFICE
 1095 Saberton Avenue
 Sheridan, Wyoming 82801
 Phone 307-674-0609

SCALE: 1"=120' **DATE:** 9/22/25 **SHEET NO:** 1 OF 1

K:\AN\ARKO\2018\1818_193_SWARTZ_T3N_R67W_SEC_4\DWG\AS-BUILT\SWARTZ AS-BUILT FORM 45.dwg, 9/22/2025 2:41:47 PM, sruandbg