


THIS DRAWING AND THE DESIGN IT COVERS ARE CONFIDENTIAL AND REMAIN THE PROPERTY OF AMADARCO PETROLEUM CORPORATION AND SHALL NOT BE DISCLOSED TO OTHERS OR REPRODUCED IN ANY MANNER OR USED FOR ANY PURPOSE WHATSOEVER WITHOUT THE WRITTEN PERMISSION BY THE OWNER.

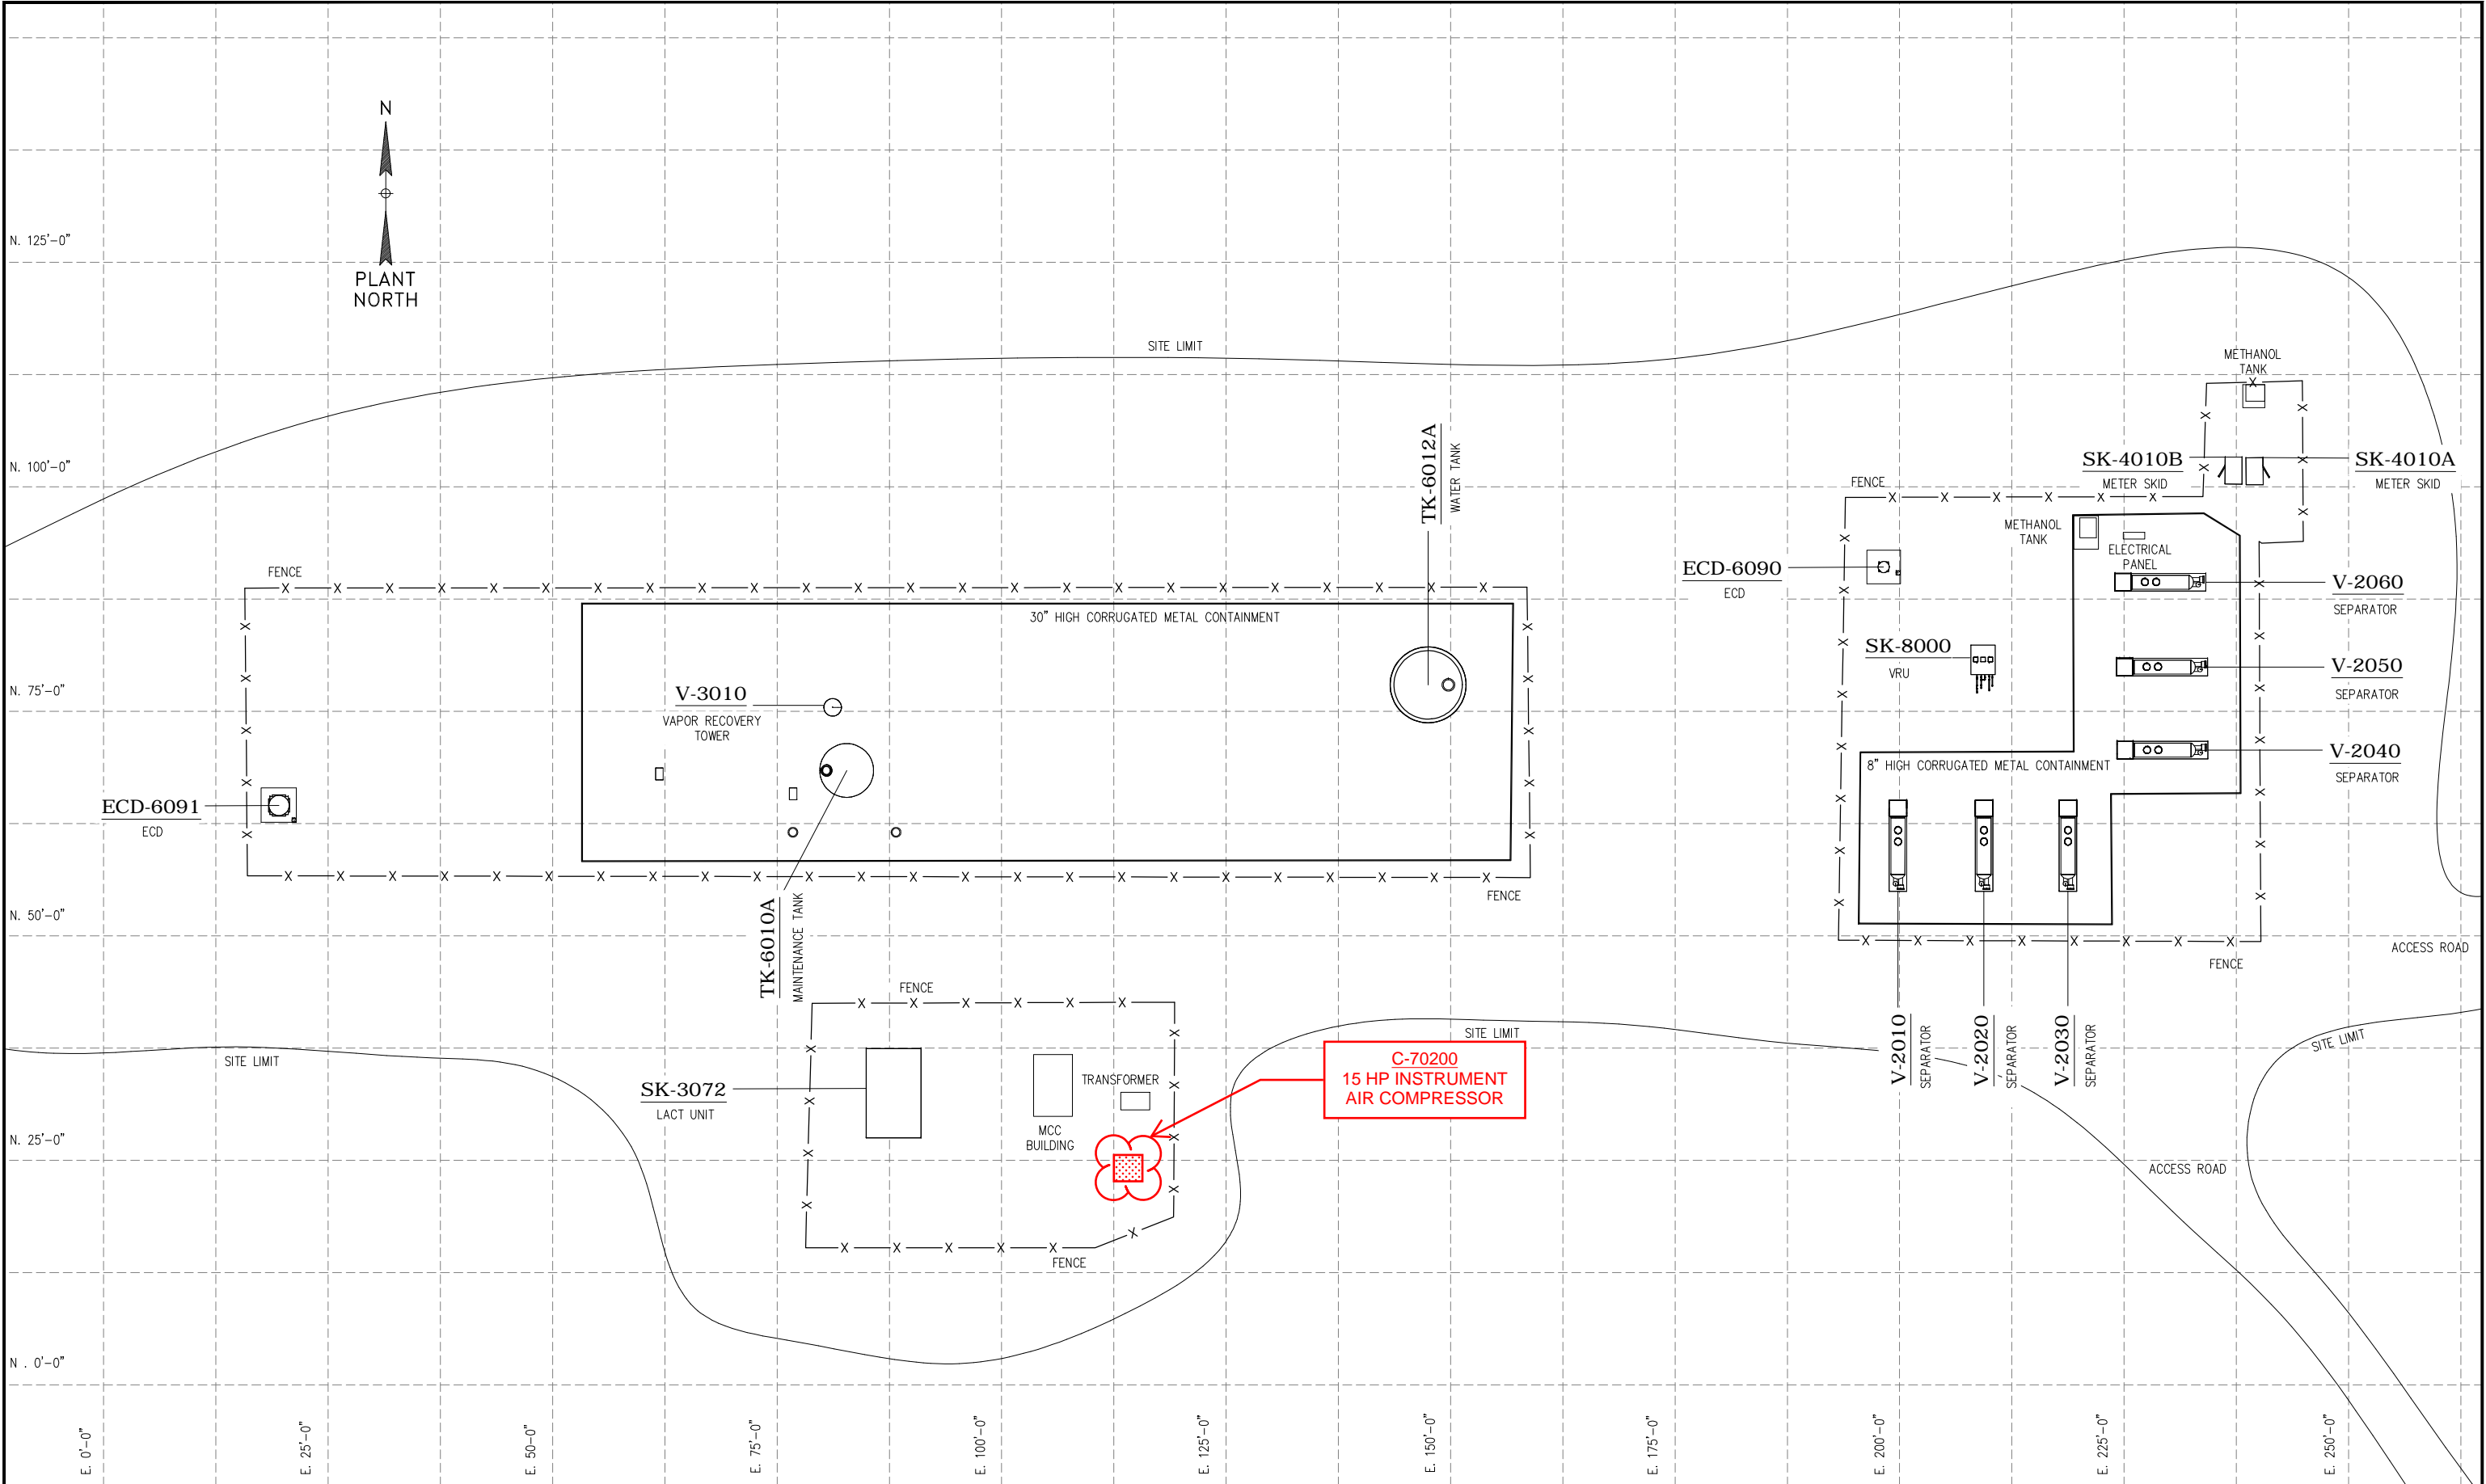

PLOT STYLE: -----
LAST SAVED: 5/28/2021 BY: Chase Anderson
FILE LOCATION: L:\ShareData\Denver\RockHes\C\DWGS\X12135_BARCLAY 29C, 29N, 4N, 3N-27 O SA\2. SITE PLAN - GA's\X12135-PP-2001.dwg

NOTES:

| REFERENCE DRAWINGS | | REVISIONS | | | |
|--------------------|-------|-----------|-----------------------------|------|----------|
| DWG. NO. | TITLE | NO. | DESCRIPTION | DATE | DATE |
| | | 1 | ISSUED AS-BUILT (MOC 26504) | MAM | 05/27/21 |
| | | 2 | ISSUED FOR PERMIT | MVP | 02/22/21 |
| | | 3 | ISSUED AS-BUILT (MOC 21850) | RGP | 08/28/19 |
| | | 4 | ISSUED FOR INFORMATION | JH | 03/14/18 |

KERR-MCGEE OIL & GAS ONSHORE LP

BARCLAY 29C, 29N, 4N, 3N-27 O SA

| GENERAL ARRANGEMENT | | |
|-----------------------|-------------------------|----------|
| DRAWN BY: J. HAM | CREATION DATE: 03/14/18 | AFE No.: |
| APPROVED: M. PHILLIPS | APPR. DATE: 08/28/19 | |
| | DWG. No.: | |
| | X12135-PP-2001 | |
| SCALE: 1/16" = 1'-0" | | |
| | SHEET No.: | |
| | 10F 1 | |