Hydrology Map - Baker 32-27 - Sec. 27, T1N, R68W

- Red Lines
- OIL AND GAS WELLS
  - Oil and Gas Wells
  - Temporary Point
- Buffer layer
- CITIES TOWNS PLACES
  - Towns and Places
- ROADS AND RRS
  - Major Highways
- WATER RESOURCES
  - Water Wells
- SAN JUAN BASIN
  - Fruitland PC
- TOPOS (1: 24K)
  - NE Colorado Topo

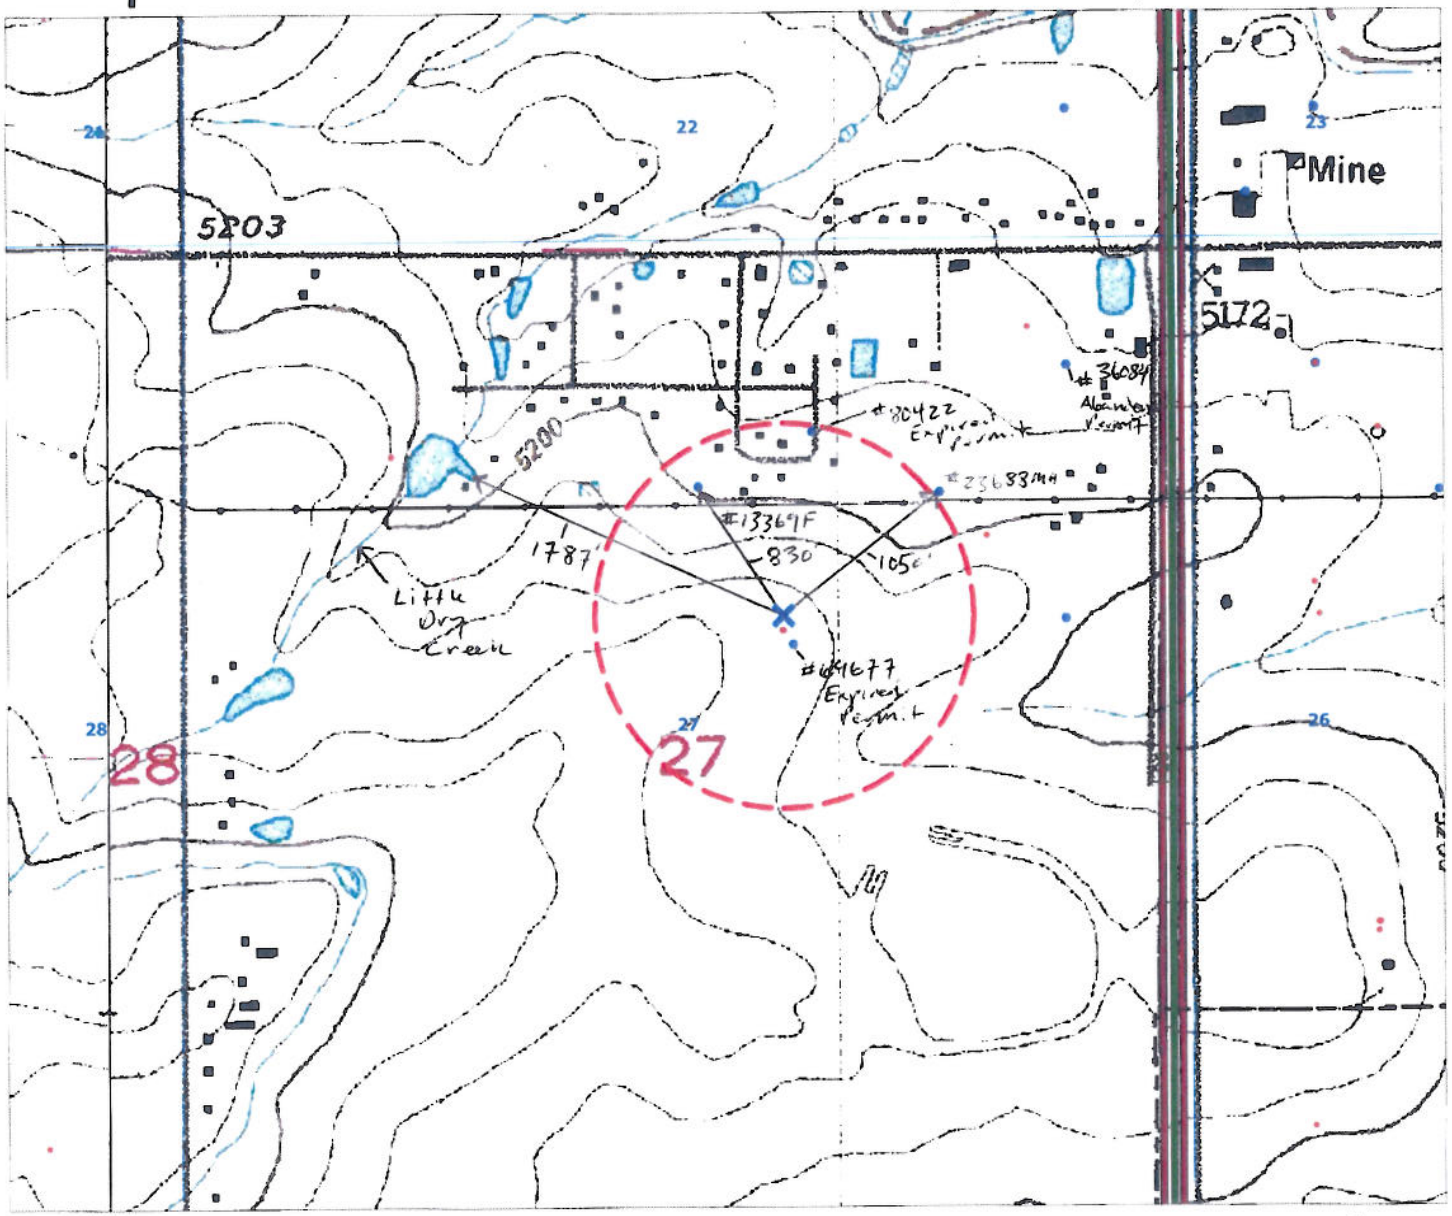

SCALE 1 : 11,555

1,000 0 1,000 2,000 3,000

FEET

N

http://cogcc.state.co.us/infosys/maps/cogccProduction.mwf

Wednesday, October 14, 2009 2:12 PM