


# Pine Ridge Oil & Gas LLC, Golden 22-20, SENW Sec 20 19S 69W, Location Drawing, 500' Buffer

- Red Lines
- OIL AND GAS WELLS
  - Oil and Gas Wells
  - Temporary Point
- Buffer layer
- CITIES TOWNS PLACES
  - Towns and Places
- ROADS AND RRS
  - Major Highways
- SAN JUAN BASIN
  - Fruitland PC
  - 2009\_AERIALS\_NAIP

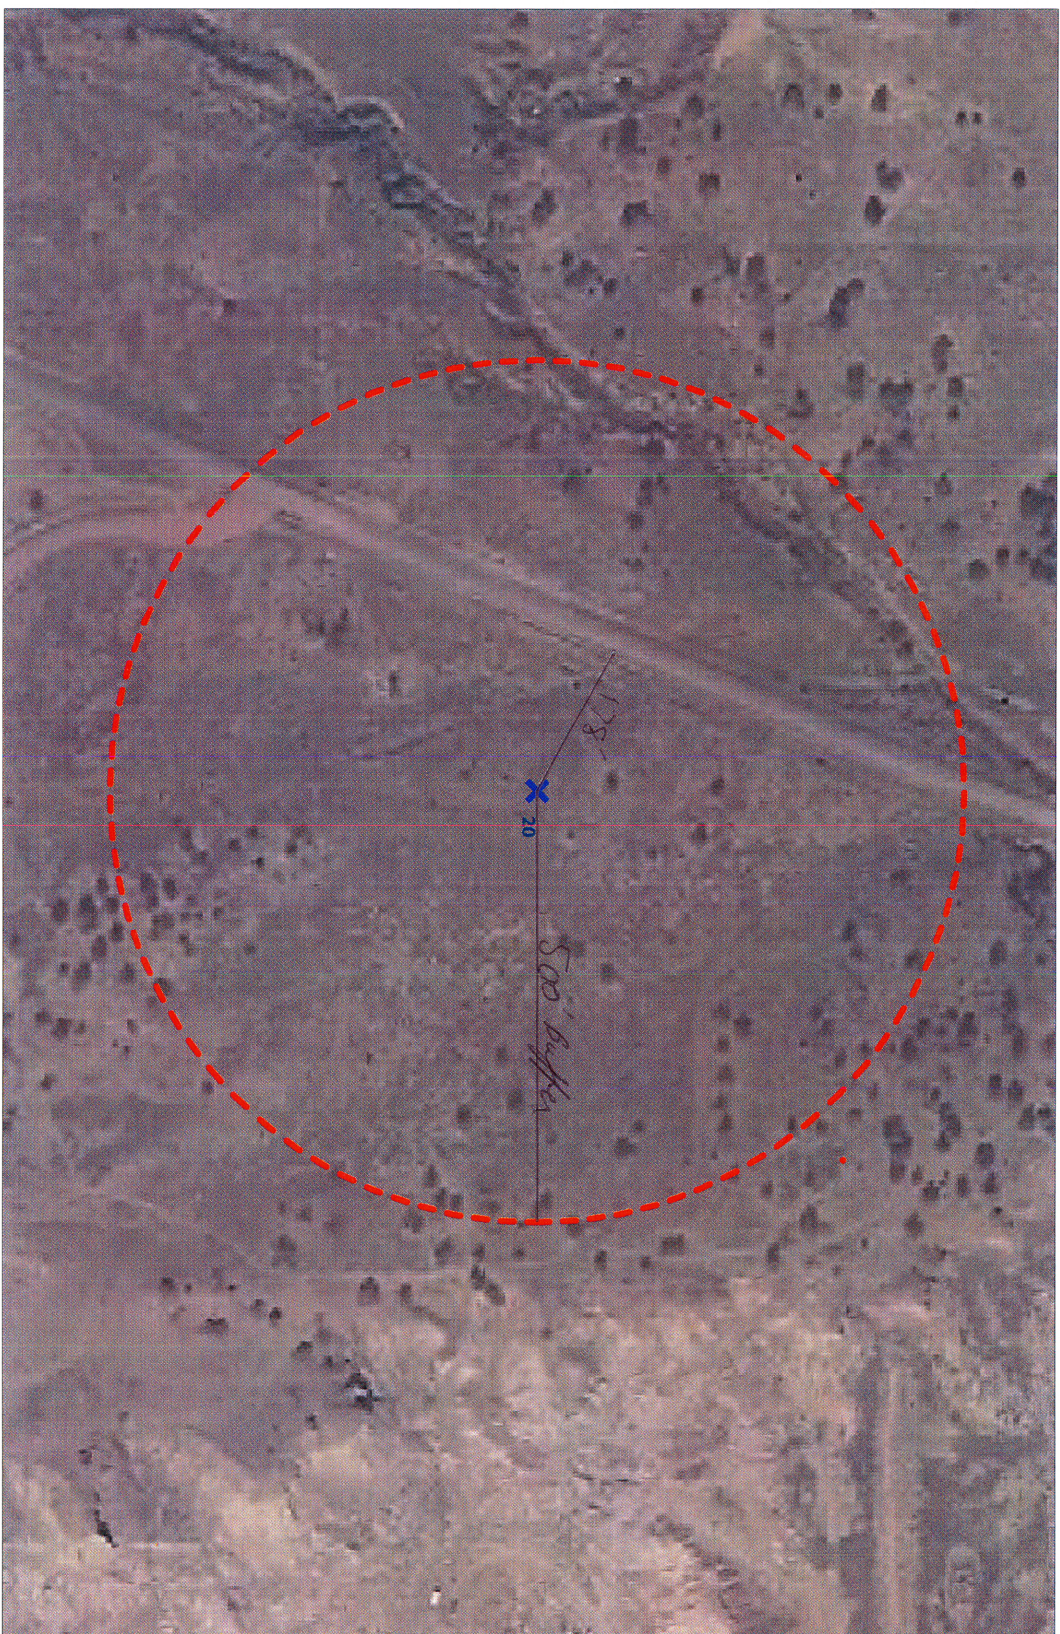

SCALE 1 : 2,683

