

UNITED STATES
DEPARTMENT OF THE INTERIOR
BUREAU OF LAND MANAGEMENT

LEASE FOR OIL AND GAS

(Sec. 17 Noncompetitive Public Domain Lease)

Act of February 25, 1920 (41 Stat. 437), as amended (30 U.S.C. Secs. 181-263)

• Cities Service Oil Company •
• Cities Service Building •
• Bartlesville, Oklahoma 74004 •

Name _____
Street _____
City _____
State _____
ZIP Code _____

C-9415

(Serial Number)

This oil and gas lease is issued for a period of ten (10) years to the above-named lessee pursuant and subject to the provisions of the Mineral Leasing Act and subject to all rules and regulations of the Secretary of the Interior now or hereafter in force, when not inconsistent with any express and specific provisions herein, which are made a part hereof.

Lands included in the lease:

*lots 8-28, incl
John M Clark
B & M
12/3/69*

T. 40 N., R. 17 W., N.M.P.M.
Sec. 6: Lots 8-28 incl., SE $\frac{1}{4}$ (All)
Sec. 7: Lots 5-10 incl., NE $\frac{1}{4}$

Dolores County, Colorado

T. 41 N., R. 18 W., N.M.P.M.
Sec. 35: E $\frac{1}{2}$, S $\frac{1}{2}$ NE $\frac{1}{4}$, E $\frac{1}{2}$ SW $\frac{1}{4}$

In Dolores Unit Area, but not committed.

NEAR LISTED BY USGS

Containing a total of 1734.42 acres

Annual Rental \$ 867.50

This lease is issued to the successful drawee pursuant to his "Simultaneous Oil and Gas Entry Card" application filed under 43 CFR 3123.9, and is subject to the provisions of that application and those specified on the reverse side hereof.

Effective date of lease. December 1, 1969

THIS LEASE IS SUBJECT TO THE REGULATION BY THE
GEOLOGICAL SURVEY OF THE UNITED STATES HEREIN
DESCRIBED UNDER THE NAME OF THE SURFACE OF

THE UNITED STATES OF AMERICA

No 162-6931

NONCOMPETITIVE OFFER TO
LEASE FOR OIL AND GAS

SEE INSTRUCTIONS
ON REVERSE

3 Parcel Number 178
4 State Colorado

C- 9415

The undersigned hereby offers to lease for oil and gas all or any portion of the above-identified parcel of land which may be available for noncompetitive leasing, and certifies that the (1) applicant is a citizen of the United States, an association of such citizens, a partnership, a corporation organized under the laws of the United States or any State thereof, or a municipality organized under the laws of such a State, (2) applicant's interests in oil and gas offers to lease, leases, and options do not exceed the limitation provided by the Mineral Leasing Act of February 25, 1920, as amended, and (3) applicant is the sole party in interest in this offer and the lease if issued, or if not the sole party in interest, that the names and addresses of all other interested parties are set forth on the reverse hereof. The undersigned agrees that the successful drawing of this card will bind him to a lease, on Form 3120-19 (4-11-58) or 3200-3 (4-11-56), and to the extent applicable, the stipulations provided for in 43 CFR 3103.2 for the described parcel or any portion thereof if such a lease is issued by the Bureau of Land Management as a result of this drawing.

CITIES SERVICE OIL COMPANY

1. BY John M. Clark August 22, 1969
Attorney- (Signature of Applicant) in-fact (Date)

2. CITIES SERVICE BUILDING, BARTLESVILLE, OKLAHOMA 74004

(Address, include zip code)

DO NOT DETACH

John M. Clark
Name of Signing Officer
FOR INDICATOR

(Title)

LESSEE

1-07X6-0517460

File 0517460

1-07-03-17460

11-14-69

SUPPLEMENTAL STIPULATION TO STIPULATION FOR LANDS UNDER JURISDICTION OF DEPARTMENT OF AGRICULTURE

To be attached to and made a part of Form 3103-2

- (a) At least two weeks before beginning of any clearing, construction, or operations including access and work road location and construction, the lessee shall prepare a "Lessee Surface Management Operating Plan" with the District Ranger,
CORTEZ, CO

The final plan shall be prepared in triplicate, including maps, for the approval by the Forest Supervisor. Such approval will be conditioned on reasonable requirements needed to prevent soil erosion, water pollution, and unnecessary damages to the surface vegetation and other resources of the United States and to provide for the restoration of the land surface and vegetation. The plan shall contain all such provisions as the Forest Service may deem necessary to maintain proper management of the lands and resources within the operating area.

Where appropriate, depending upon the location and type of operation, the Forest Supervisor may require the plan to contain, at a minimum, the following items:

1. The location, construction, modification, maintenance program and estimated use by the lessee, his employees and agents, of all access and work roads.
2. The exact location and extent of any and all areas to be occupied during the operations.
3. The methods to be used in the operations, including disposal of waste material.
4. The size and type of equipment to be used in the operation.
5. The capacity, size, character, standards of construction and location of all structures and facilities to be constructed.
6. Typical profiles of cuts and fills of all areas to be graded for the installation of structures and facilities.
7. The location and size of areas upon which vegetation will be destroyed and/or soil laid bare and the steps which will be taken to prevent and control soil erosion thereon, including but not limited to the proposed program for rehabilitation and revegetation of these disturbed lands both during and upon cessation of operations.
8. The steps which will be taken to prevent water pollution.
9. The character, amount and time of use of explosives or fire, including safety precautions which will be taken during their use.
10. Forest user, permitted livestock, and wildlife protection.

If later operations require departure from or additions to the approved plan, these revisions or amendments, together with justification statement for proposed revisions, will be submitted to the District Ranger for approval of the Forest Supervisor.

Any and all operations conducted in advance of approval of an original, revised, or amended operating plan, or which are not in accord with an approved plan, constitute a violation of the terms of this lease and the Forest Service reserves the right to close down the operation until such corrective action, as is deemed necessary, is taken by the lessee.

- (b) (1) To guarantee the successful rehabilitation and revegetation of abandoned operating areas, as provided for in the "Lessee Surface Management Operating Plan," paragraph (a) above, the Forest Service is agreeable to the reduction of lease or operator bonds to an amount necessary to cover the estimated cost of rehabilitation and revegetation, providing, that the lessee has otherwise satisfied the conditions of this lease and the United States Geological Survey and the Bureau of Land Management have approved such a reduction.
- (2) In lieu of bond, the lessee may upon mutual agreement with the Forest Supervisor deposit cooperative funds sufficient to cover the cost of rehabilitating and revegetating abandoned operating areas. When such funds have been deposited, the Forest Supervisor shall notify the United States Geological Survey that the requirements of the Forest Service have been satisfied, providing that all other conditions of the lease which concern the Forest Service have been satisfied.
- (c) No occupancy of the surface of the following areas is authorized by this lease. The lessee is, however, authorized to employ directional drilling to develop the mineral resources under these areas provided that such drilling or other works will not disturb the surface area or otherwise interfere with their use by the Forest Service. It is understood and agreed that the use of these areas for National Forest purposes is superior to any other use. Areas to be excluded from direct drilling occupancy are:
- (1) Within 500 feet on either side of the centerline of any and all roads and/or highways within the lease areas.
 - (2) Within 200 feet on either side of the centerline of any and all trails within the lease area.
 - (3) Within 500 feet of the normal highwater line of any and all lakes, ponds, and reservoirs located within the lease area.
 - (4) Within 500 feet of the normal highwater line of any and all streams in the area.
- The distances in subparagraphs 1, 2, 3, and 4 immediately above may be reduced when specifically agreed to in the operating plan, see paragraph (a).
- (5) Within 400 feet of any and all springs within the lease area.
 - (6) Within 400 feet of any improvements either owned, permitted, leased or otherwise authorized by the Forest Service.
 - (7)

LANDS COVERED BY THIS STIPULATION ARE AS FOLLOWS:


T. 40 N., R. 17 E., N.M.P.M.
SEC 6: LOTS 8-28 INCL., SE 1/4 (ALL)
SEC 7: LOTS 3-10 INCL., NE 1/4

CITIES SERVICE OIL COMPANY

By Susan W. Fink
Lessee

Attorney-in-Fact

*Lot 8-28, sec 6
Sola m clear k
6 x 7 12/3/61*

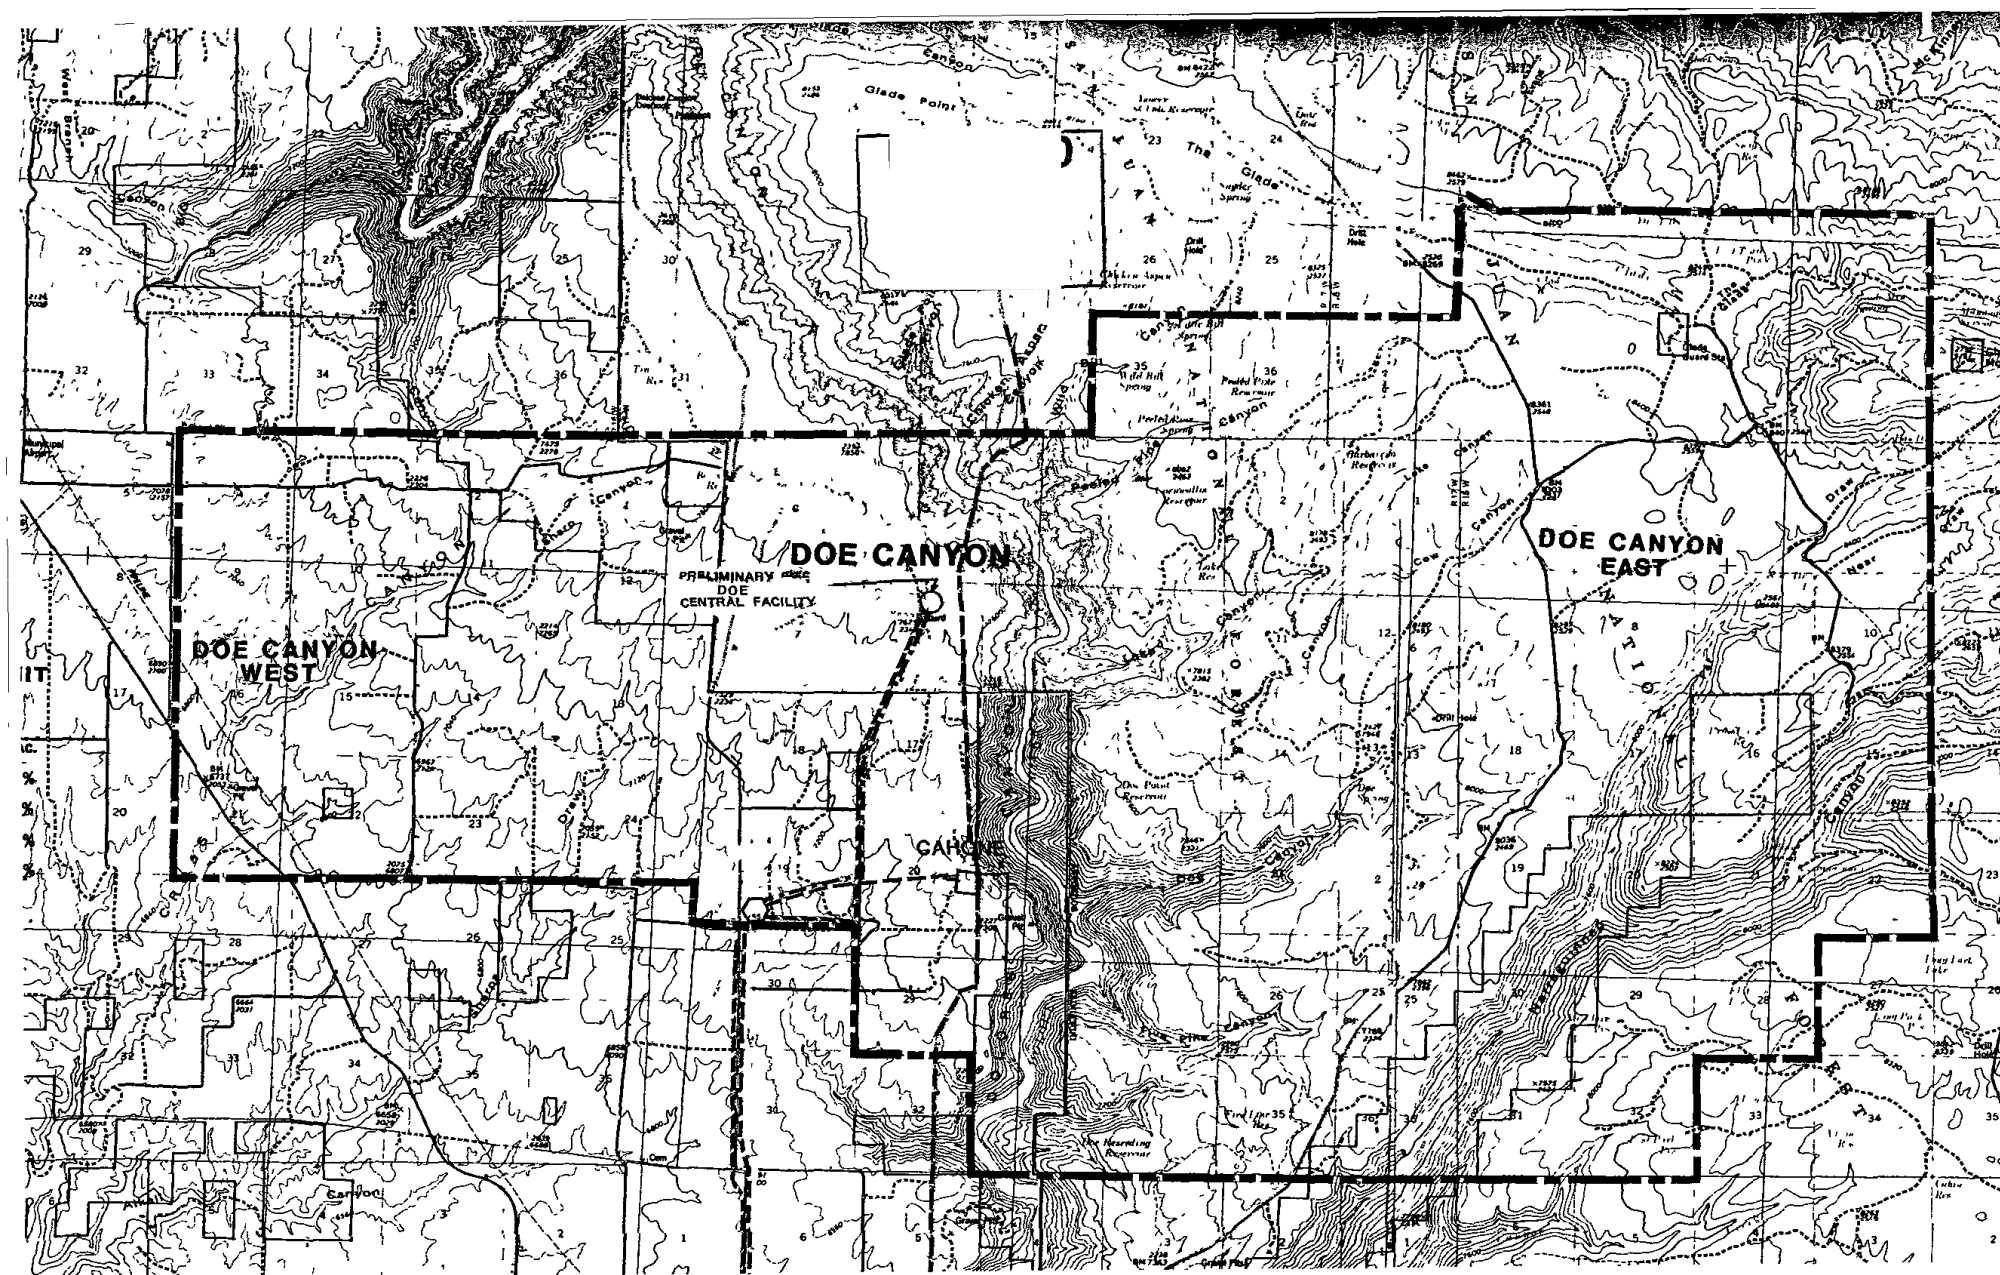

Free Leases
East 1/2
12-40N-18W

COO-15396
13-40N-18W


Free Lease
S/2 13-40N-18W
+ E/2 13/40N/18W

COGCC GIS Online


Per J.A
all in Sec 1, 12, 13, 24 in
Free Lease
COO 15396
in PA

DCE (Anixen)


- Red Lines
- OIL AND GAS WELLS**
 - Oil and Gas Wells
- CITIES TOWNS PLACES**
 - Cities
 - Towns and Places
- ROADS AND RRS**
 - Major Highways
- BLM LEASE STIPS**
 - Lease Notice
- BLM O&G/LAND INFO**
 - Participating Areas
 - Exploratory Units
- SAN JUAN BASIN**
 - Fruitland PC
 - MUNICIPAL BOUNDARIES

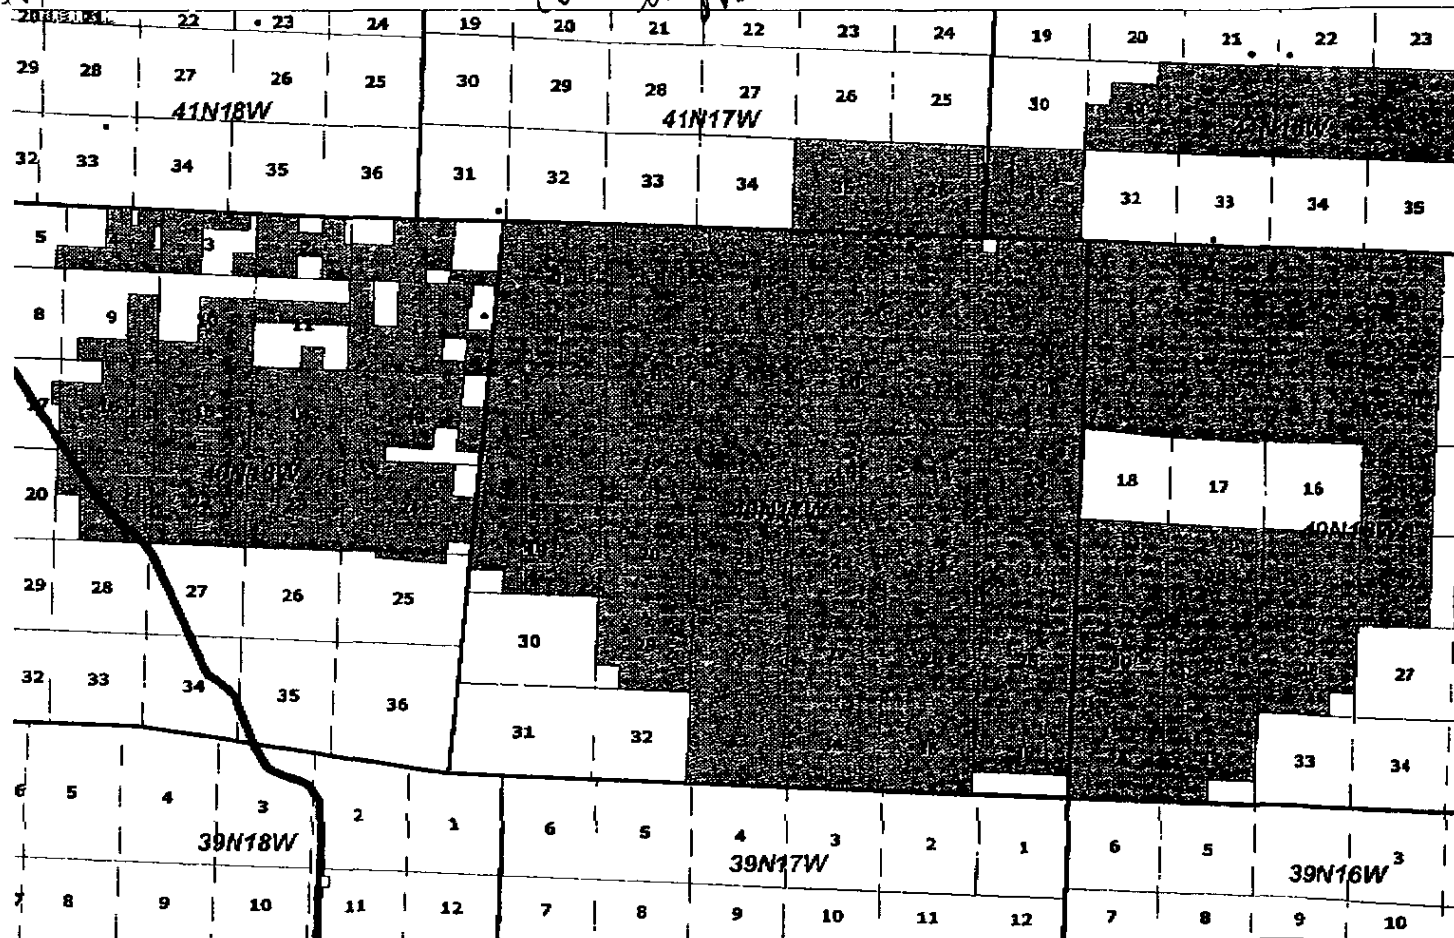

SCALE 1 : 130,572

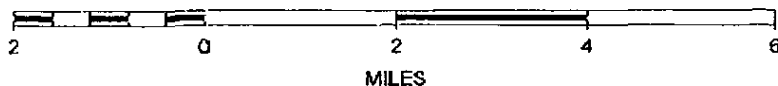

COGCC GIS Online

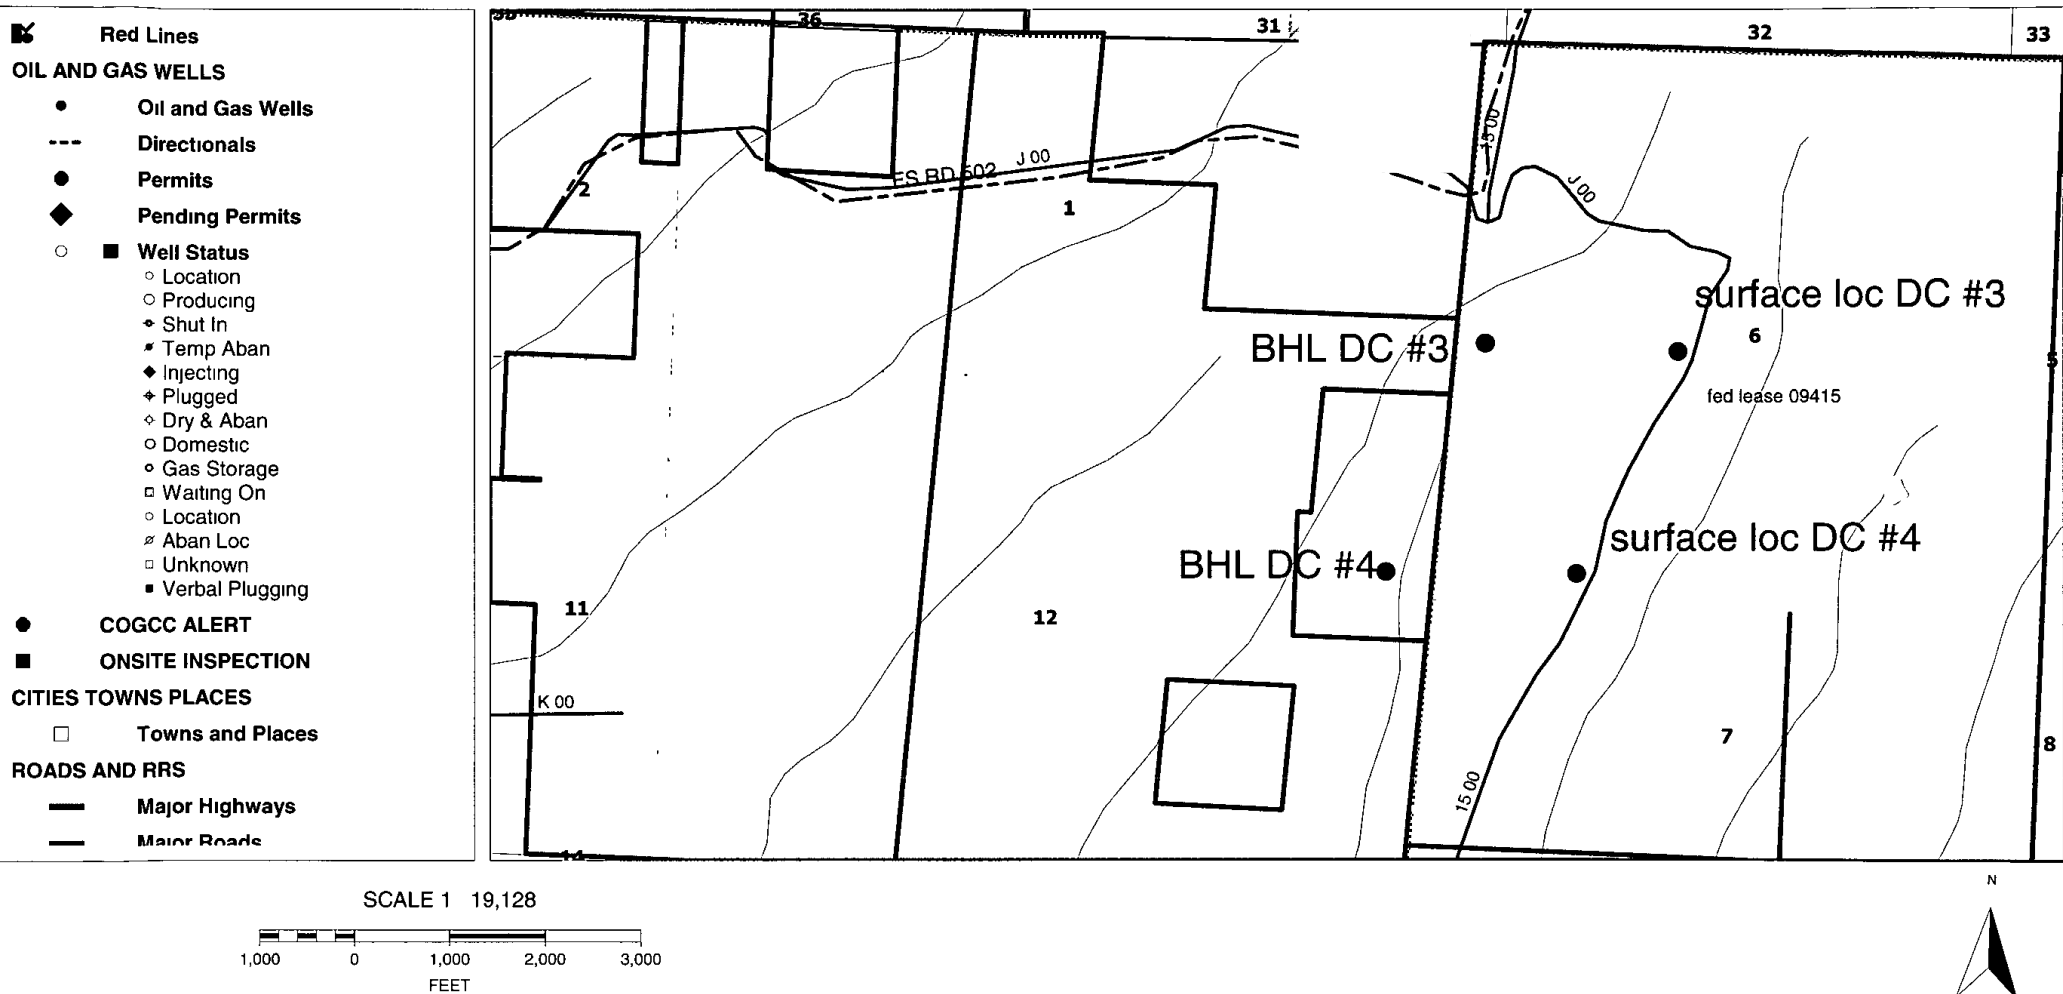

COGCC GIS Online

