SWEPI LP

AS-BUILT SITE PLAN FOR

NORTH CASTOR GULCH #2-16, #3-16,
#4-16, #5-16, #6-16, #7-16, #8-16 & #9-16
SECTION 16, T5N, R91W, 6th P.M.
TRACT 66

FIGURE #1

SCALE: 1" = 60'
DATE: 06-29-12
DRAWN BY: J.M.H.
REV: 09-28-12 Z.L.

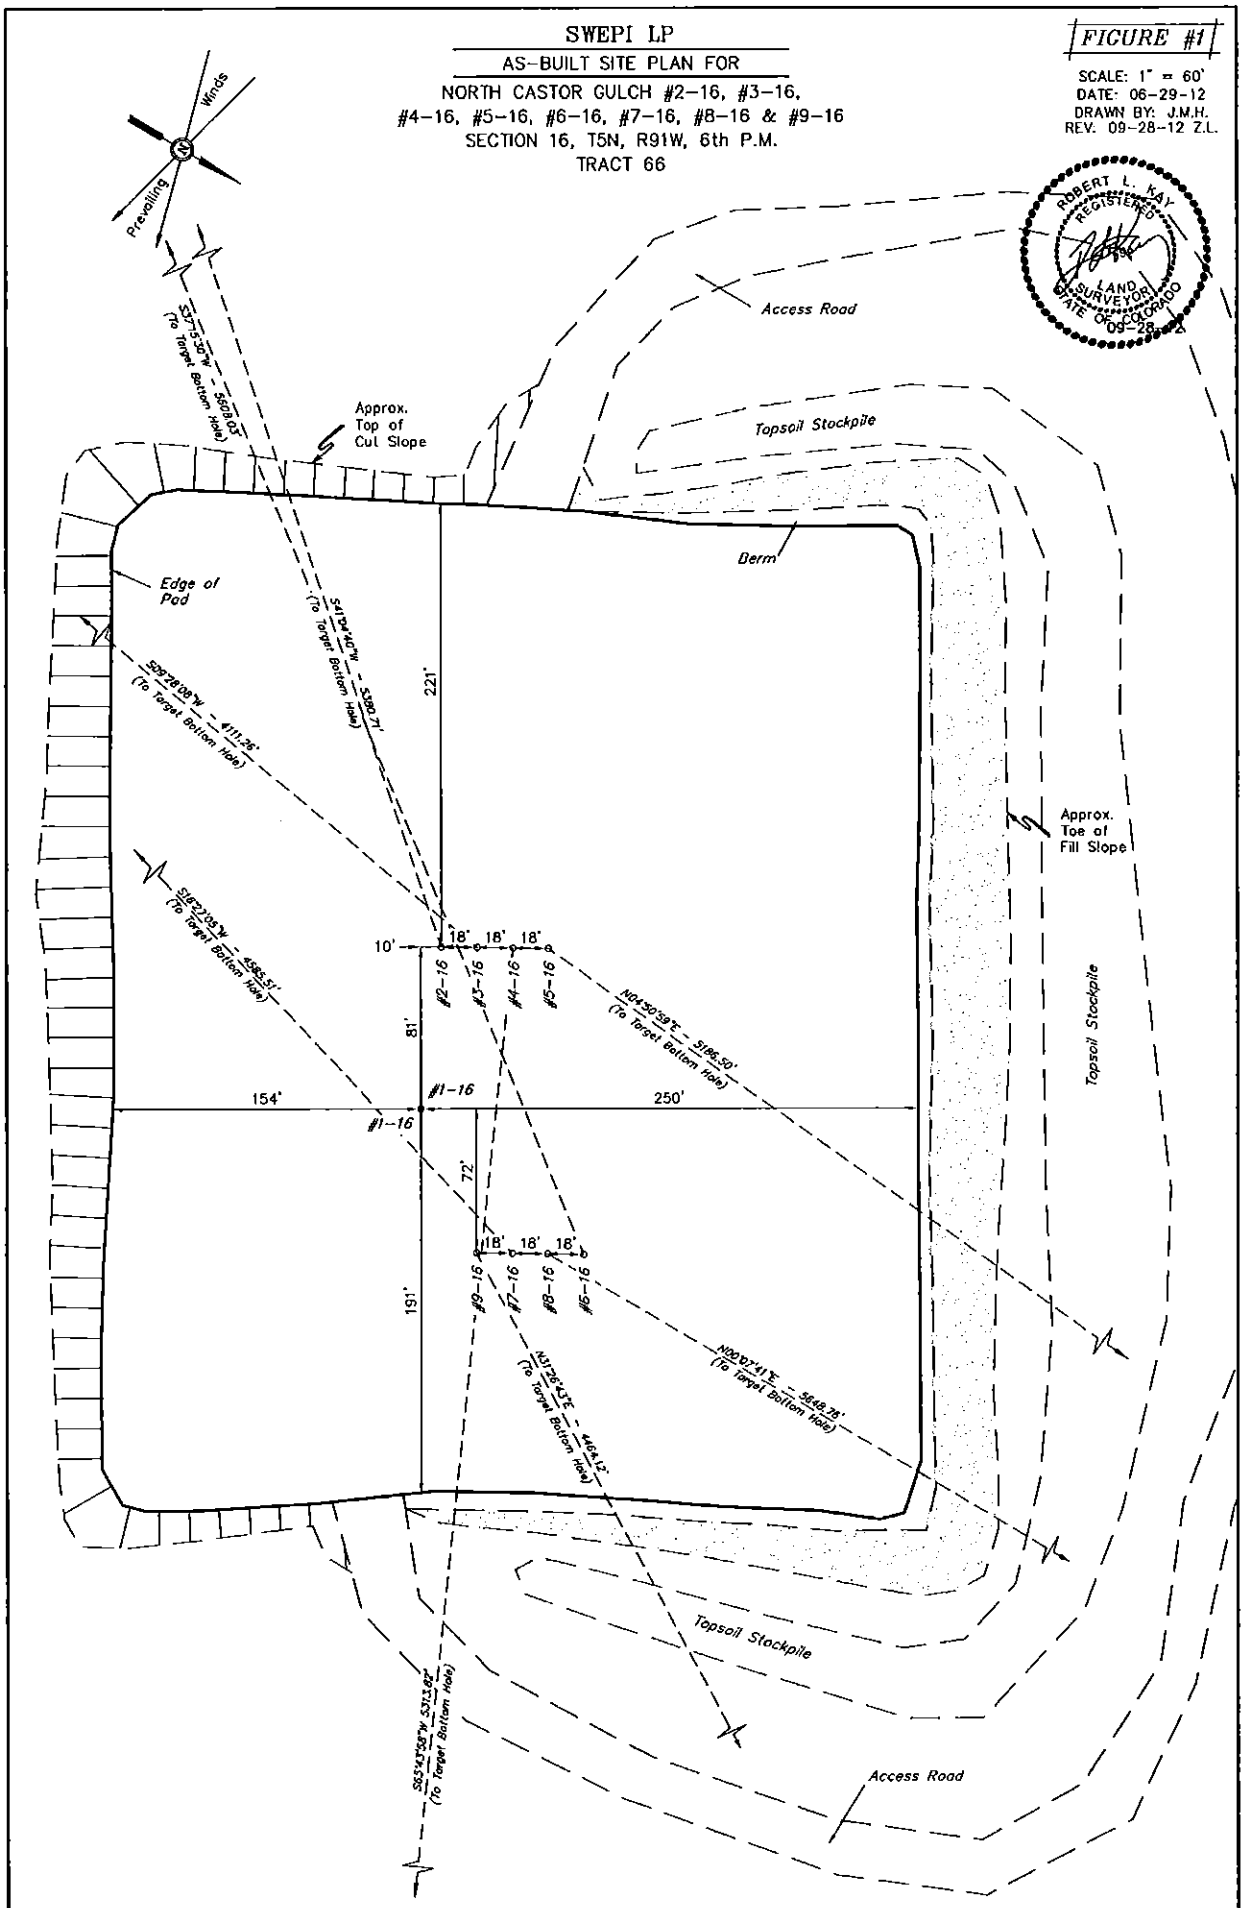

FINISHED GRADE ELEV. AT LOC. STAKE = 6986.8'

UINTAH ENGINEERING & LAND SURVEYING
85 So. 200 East • Vernal, Utah 84078 • (435) 789-1017