WEXPRO COMPANY

AS-BUILT SITE PLAN FOR

STATE OF COLORADO #2

SECTION 16, T11N, R97W, 6th P.M.

SE 1/4 NW 1/4

FIGURE #1

SCALE: 1" = 50'
DATE: 07-12-12
DRAWN BY: J.M.H.
REV: 10-09-12

ROBERT L. KAY REGISTERED LAND SURVEYOR STATE OF COLORADO 10-09-12

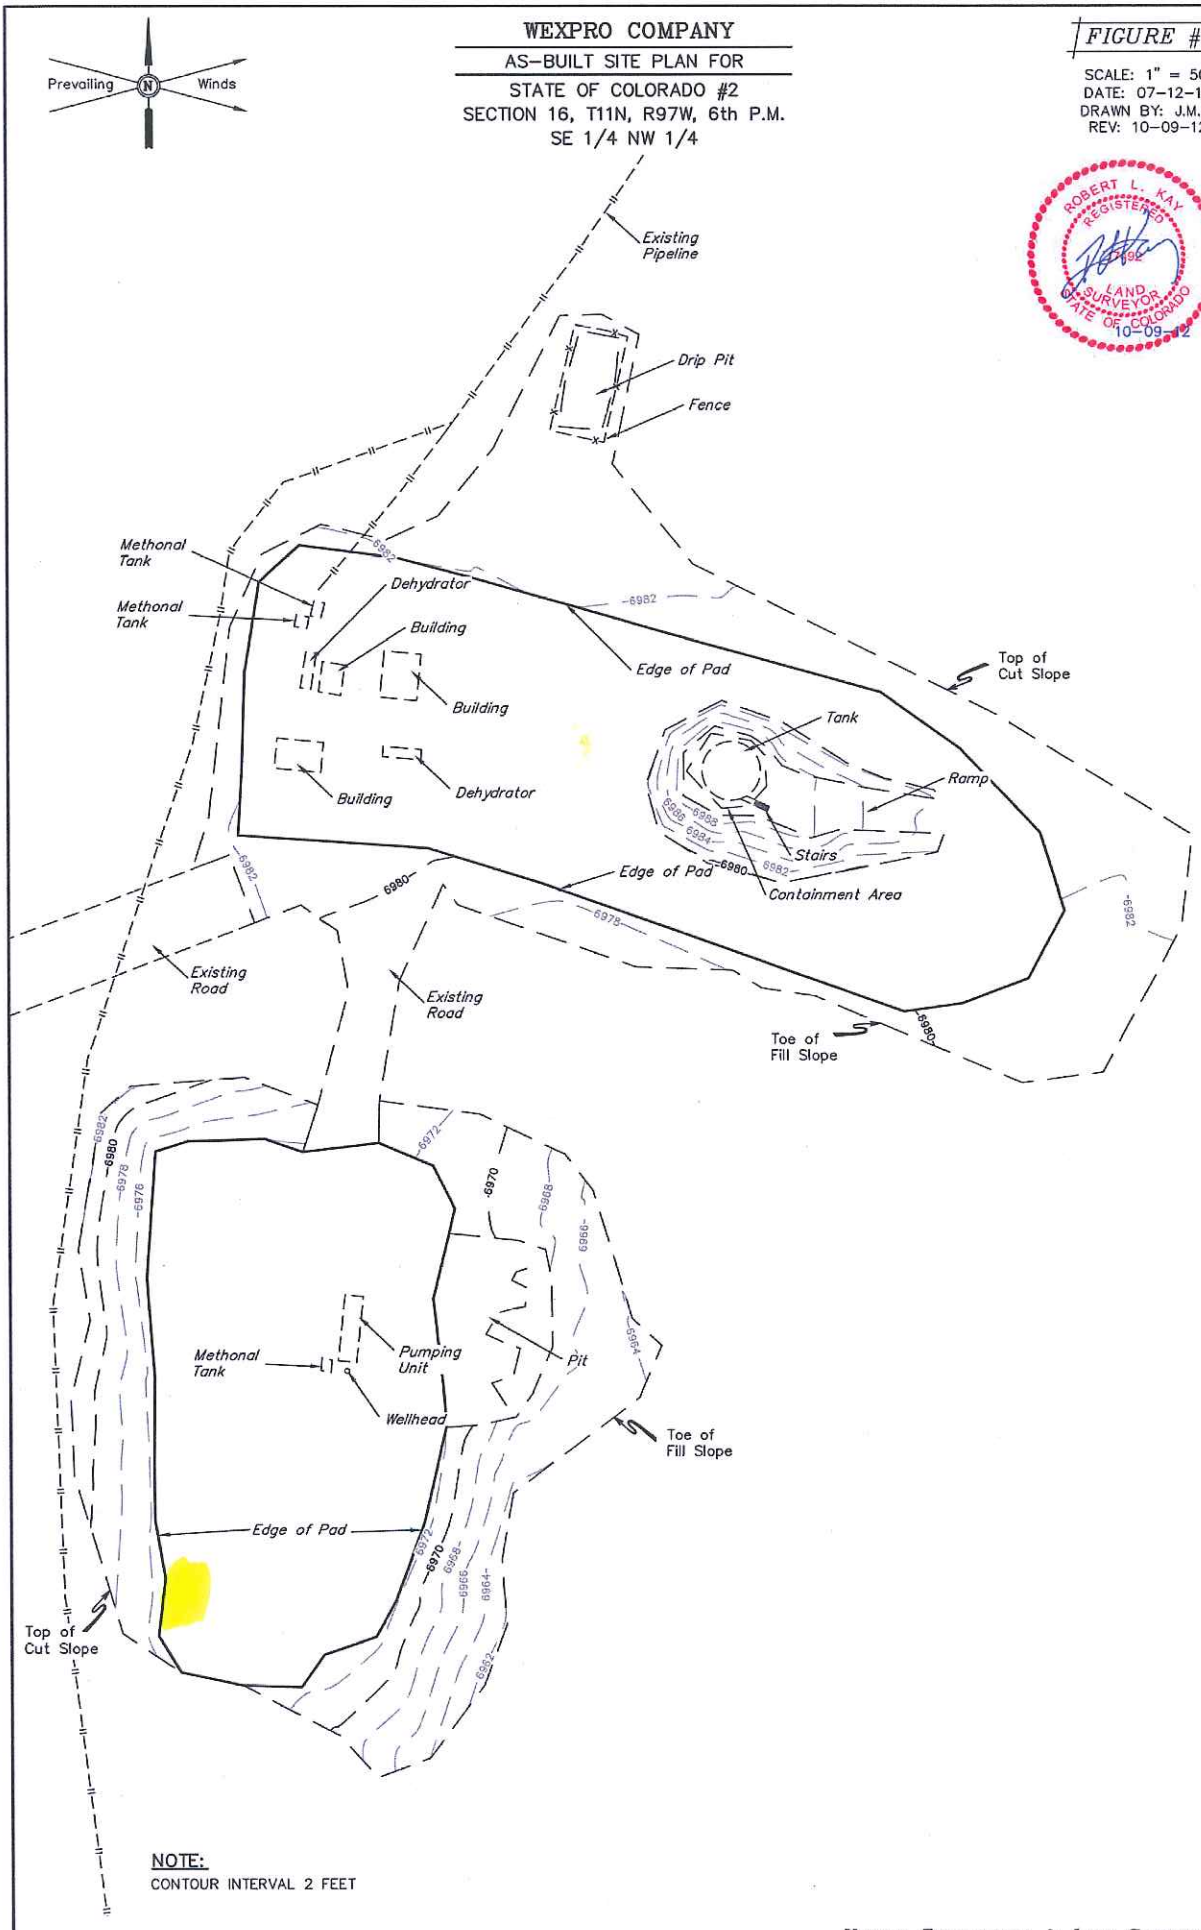

NOTE:
CONTOUR INTERVAL 2 FEET

FINISHED GRADE ELEV. AT LOC. STAKE = 6973.6'

UINTAH ENGINEERING & LAND SURVEYING
85 So. 200 East * Vernal, Utah 84078 * (435) 789-1017