

WagonTrack 12-6 and 12-8

Location ID 312668
Location ID 312667
Document 2527480

**Red Lines**

OIL AND GAS WELLS

-  Oil and Gas Wells
-  Temporary Point
- API Number

**COGCC ALERT**

**ONSITE INSPECTION**

CITIES TOWNS PLACES

-  Towns and Places

ROADS AND RRS

-  Major Highways
-  Major Roads
-  Forest Service Roads
-  Local Roads

ENVIRONMENTAL_SITES

-  CDPHE_EnvCovnt
-  DOE_UMTRA
-  Garfield UMTRA Zone

RULISON_RIOBLANCO


-  Piceance DOE Notice

SAN JUAN BASIN

-  Fruitland PC

**MUNICIPAL BOUNDARIES**

**AERIALS2009**

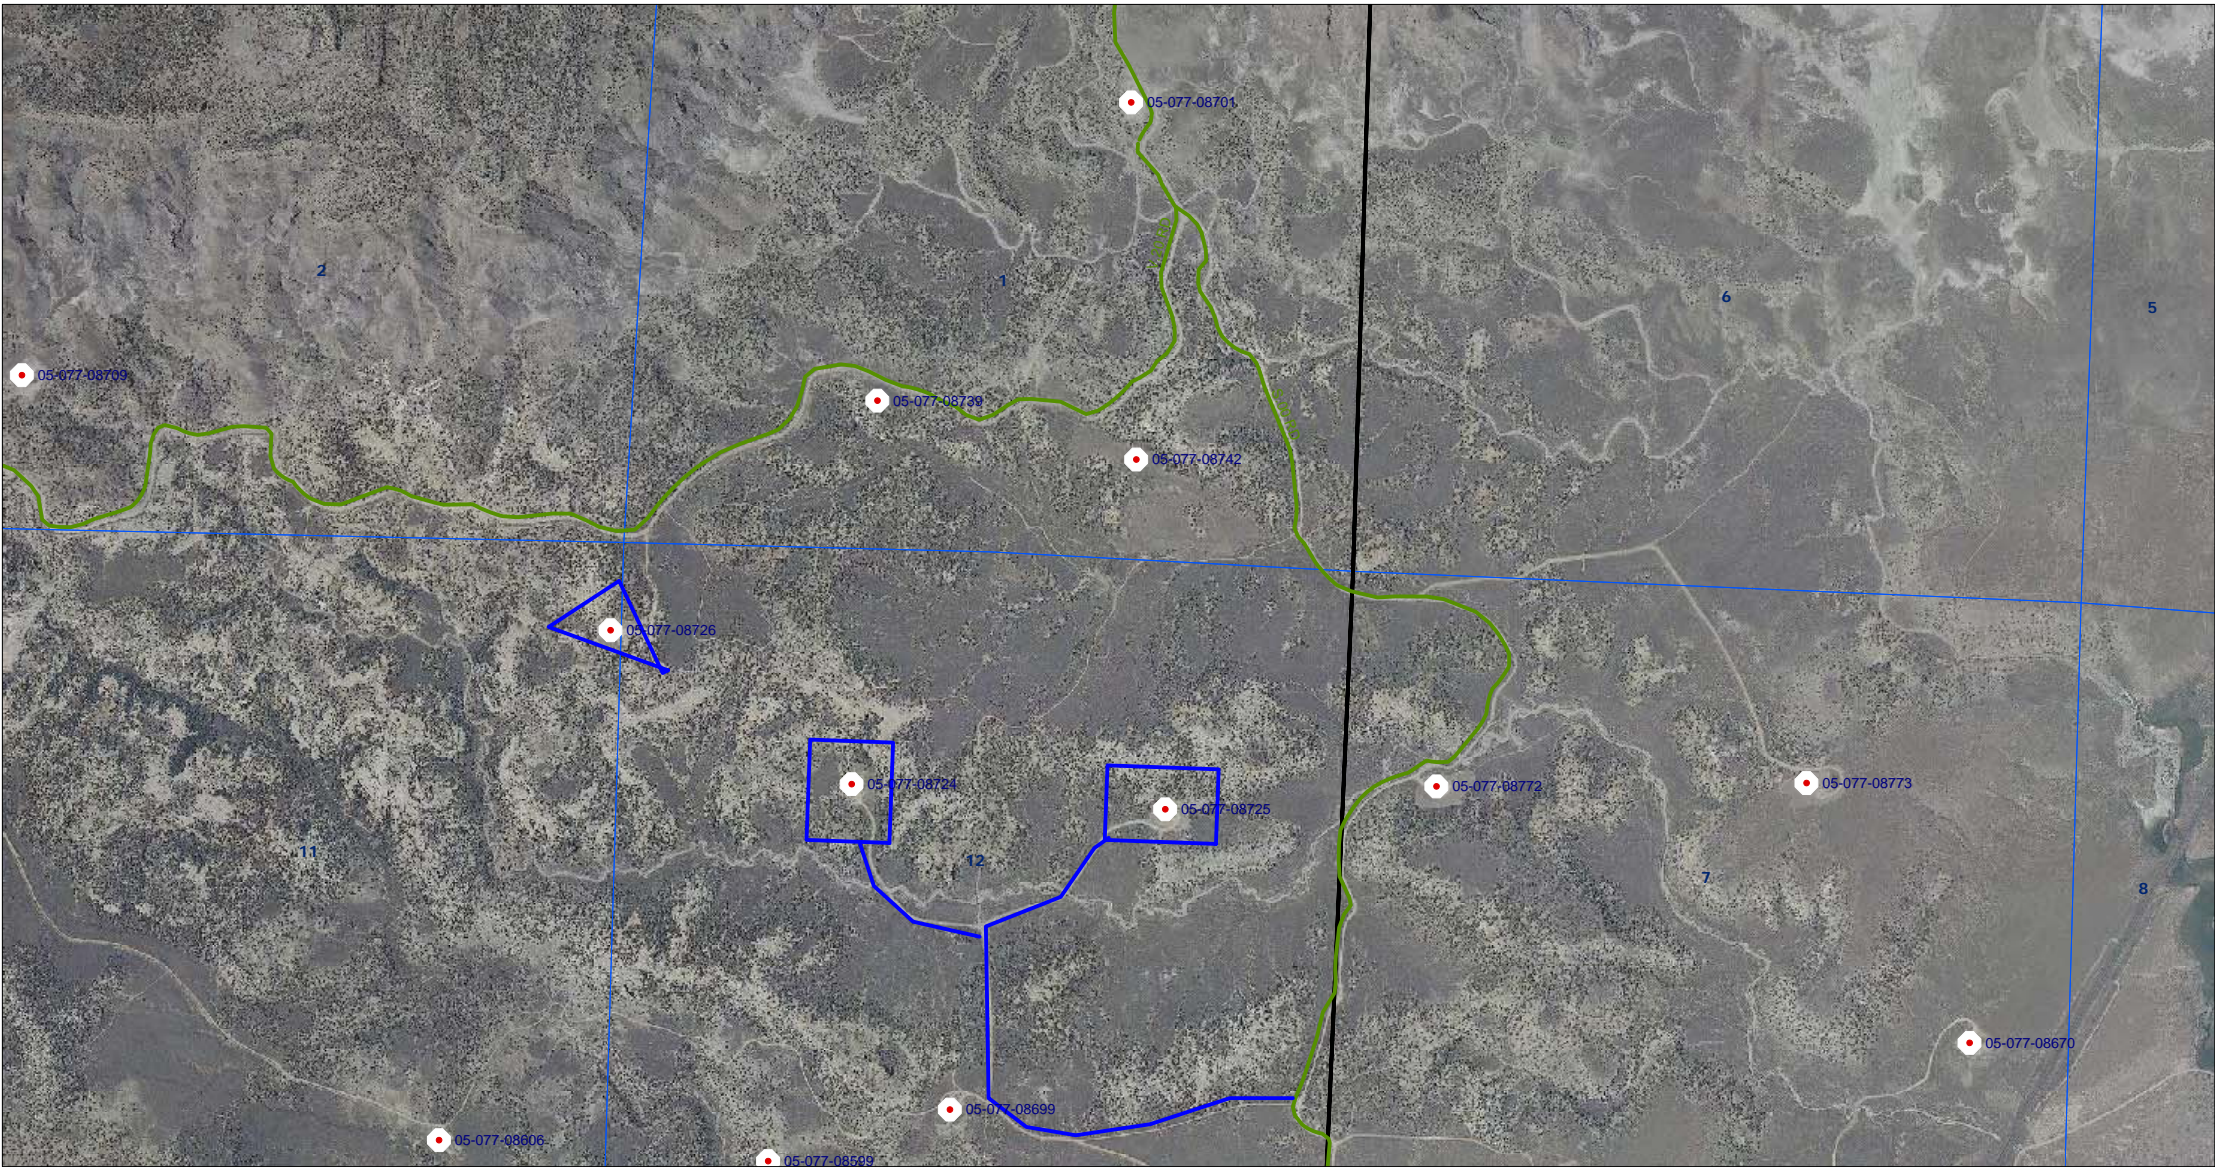

SCALE 1 : 16,654

