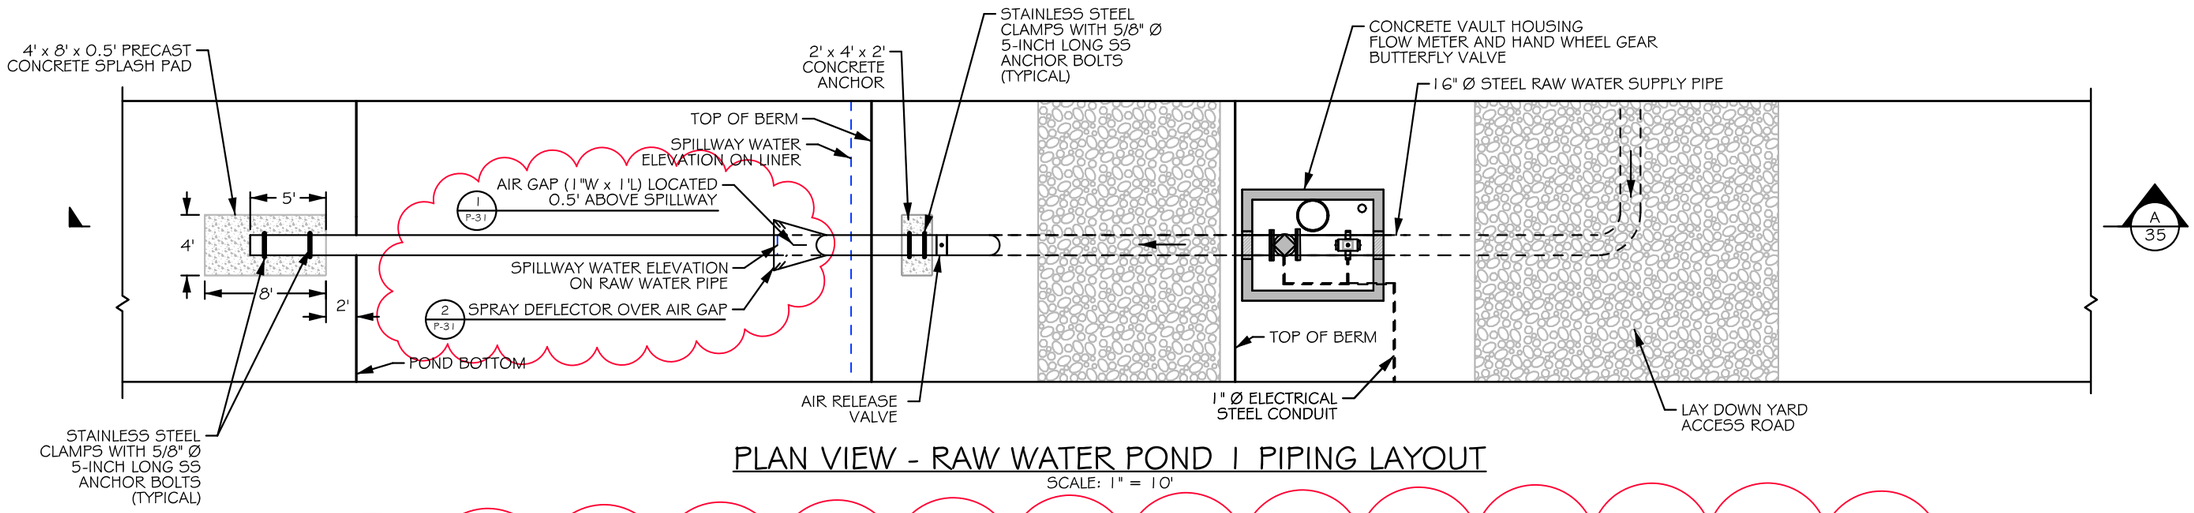

PLAN VIEW - RAW WATER POND 1 PIPING LAYOUT

SCALE: 1" = 10'

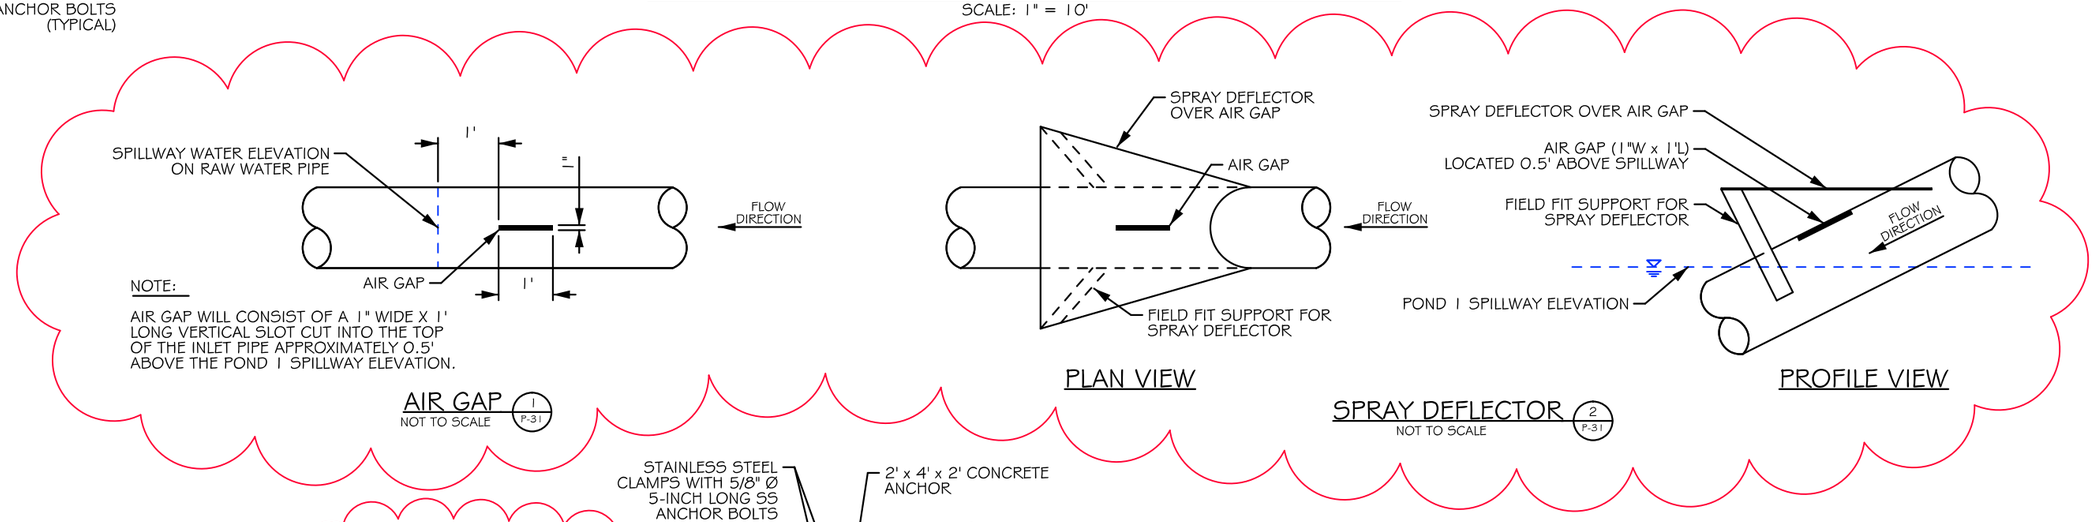

PLAN VIEW

PROFILE VIEW

AIR GAP 1 P-31 NOT TO SCALE

SPRAY DEFLECTOR 2 P-31 NOT TO SCALE

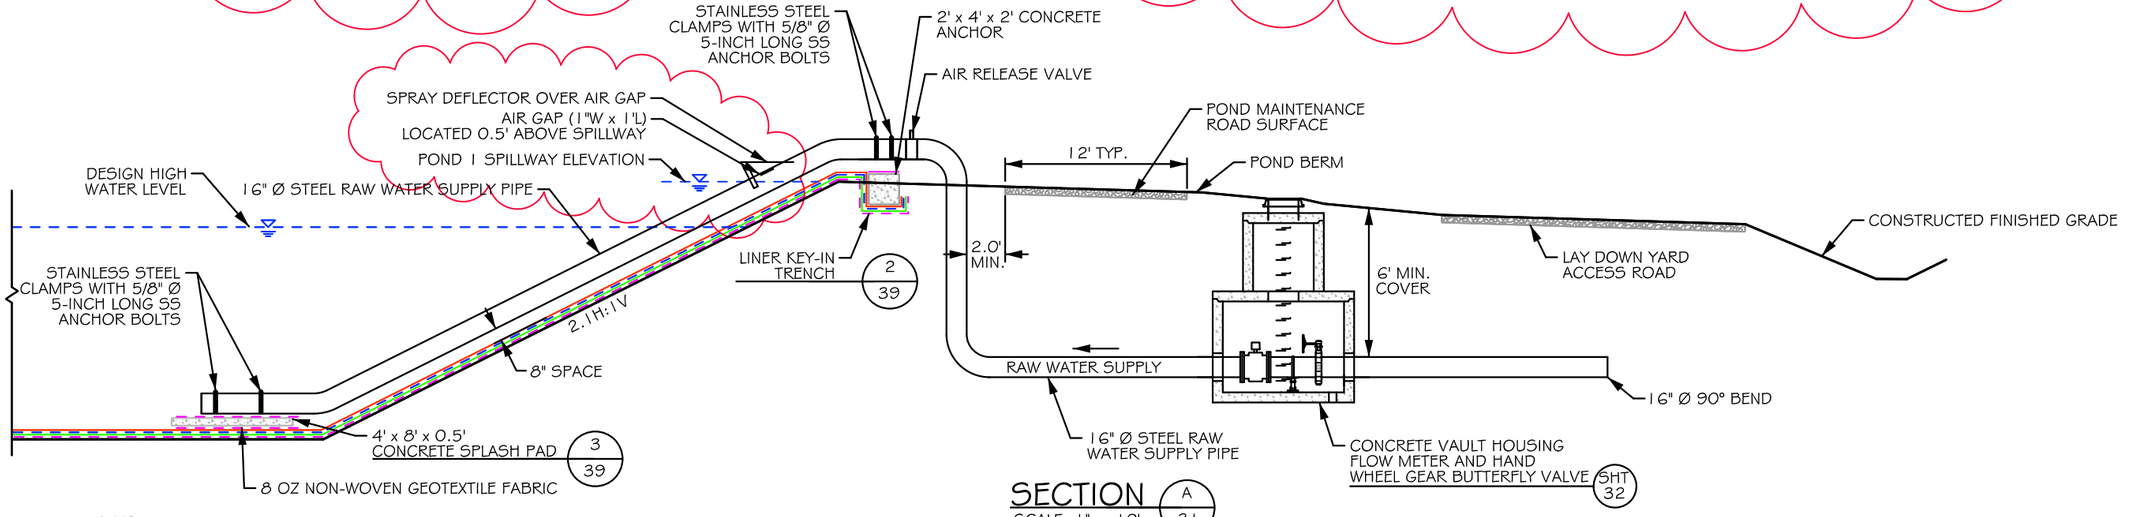

SECTION A 31
SCALE: 1" = 10'

NOTES:

1) LINERS ARE BE SMOOTH 60-MIL HDPE LINER.

COPYRIGHT 2015
WWC ENGINEERING, HEREBY RESERVES OUR COMMON LAW COPYRIGHT AND OTHER PROPERTY RIGHTS IN THESE PLANS, IDEAS AND DESIGNS INCORPORATED HEREIN AS AN INSTRUMENT OF PROFESSIONAL SERVICE. THESE PLANS SHALL NOT BE USED IN WHOLE OR PART FOR ANY PROJECTS OR OTHER USE WITHOUT OUR EXPRESS WRITTEN AUTHORIZATION.

WWC ENGINEERING
1275 MAPLE STREET, SUITE F
HELENA, MT 59601
(406) 443-3962

2350 G Road, Suite 101
Grand Junction, CO 81505

PEN TABLE PATH: K:\Admin\BLACK HILLS\13134 - DE BEQUE STATION\ENGINEERING PLANS\DEBEQUE COLOR.tbl
FILE PATH: K:\Admin\BLACK HILLS\13134 - DE BEQUE STATION\DGN\PHASE 1 AS-BUILTS\13134 - Pond 1 PLANS AS-BUILTS.dgn
5/17/2017

DSGN	DATE	CKD
EMI	09/15	KJG
REV	DATE	CKD
KJG	05/17	STH

JOB # 2013-134

DE BEQUE WATER STATION
POND 1 RECORD DRAWINGS

Raw Water Pond Piping Details

SHEET
31