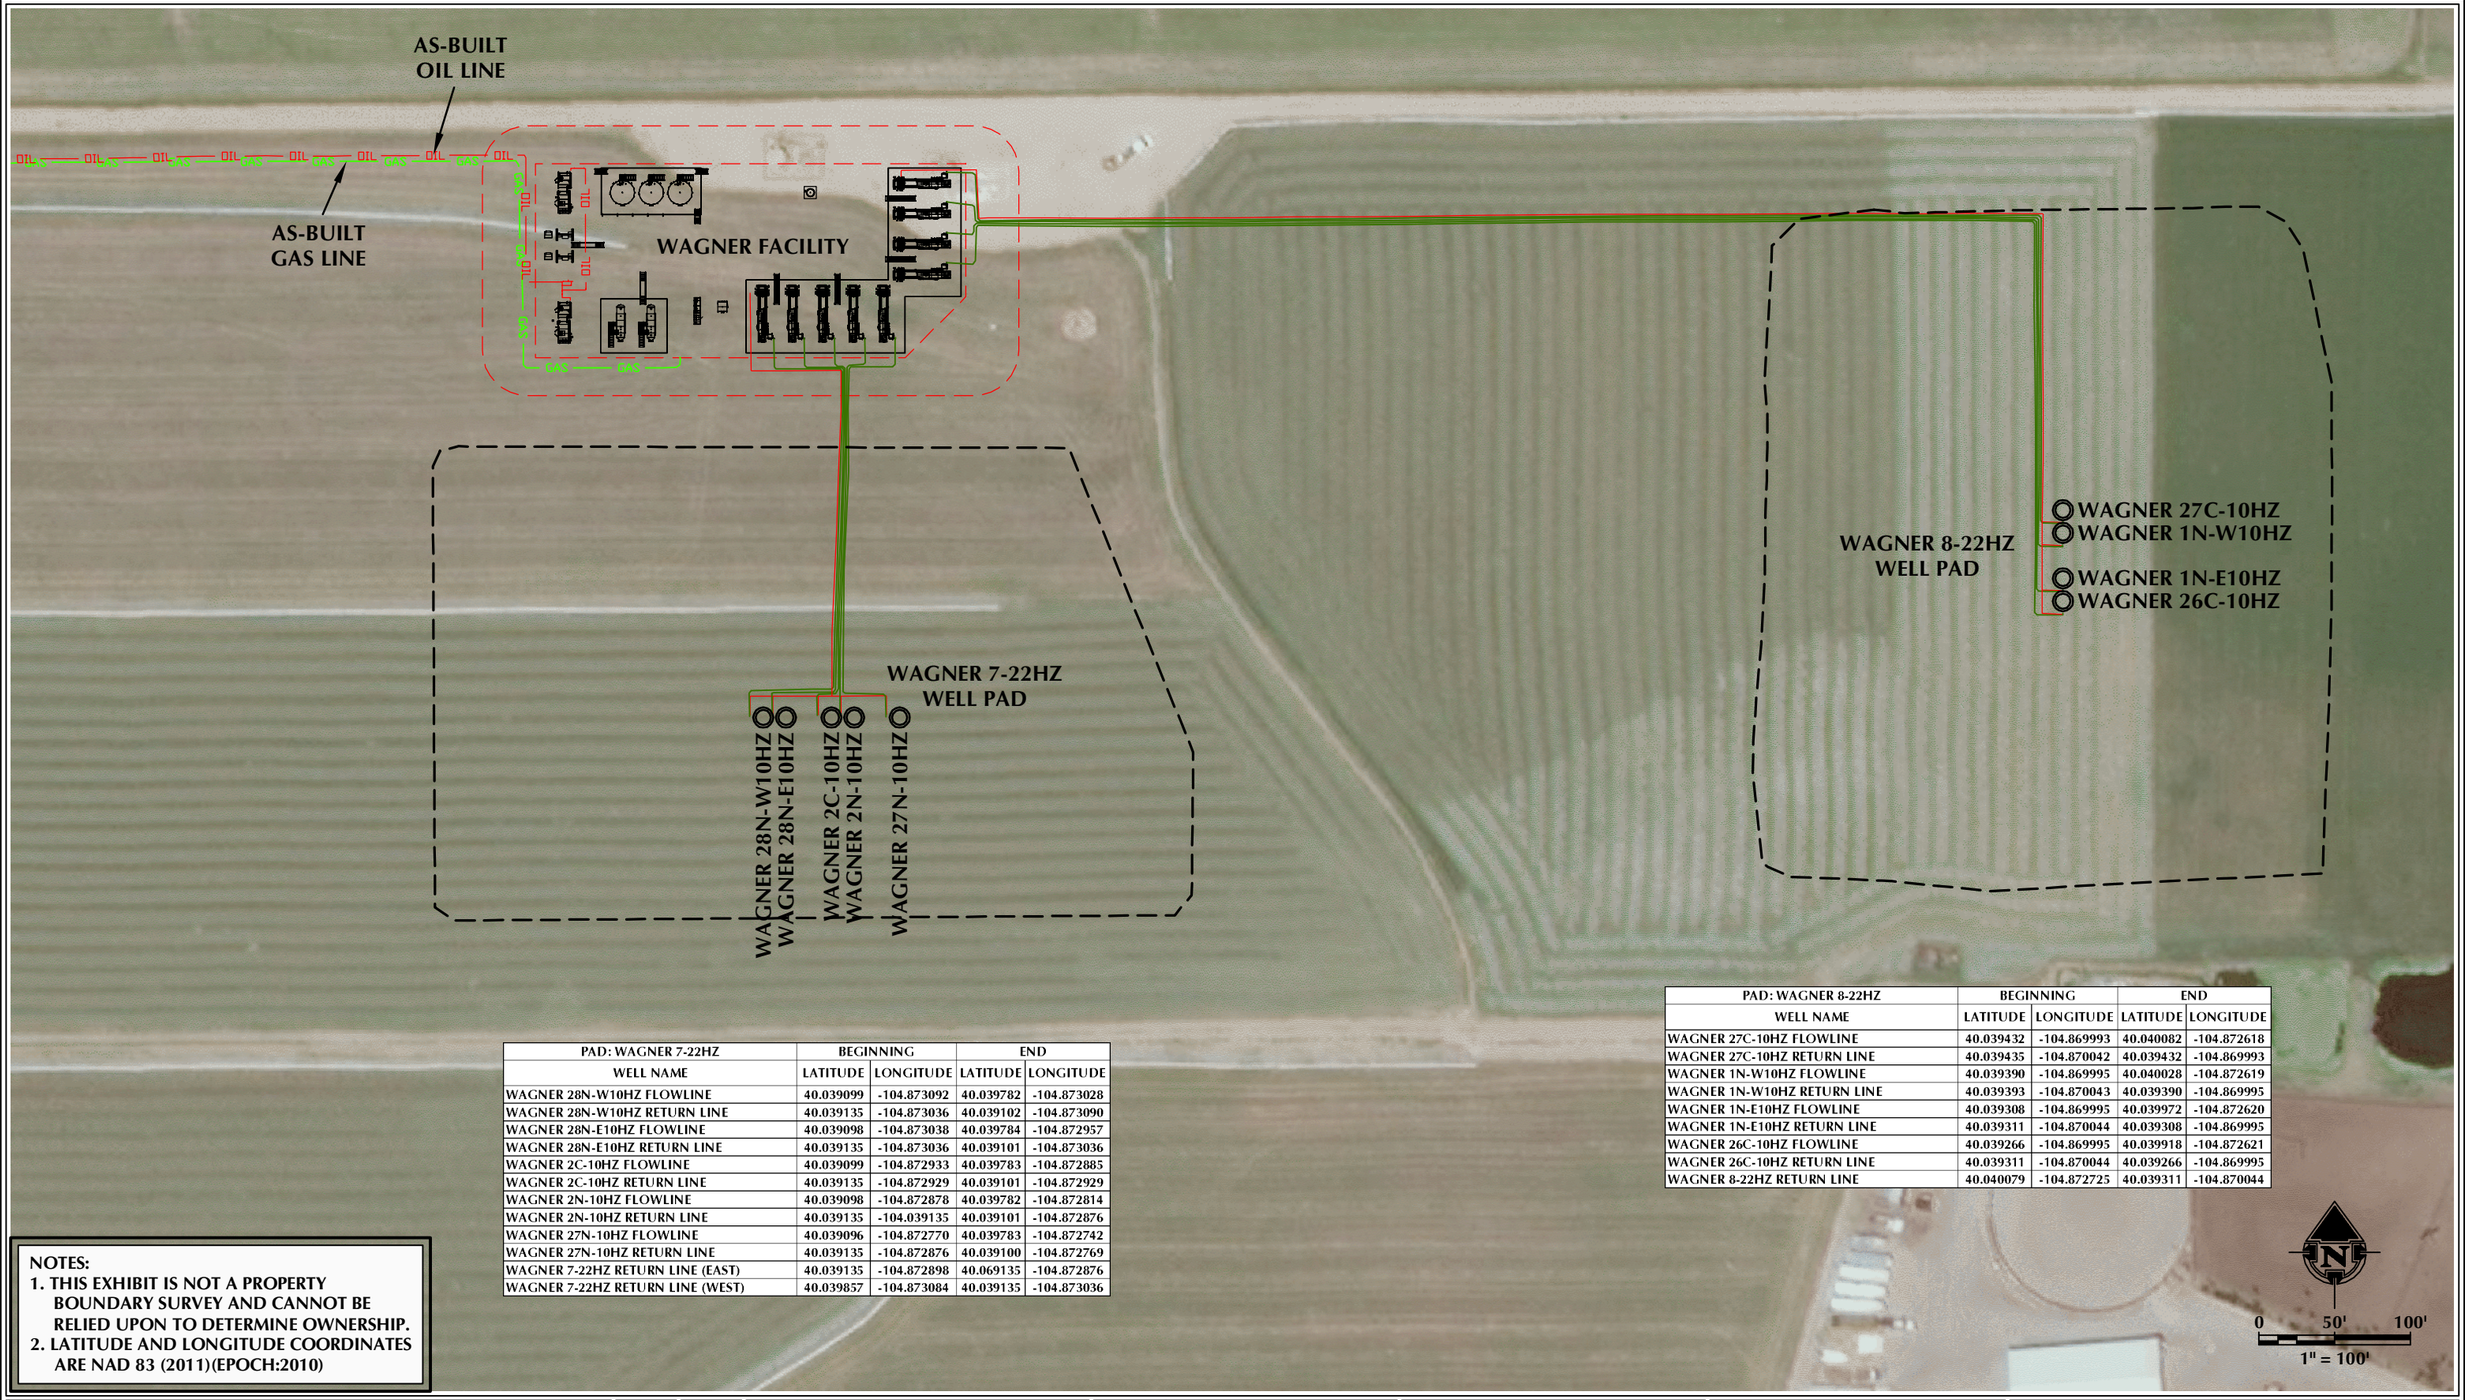

PAD: WAGNER 7-22HZ	BEGINNING		END	
WELL NAME	LATITUDE	LONGITUDE	LATITUDE	LONGITUDE
WAGNER 28N-W10HZ FLOWLINE	40.039099	-104.873092	40.039782	-104.873028
WAGNER 28N-W10HZ RETURN LINE	40.039135	-104.873036	40.039102	-104.873090
WAGNER 28N-E10HZ FLOWLINE	40.039098	-104.873038	40.039784	-104.872957
WAGNER 28N-E10HZ RETURN LINE	40.039135	-104.873036	40.039101	-104.873036
WAGNER 2C-10HZ FLOWLINE	40.039099	-104.872933	40.039783	-104.872885
WAGNER 2C-10HZ RETURN LINE	40.039135	-104.872929	40.039101	-104.872929
WAGNER 2N-10HZ FLOWLINE	40.039098	-104.872878	40.039782	-104.872814
WAGNER 2N-10HZ RETURN LINE	40.039135	-104.039135	40.039101	-104.872876
WAGNER 27N-10HZ FLOWLINE	40.039096	-104.872770	40.039783	-104.872742
WAGNER 27N-10HZ RETURN LINE	40.039135	-104.872876	40.039100	-104.872769
WAGNER 7-22HZ RETURN LINE (EAST)	40.039135	-104.872898	40.069135	-104.872876
WAGNER 7-22HZ RETURN LINE (WEST)	40.039857	-104.873084	40.039135	-104.873036

PAD: WAGNER 8-22HZ	BEGINNING		END	
WELL NAME	LATITUDE	LONGITUDE	LATITUDE	LONGITUDE
WAGNER 27C-10HZ FLOWLINE	40.039432	-104.869993	40.040082	-104.872618
WAGNER 27C-10HZ RETURN LINE	40.039435	-104.870042	40.039432	-104.869993
WAGNER 1N-W10HZ FLOWLINE	40.039390	-104.869995	40.040028	-104.872619
WAGNER 1N-W10HZ RETURN LINE	40.039393	-104.870043	40.039390	-104.869995
WAGNER 1N-E10HZ FLOWLINE	40.039308	-104.869995	40.039972	-104.872620
WAGNER 1N-E10HZ RETURN LINE	40.039311	-104.870044	40.039308	-104.869995
WAGNER 26C-10HZ FLOWLINE	40.039266	-104.869995	40.039918	-104.872621
WAGNER 26C-10HZ RETURN LINE	40.039311	-104.870044	40.039266	-104.869995
WAGNER 8-22HZ RETURN LINE	40.040079	-104.872725	40.039311	-104.870044

NOTES:
1. THIS EXHIBIT IS NOT A PROPERTY BOUNDARY SURVEY AND CANNOT BE RELIED UPON TO DETERMINE OWNERSHIP.
2. LATITUDE AND LONGITUDE COORDINATES ARE NAD 83 (2011)(EPOCH:2010)

LEGEND:
- AS-BUILT WELL
- AS-BUILT FLOWLINE
- AS-BUILT AIR RETURN
- GAS — AS-BUILT GAS PIPELINE
- OIL — AS-BUILT OIL PIPELINE
- EPL — PIPELINE EXISTING

DATA SOURCES:
-AERIAL COURTESY OF ESRI, INC.

REV.	DATE	DESCRIPTION
A	7/10/18	

609 CONSULTING, LLC
LOVELAND OFFICE
6706 North Franklin Avenue
Loveland, Colorado 80538
Phone 970-776-4331
SHERIDAN OFFICE
1095 Saberton Avenue
Sheridan, Wyoming 82801
Phone 307-674-0609

Anadarko Petroleum Corporation
1099 18th Street
Denver, CO 80202

SCALE:	1" = 100'
DATE SURVEYED:	N/A
DATE:	7/10/18
DRAFTER:	GLK
REVISED:	

WAGNER 7-22HZ & WAGNER 8-22HZ FLOWLINE / RETURN LINE ROUTE

LOCATED IN SECTION 22
T1N, R67W, 6TH P.M.
WELD COUNTY, COLORADO

K:\ANADARKO\2018\2018_47_WAGNER_7-22HZ_8_8-22HZ_FL_AS-BUILTDWG\WAGNER_FLOWLINES.dwg, 7/11/2018 11:50:32 AM, garrett