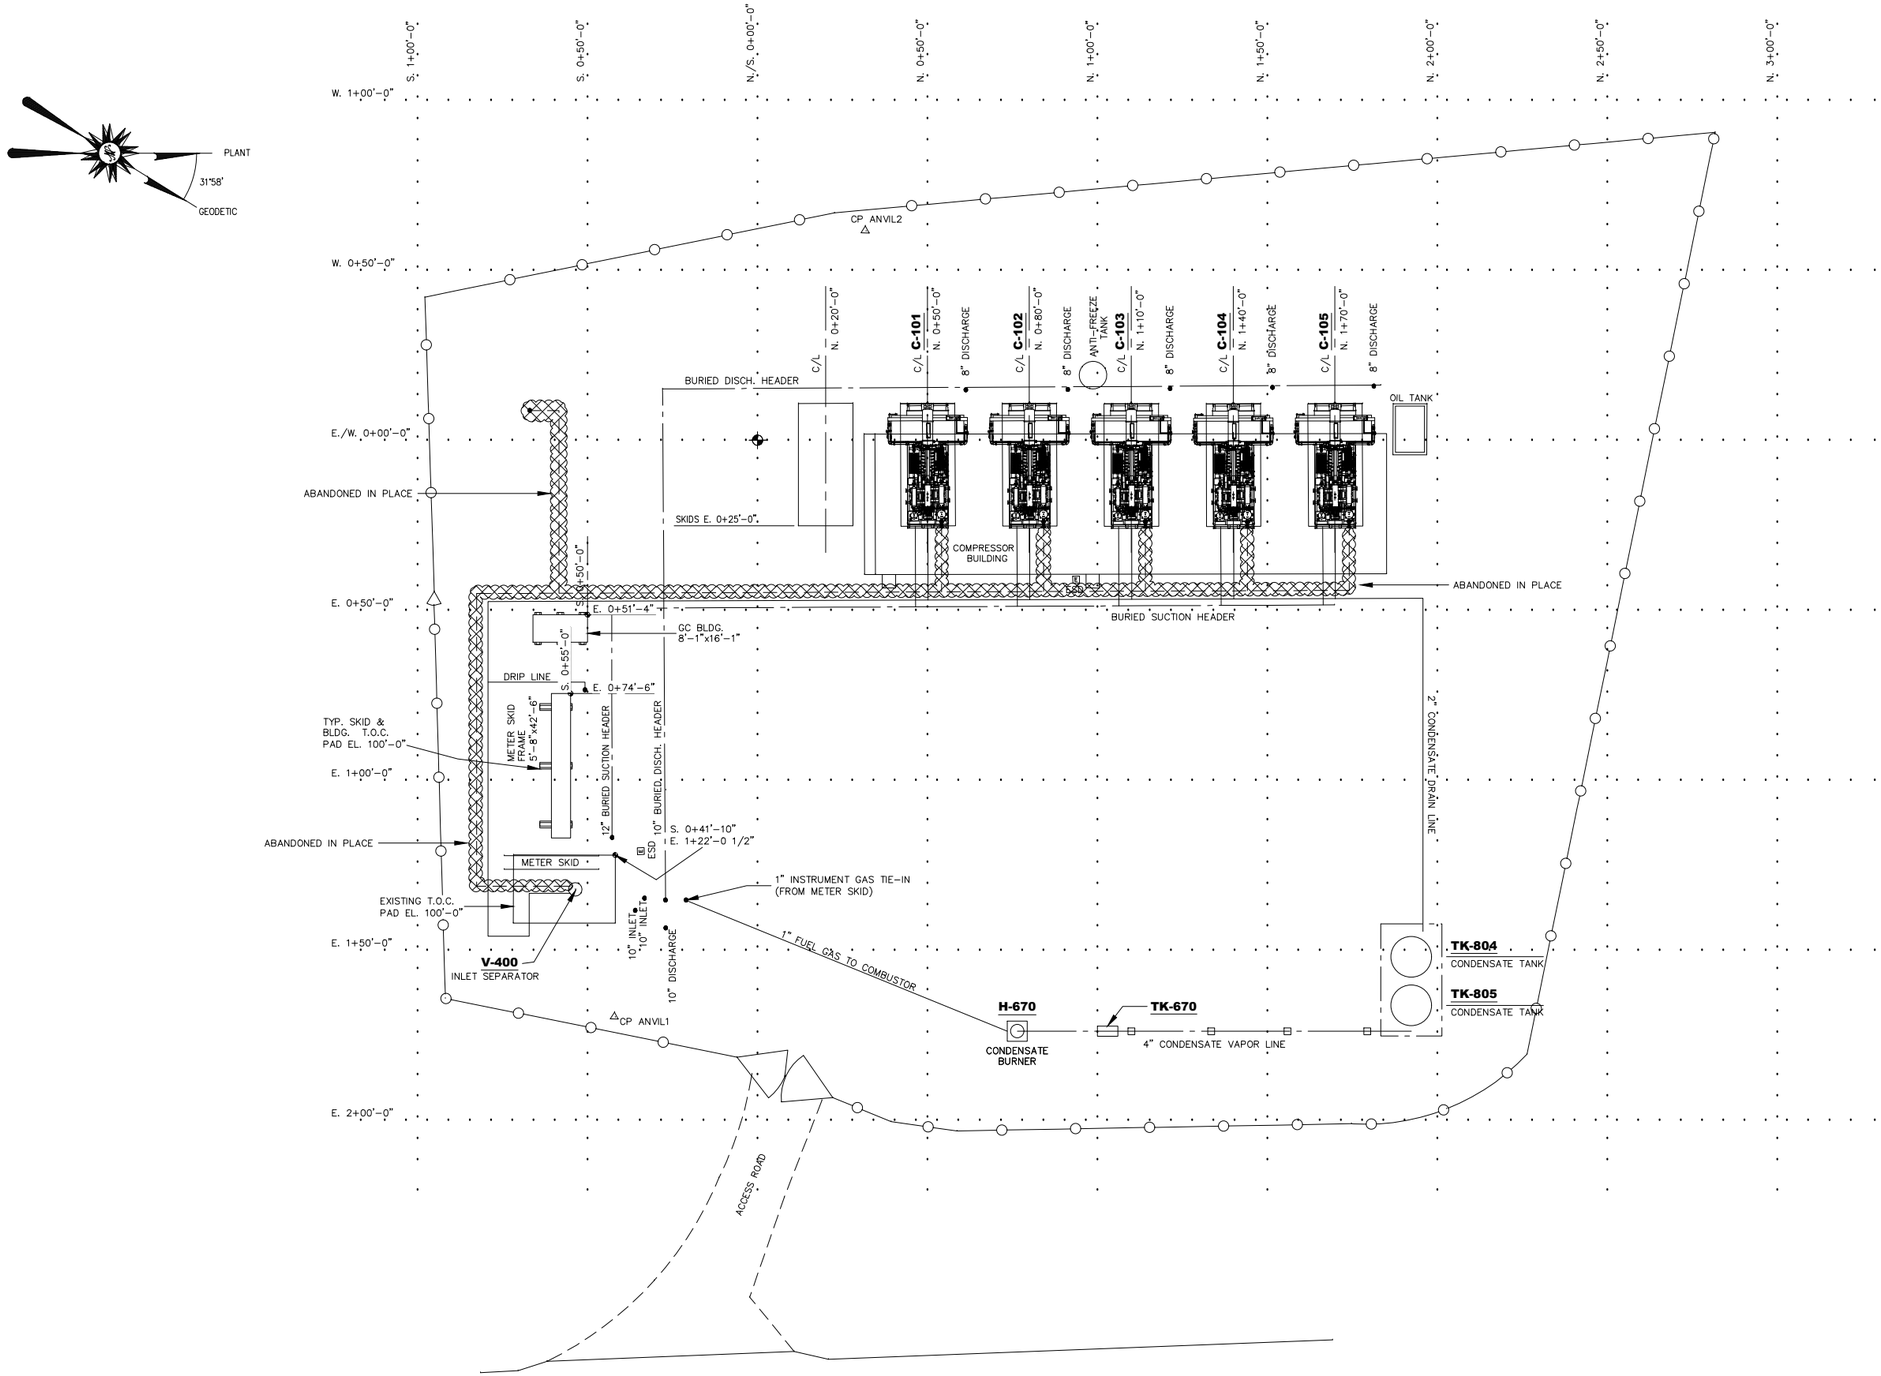

NOTES	DRAWING STATUS	REFERENCE DRAWINGS	
NOTES: 1. COORDINATES PROVIDED ARE BASED ON EXISTING SITE SURVEY.	REVISED DATE: 09/03/19 DESTROY ALL PREVIOUS REV'S	DRAWING NUMBER	DRAWING TITLE

REVISIONS

REV:	DRAWN BY:	DATE REVISED:	CHECKED BY:	APPROVED BY:
4	TITLEBLOCK UPDATE			
	JK	09/03/19		
3	MOC# 122327 - REPLACED CONDENSATE SYSTEM, RELOCATE CONDENSATE TANKS			
	JK	03/21/13		
2	ADDED COORDINATES FOR SEP PAD AND EQUIPMENT NUMBERS			
	RMR	02/12/12	RDR	RDR
1	RELOCATED COMBUSTER, ADDED METER SKID AND GC BUILDING			
	RDR	12/20/11		
0	ISSUED AS EXISTING			
	GW	07/13/11		
A	ISSUED AS-BUILT			
	SET	07/08/11		

Williams.

COUNTY/PARISH: GARFIELD | STATE: COLORADO
TOWNSHIP: RANGE: SECTION: | LAT/LONG: 39.512544 N/-107.919872 W
DRAWN BY: SET (RIVER CITY) | DATE: 07/08/11
CHECKED BY: | DATE:
APPROVED BY: | DATE:
ENGINEER:
WORK ORDER NUMBER/PROJECT NUMBER:
OLD DRAWING NUMBER: AP-PP-001

WILLIAMS FIELD SERVICES - PICEANCE BASIN
ANVIL POINT COMPRESSOR STATION

PLOT PLAN

DRAWING NUMBER: AP-P10-001
DRAWING SCALE: 1-1/8" = 50'-0"
DATE ISSUED:
SHEET NUMBER: 1 OF 1
REVISION: 4

D SIZE (34.00)
C:\Users\jjustus\OneDrive - Williams\Documents\CAD\Manager Workspace\AP-P10-001 (PLOT PLAN).dwg Sep 04, 2019 - 12:33pm jjustus