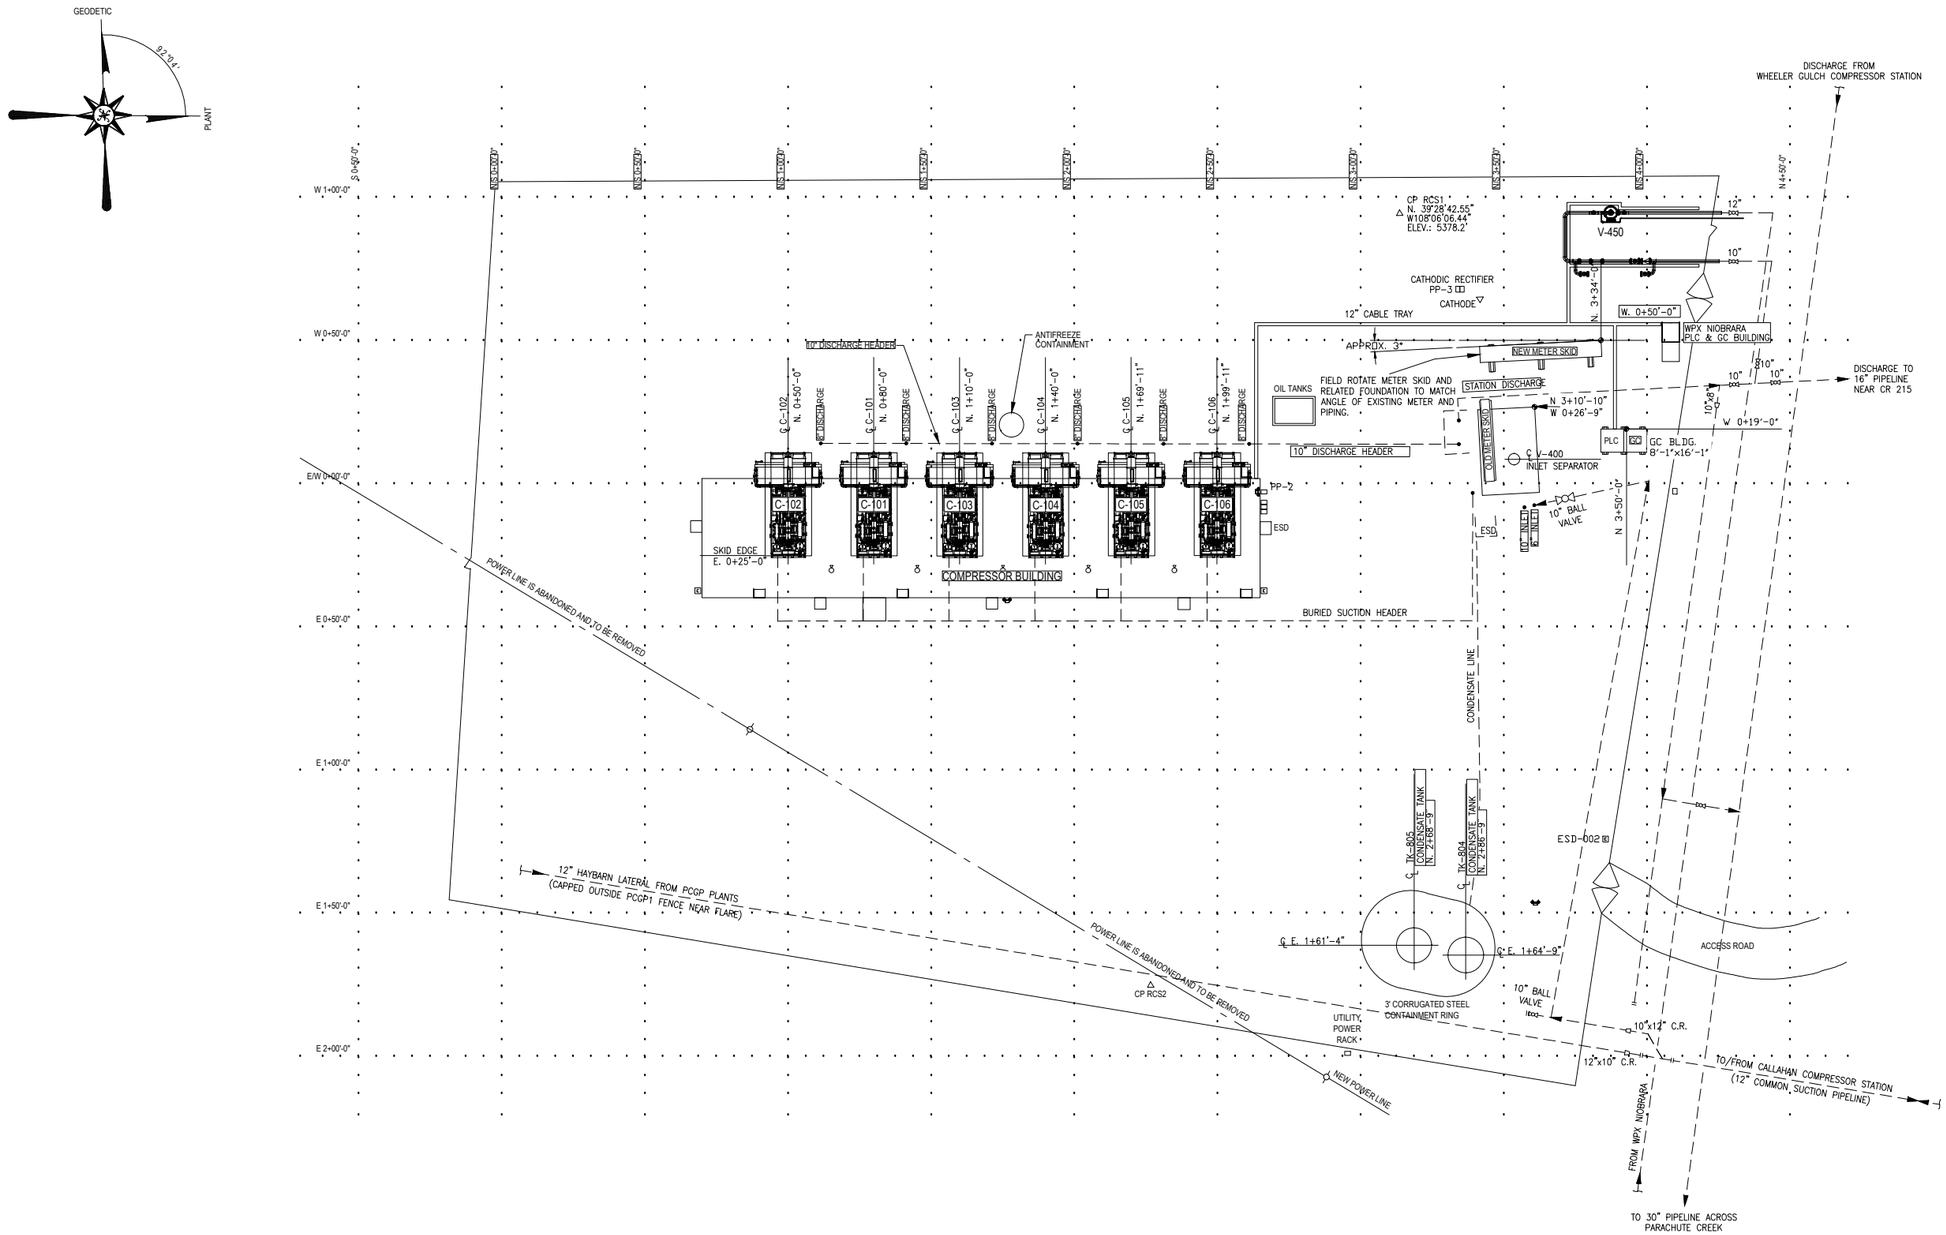

NOTES	DRAWING STATUS	REFERENCE DRAWINGS	
	REVISED DATE: 09/04/19 DESTROY ALL PREVIOUS REV'S	DRAWING NUMBER	DRAWING TITLE

REVISIONS

REV:	DRAWN BY:	DATE REVISED:	CHECKED BY:	APPROVED BY:
10	TITLEBLOCK UPDATED			
	JK	09/04/19		
9	ADDED UNDERGROUND PIPING FOR NIOBRARA TIE-IN			
	JK	02/26/16		
8	MOC# 153643 - NIOBRARA INLET SEPARATOR INSTALLED - AS-BUILT			
	JK	08/19/15		
7	MOC# 143564 - HBGP 12" LATERAL TO COMMON SUCTION FROM CACS TO RICS			
	JK	10/28/14		
6	MOC# 133225 - AUTOMATION INSTALL/UPDATE PHASE 2 - AS-BUILT			
	JK	05/12/14		
5	MOC# 1101708 - GC BUILDING AS-BUILT			
	JK	02/25/13		

Williams.

COUNTY/PARISH: GARFIELD STATE: COLORADO
TOWNSHIP: RANGE: SECTION: LAT/LONG: 39.478137 N/-108.102192 W
DRAWN BY: TJL (SE, INC) DATE: 07/12/11
CHECKED BY: DATE:
APPROVED BY: DATE:
ENGINEER:
WORK ORDER NUMBER/PROJECT NUMBER:
OLD DRAWING NUMBER: RI-PP-001

WILLIAMS FIELD SERVICES - PICEANCE BASIN

RILEY GULCH COMPRESSOR STATION

PLOT PLAN

DRAWING NUMBER: RI-P10-001
REVISION: 10
DRAWING SCALE: 1" = 50'-0"
DATE ISSUED:
SHEET NUMBER: 1 OF 1

D SIZE (24X36)
C:\Users\jaklass\OneDrive - Williams\Documents\CAD Manager\Workspace\RI-P10-001 (PLOT PLAN).dwg Sep 04, 2019 - 2:15pm jaklass