


PAD: QUARTER CIRCLE 13-24HZ		BEGINNING		END	
WELL NAME	LATITUDE	LONGITUDE	LATITUDE	LONGITUDE	
QUARTER CIRCLE 24-1HZ FLOWLINE	40.030323	-104.844270	40.030271	-104.844838	
QUARTER CIRCLE 24-2HZ FLOWLINE	40.030323	-104.844215	40.030215	-104.844839	
QUARTER CIRCLE 24-3HZ FLOWLINE	40.030323	-104.844108	40.030160	-104.844839	
QUARTER CIRCLE 24-4HZ FLOWLINE	40.030324	-104.844053	40.030105	-104.844840	
QUARTER CIRCLE 24-5HZ FLOWLINE	40.030323	-104.843947	40.030051	-104.844842	

PAD: QUARTER CIRCLE 14-24HZ		BEGINNING		END	
WELL NAME	LATITUDE	LONGITUDE	LATITUDE	LONGITUDE	
QUARTER CIRCLE 24-6HZ FLOWLINE	40.030333	-104.842004	40.029996	-104.844842	
QUARTER CIRCLE 24-7HZ FLOWLINE	40.030334	-104.841952	40.029855	-104.844960	
QUARTER CIRCLE 24-8HZ FLOWLINE	40.030333	-104.841843	40.029856	-104.845032	
QUARTER CIRCLE 24-9HZ FLOWLINE	40.030333	-104.841790	40.029856	-104.845103	
QUARTER CIRCLE 24-10HZ FLOWLINE	40.030332	-104.841682	40.029857	-104.845175	
QUARTER CIRCLE 24-11HZ FLOWLINE	40.030332	-104.841629	40.029857	-104.845246	

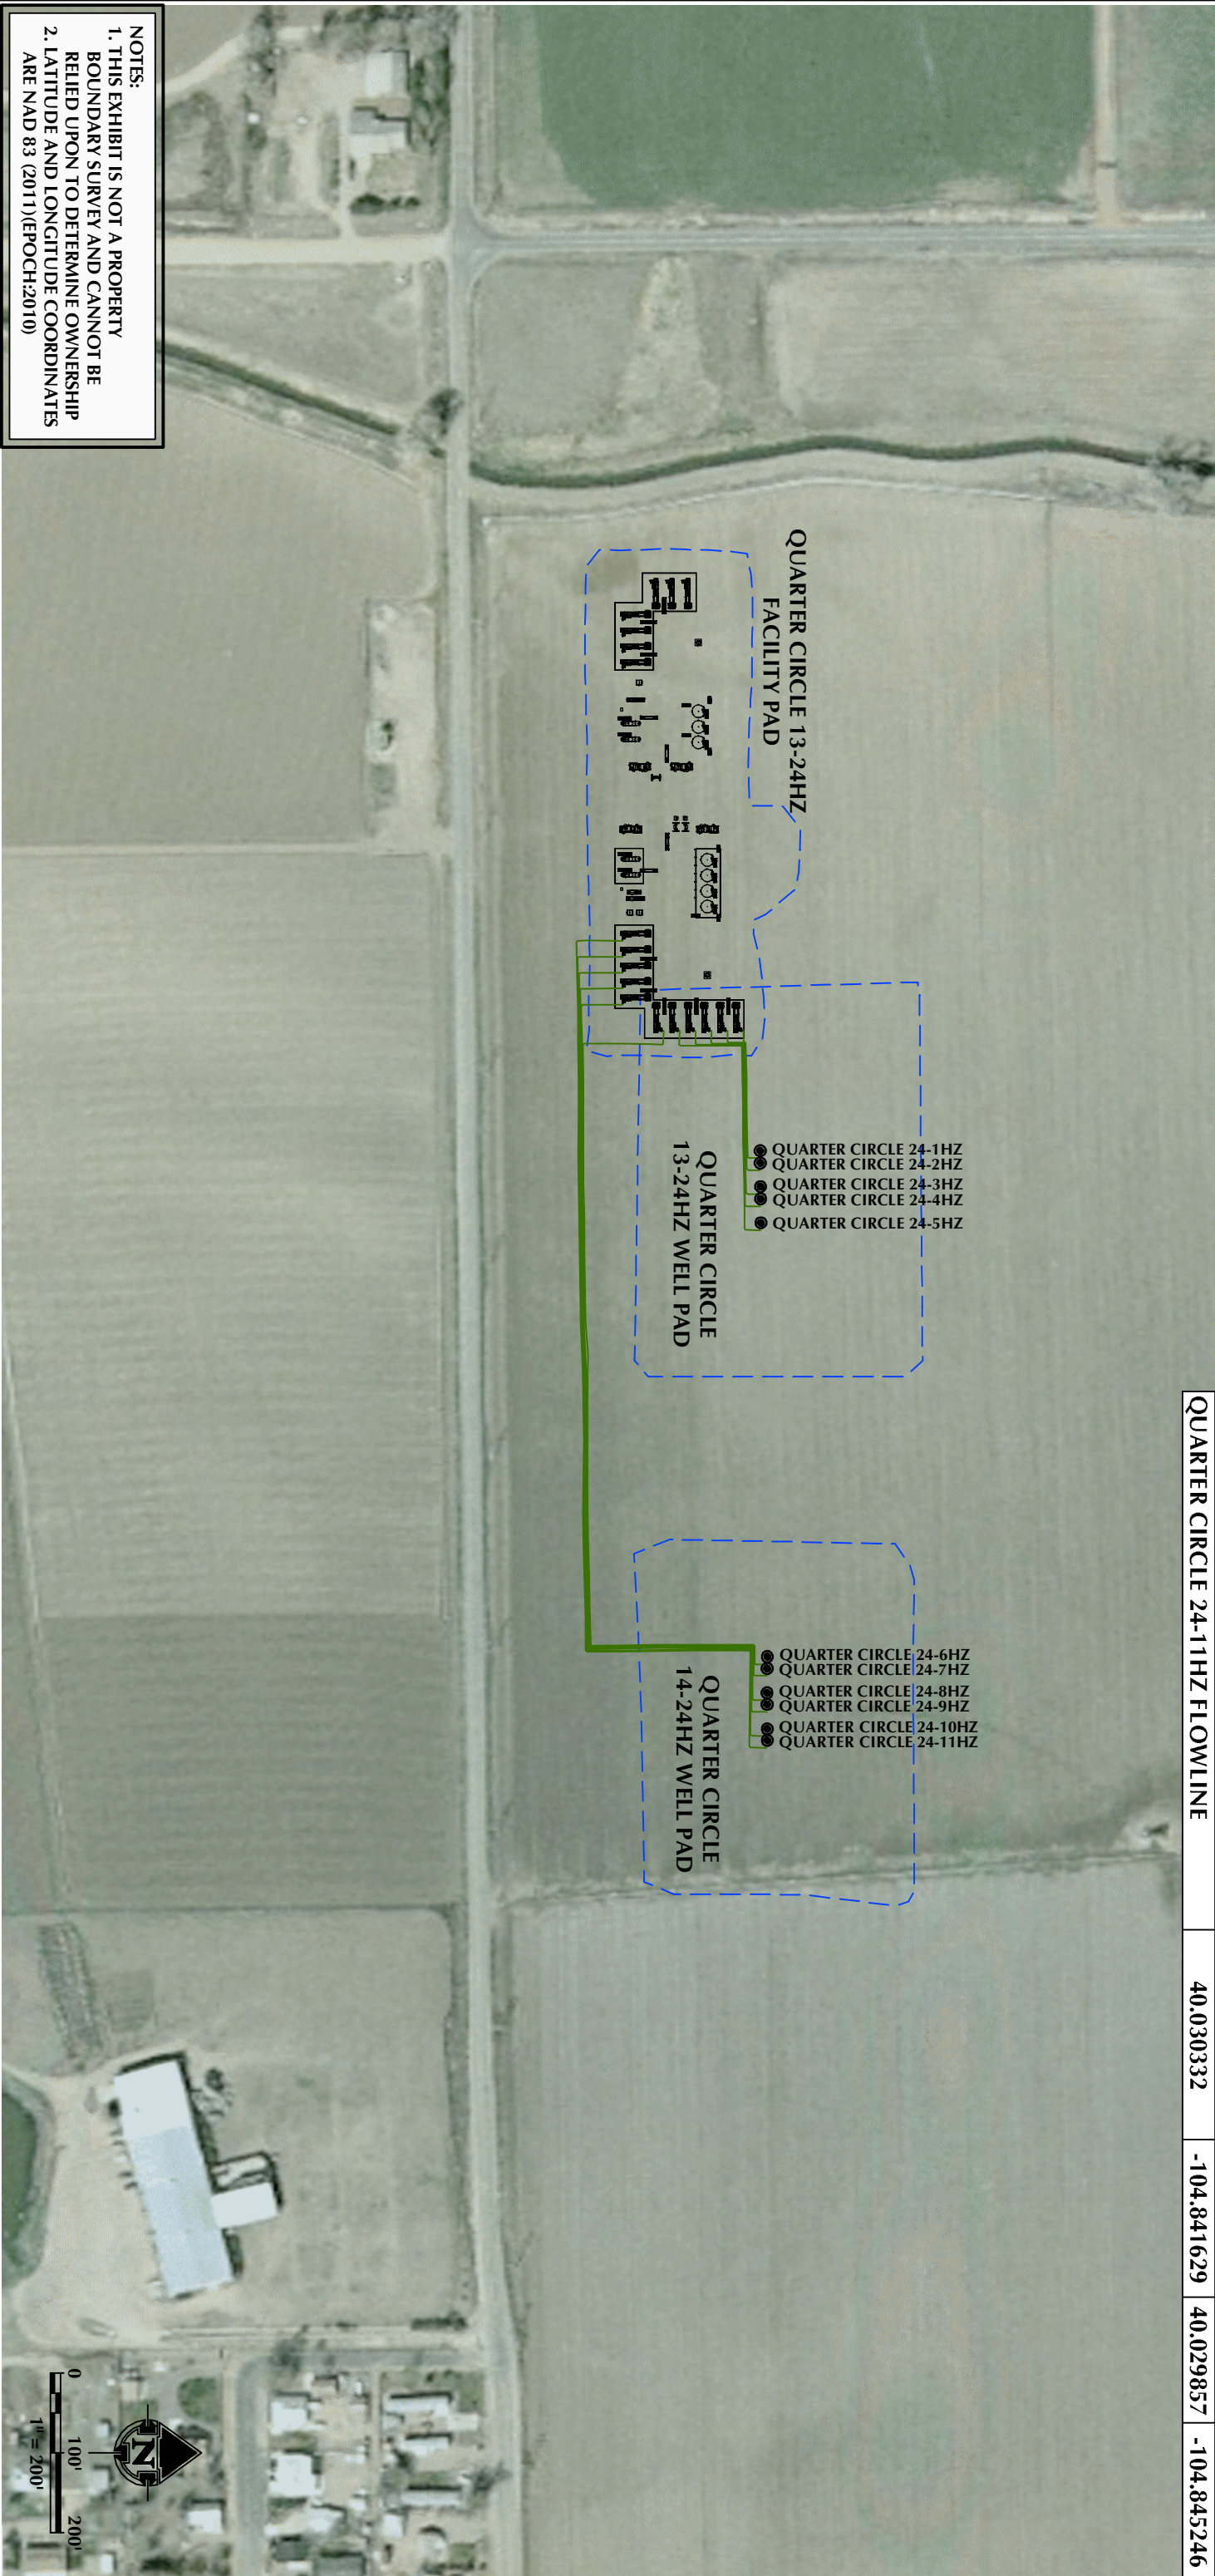

LEGEND:

- AS-BUILT WELL
- AS-BUILT FLOWLINE
- EXISTING PAD

DATA SOURCES:  
-AERIAL COURTESY OF ESRI, INC.

REV.	DATE
A	12/12/18

DESCRIPTION



LOVELAND OFFICE  
6706 North Franklin Avenue  
Suite 350  
Louisville, CO 80238  
Phone: 303.766.4311

SHERIDAN OFFICE  
1095 Saberton Avenue  
Sheridan, Wyoming 82801  
Phone: 307.674.0609



1099 18th Street  
Denver, CO 80202

SCALE:

DATE SURVEYED:

DATE:

DRAFTER:

REVISED:

1" = 200'

3/5/18

12/12/18

SCB

QUARTER CIRCLE 13-24HZ &  
QUARTER CIRCLE 14-24HZ  
FLOWLINE ROUTE

LOCATED IN SECTION 24  
T1N, R67W, 6TH P.M.  
WEED COUNTY, COLORADO

